




Deed plot of the Daniel Harper Estate as recorded in the office of the Recorder of Deeds of the County of Fayette, Pennsylvania in Deed Book Vol. 1039, Page 779 and Deed Book Vol. 1093, Page 273.

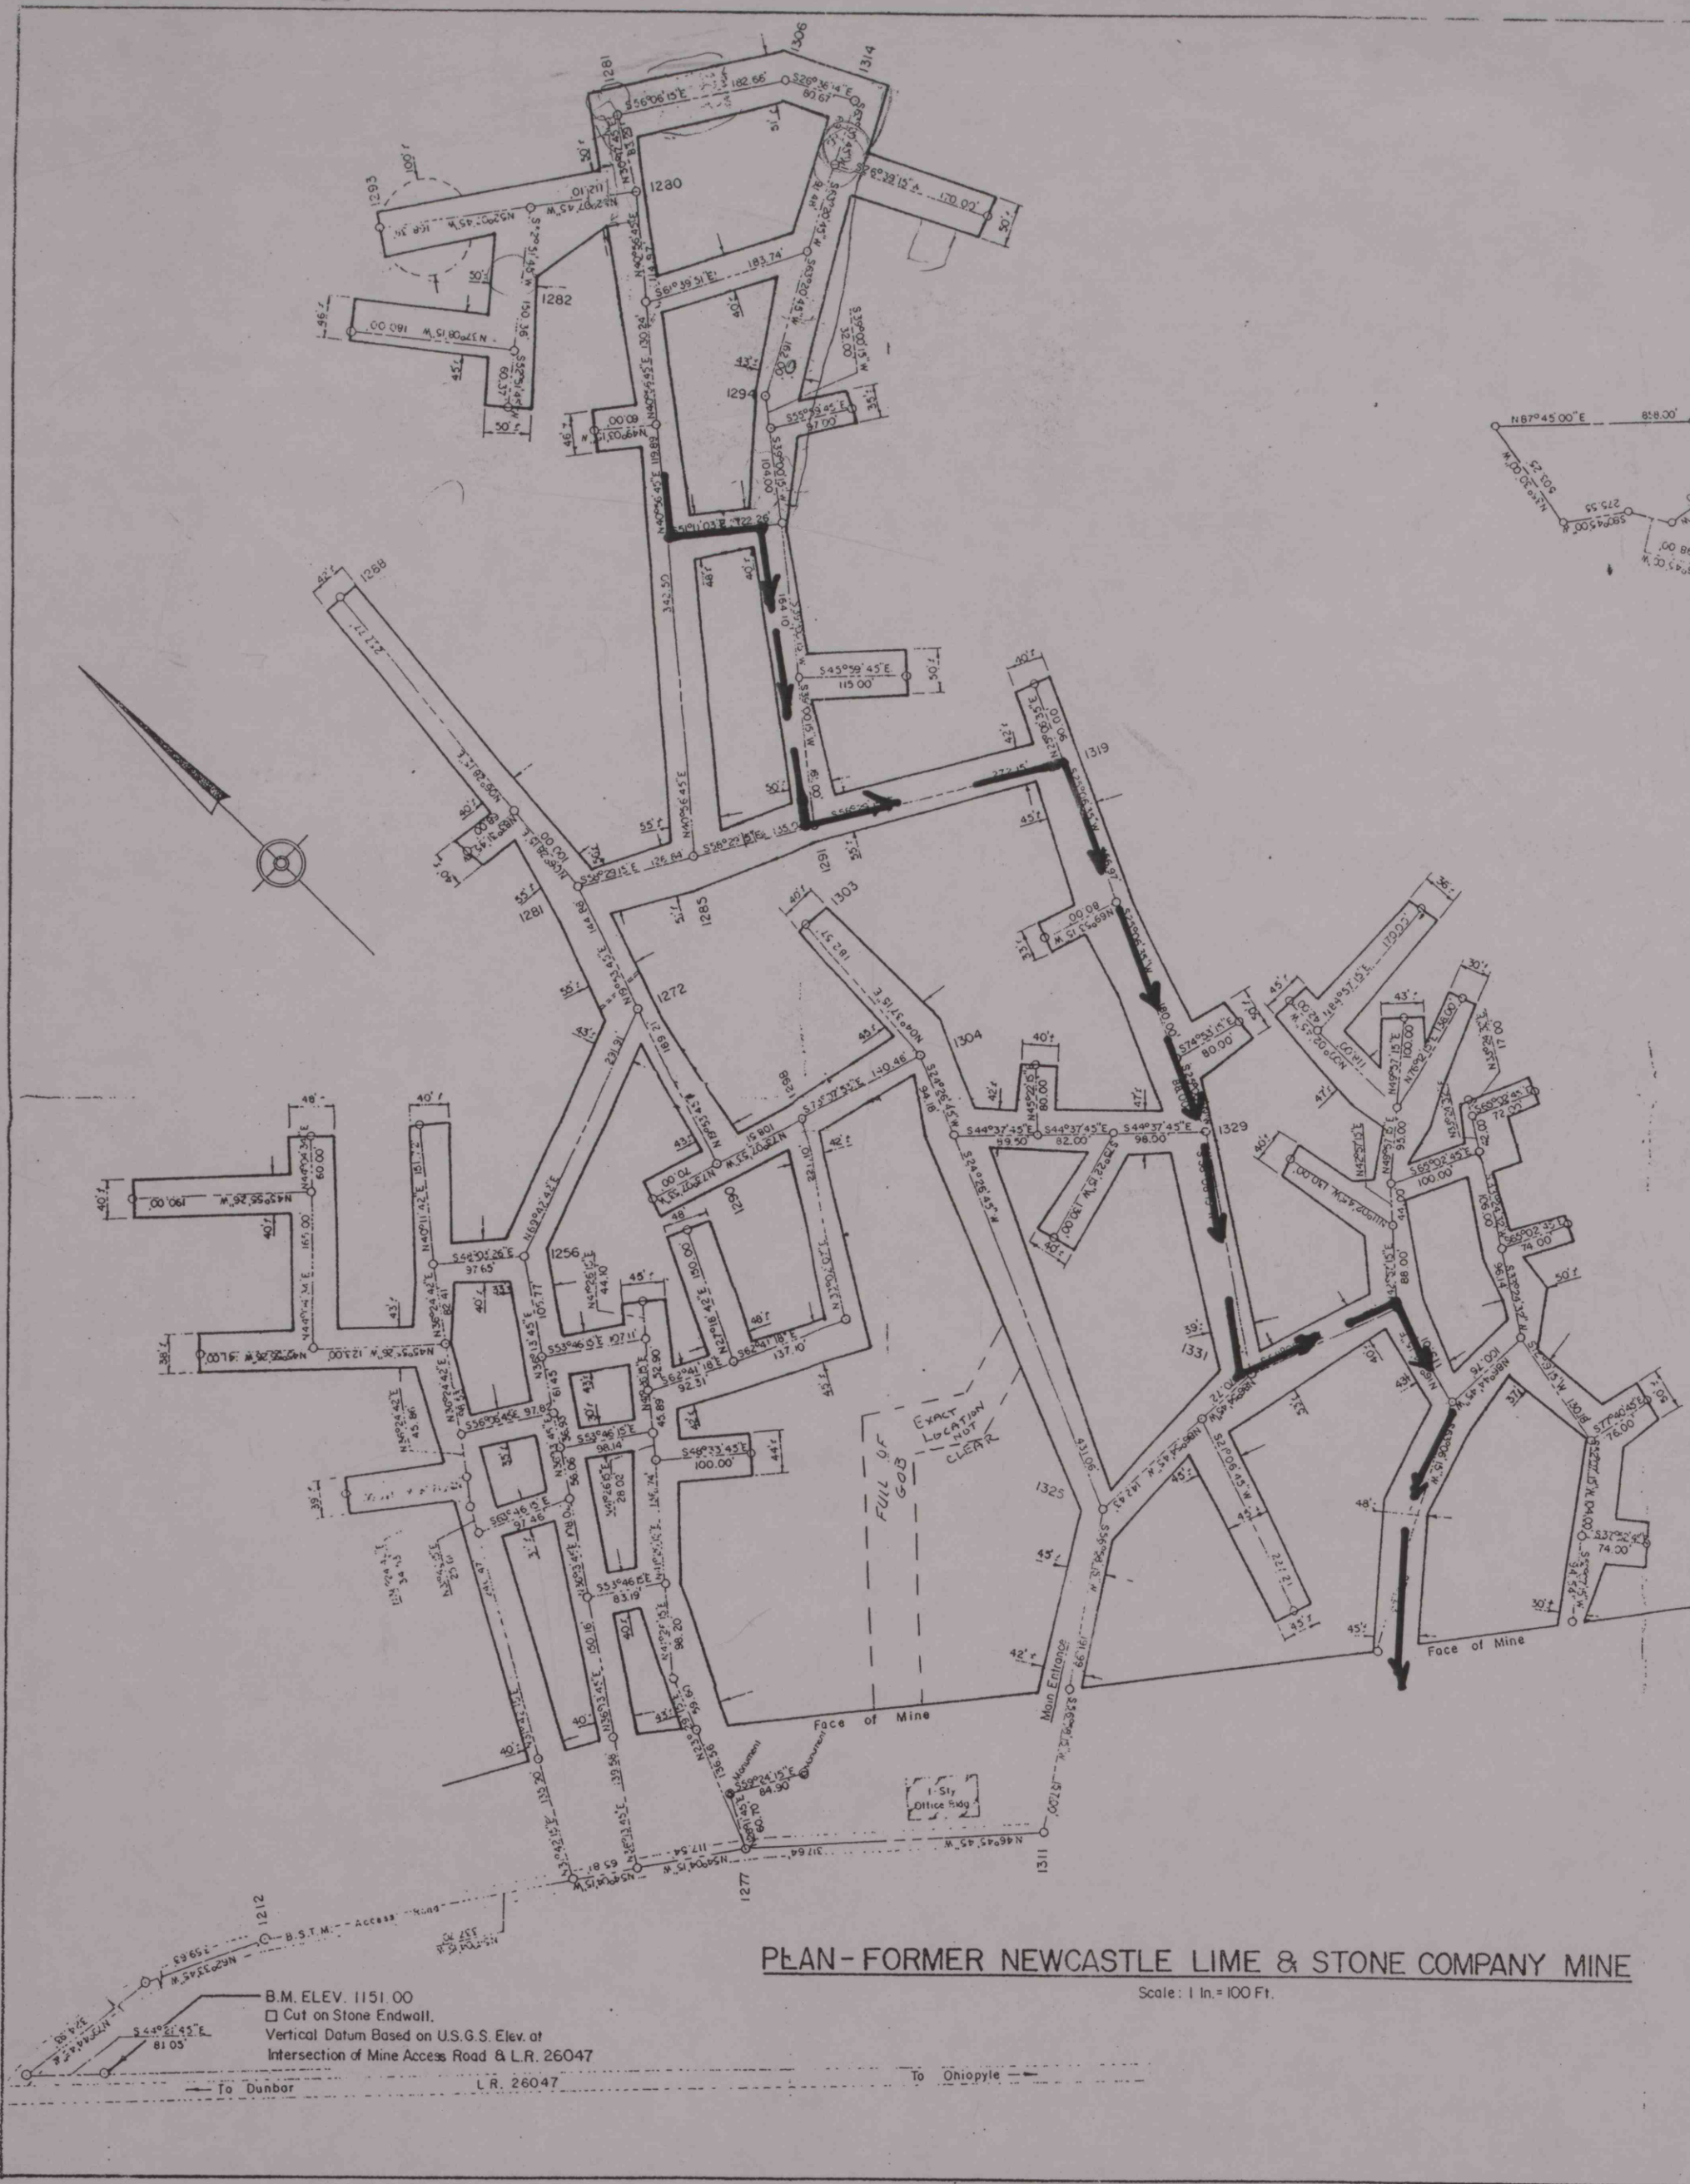

NOTE: Presently, there are no mine workings being performed by the E.I. DuPont deNemours & Co., Inc. Previously, the Newcastle Lime & Stone Company mined limestone from the workings.

MINE SURVEY
OF THE FORMER
NEWCASTLE LIME & STONE COMPANY MINE
SITUATE
DUNBAR TOWNSHIP
FAYETTE COUNTY, PENNSYLVANIA
LEASED BY
E.I. DuPONT deNEMOURS & CO., INC.
SCALE AS NOTED
SEPTEMBER, 1979

PREPARED BY
SUCCEVIC ENGINEERING COMPANY
HOPWOOD, PA.

E.I. DuPont deNemours & Co., Inc.
Newcastle Lime & Stone
Company Mine
Dunbar Township
Fayette County
Sept. 1979
Scale: 1"=100'

Dynamic Materials Corp