


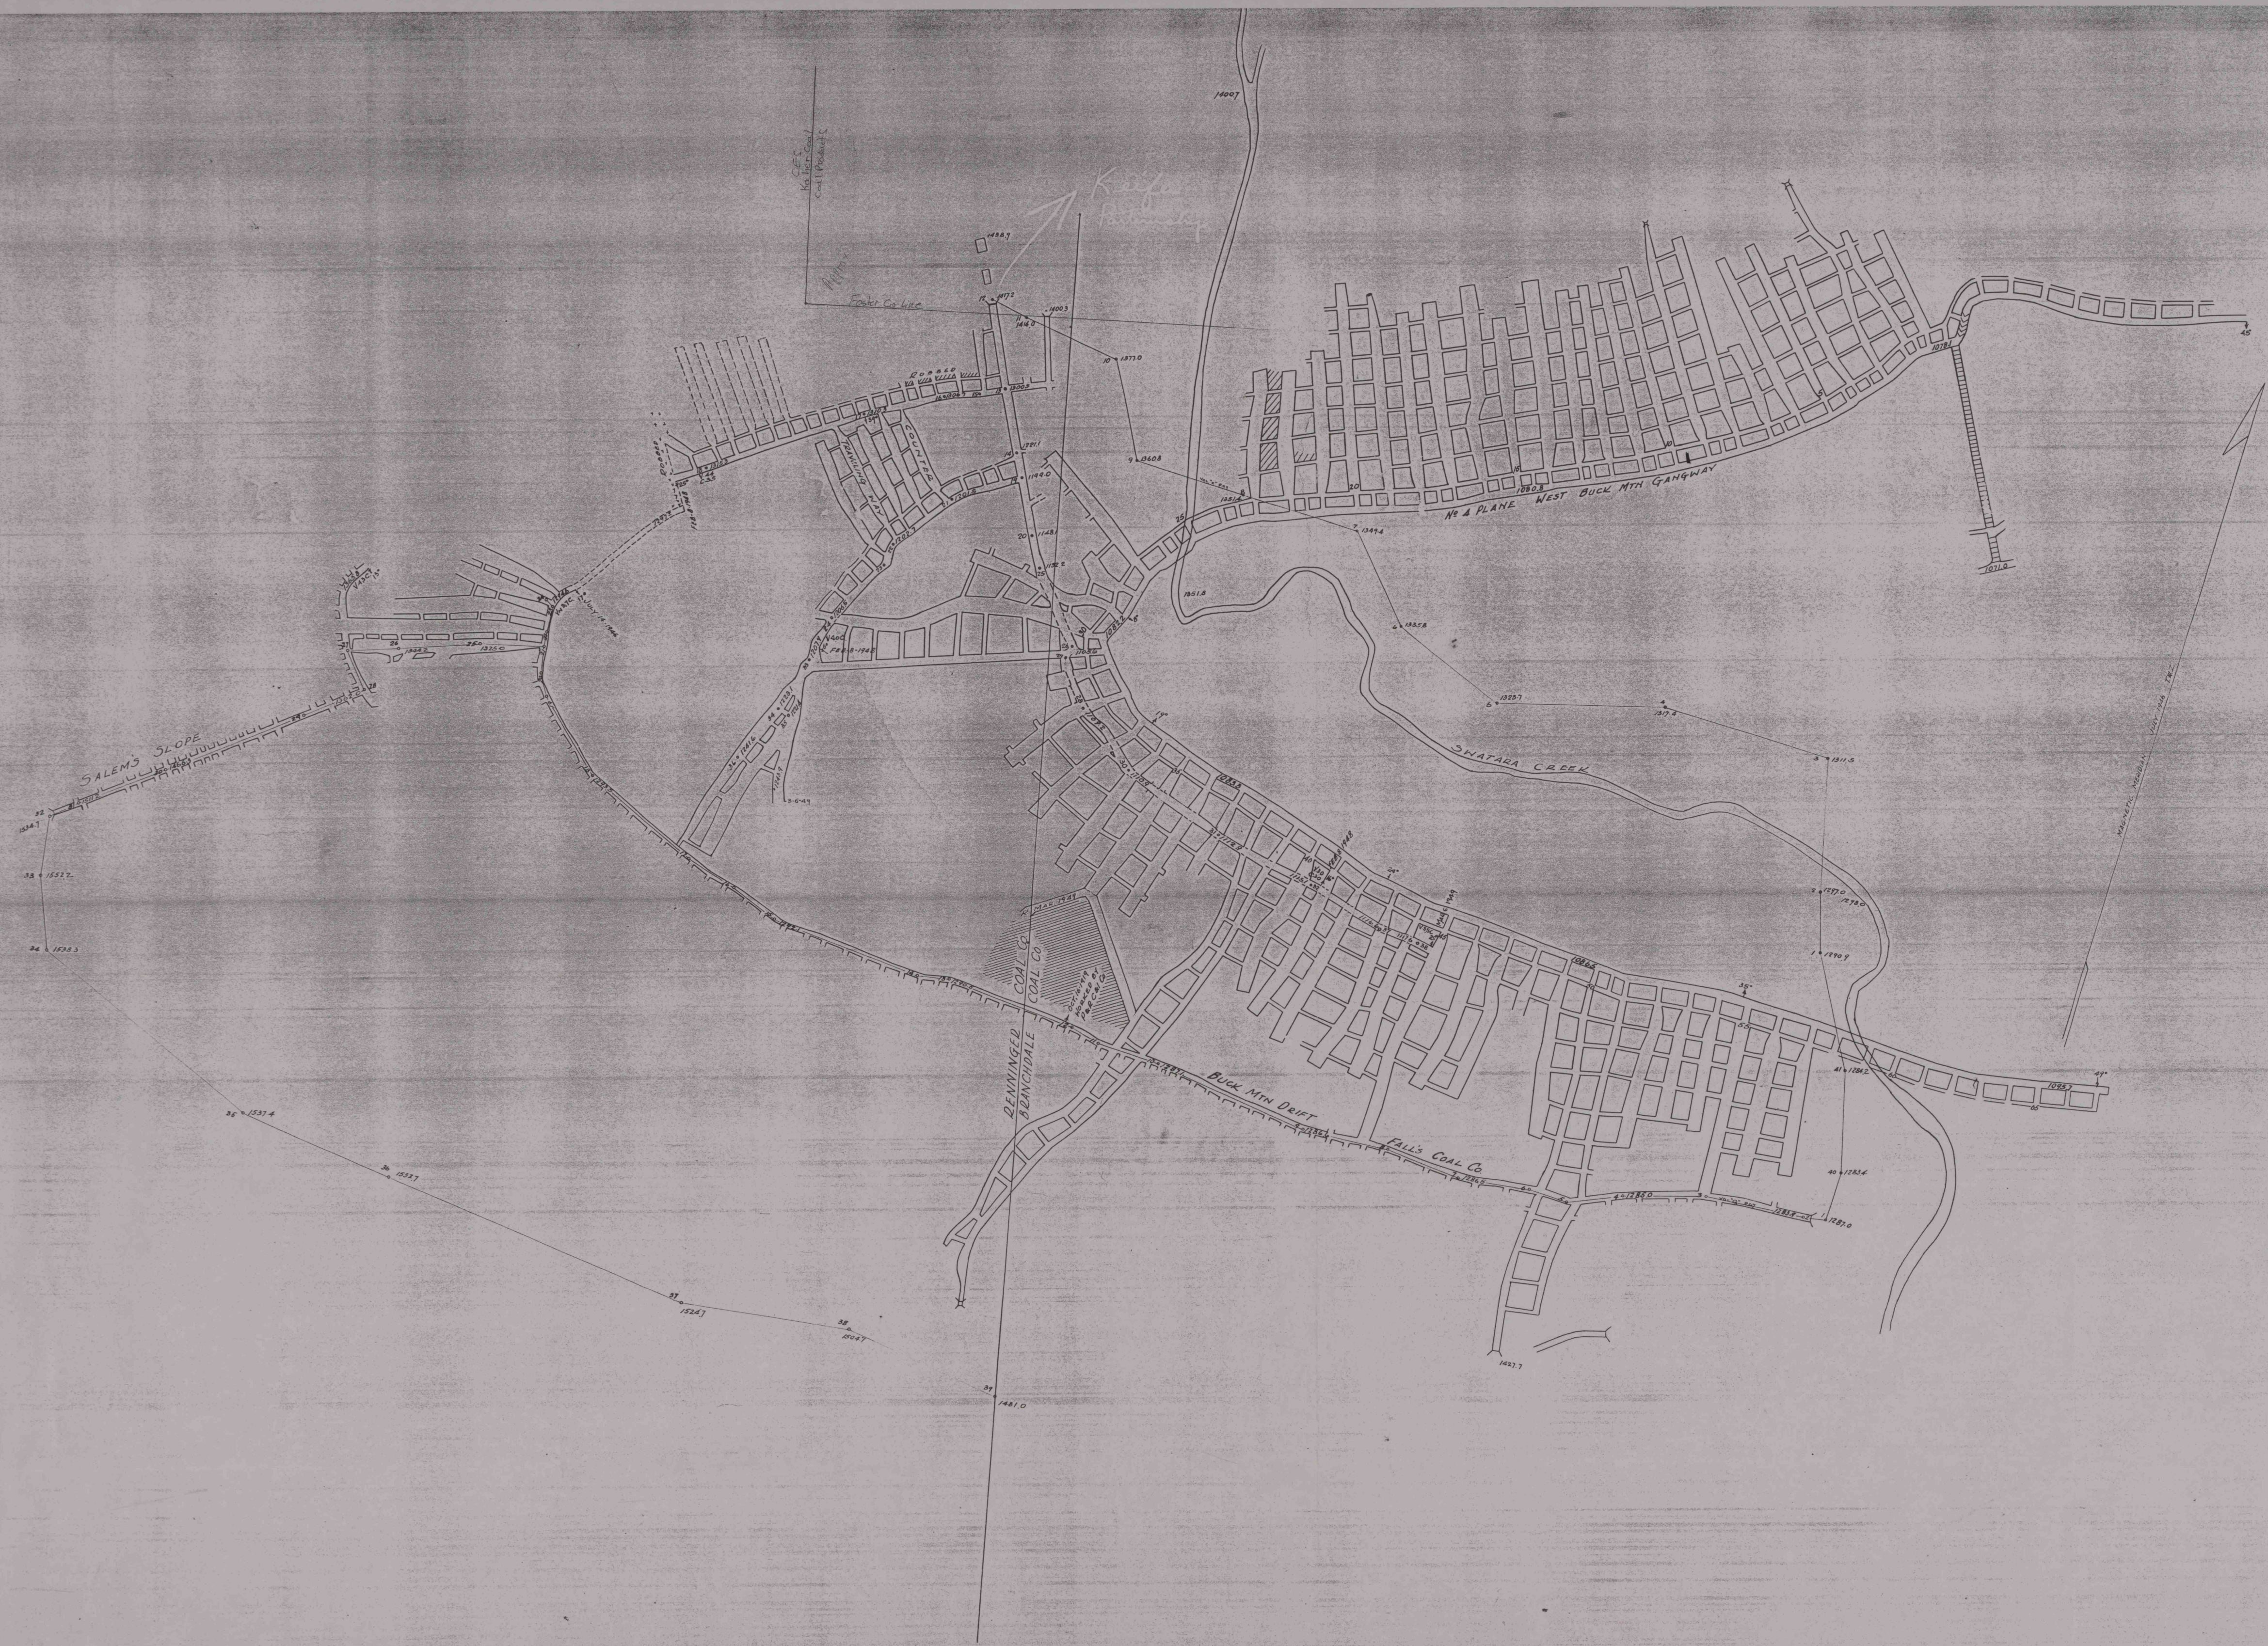

FALL'S COAL COMPANY
BUCK MOUNTAIN VEIN
SOUTHERN ANTHRACITE
FIELD
FOSTER & REILLY TOWNS
SCHUYLKILL COUNTY, PA
SCALE: 1" = 100'