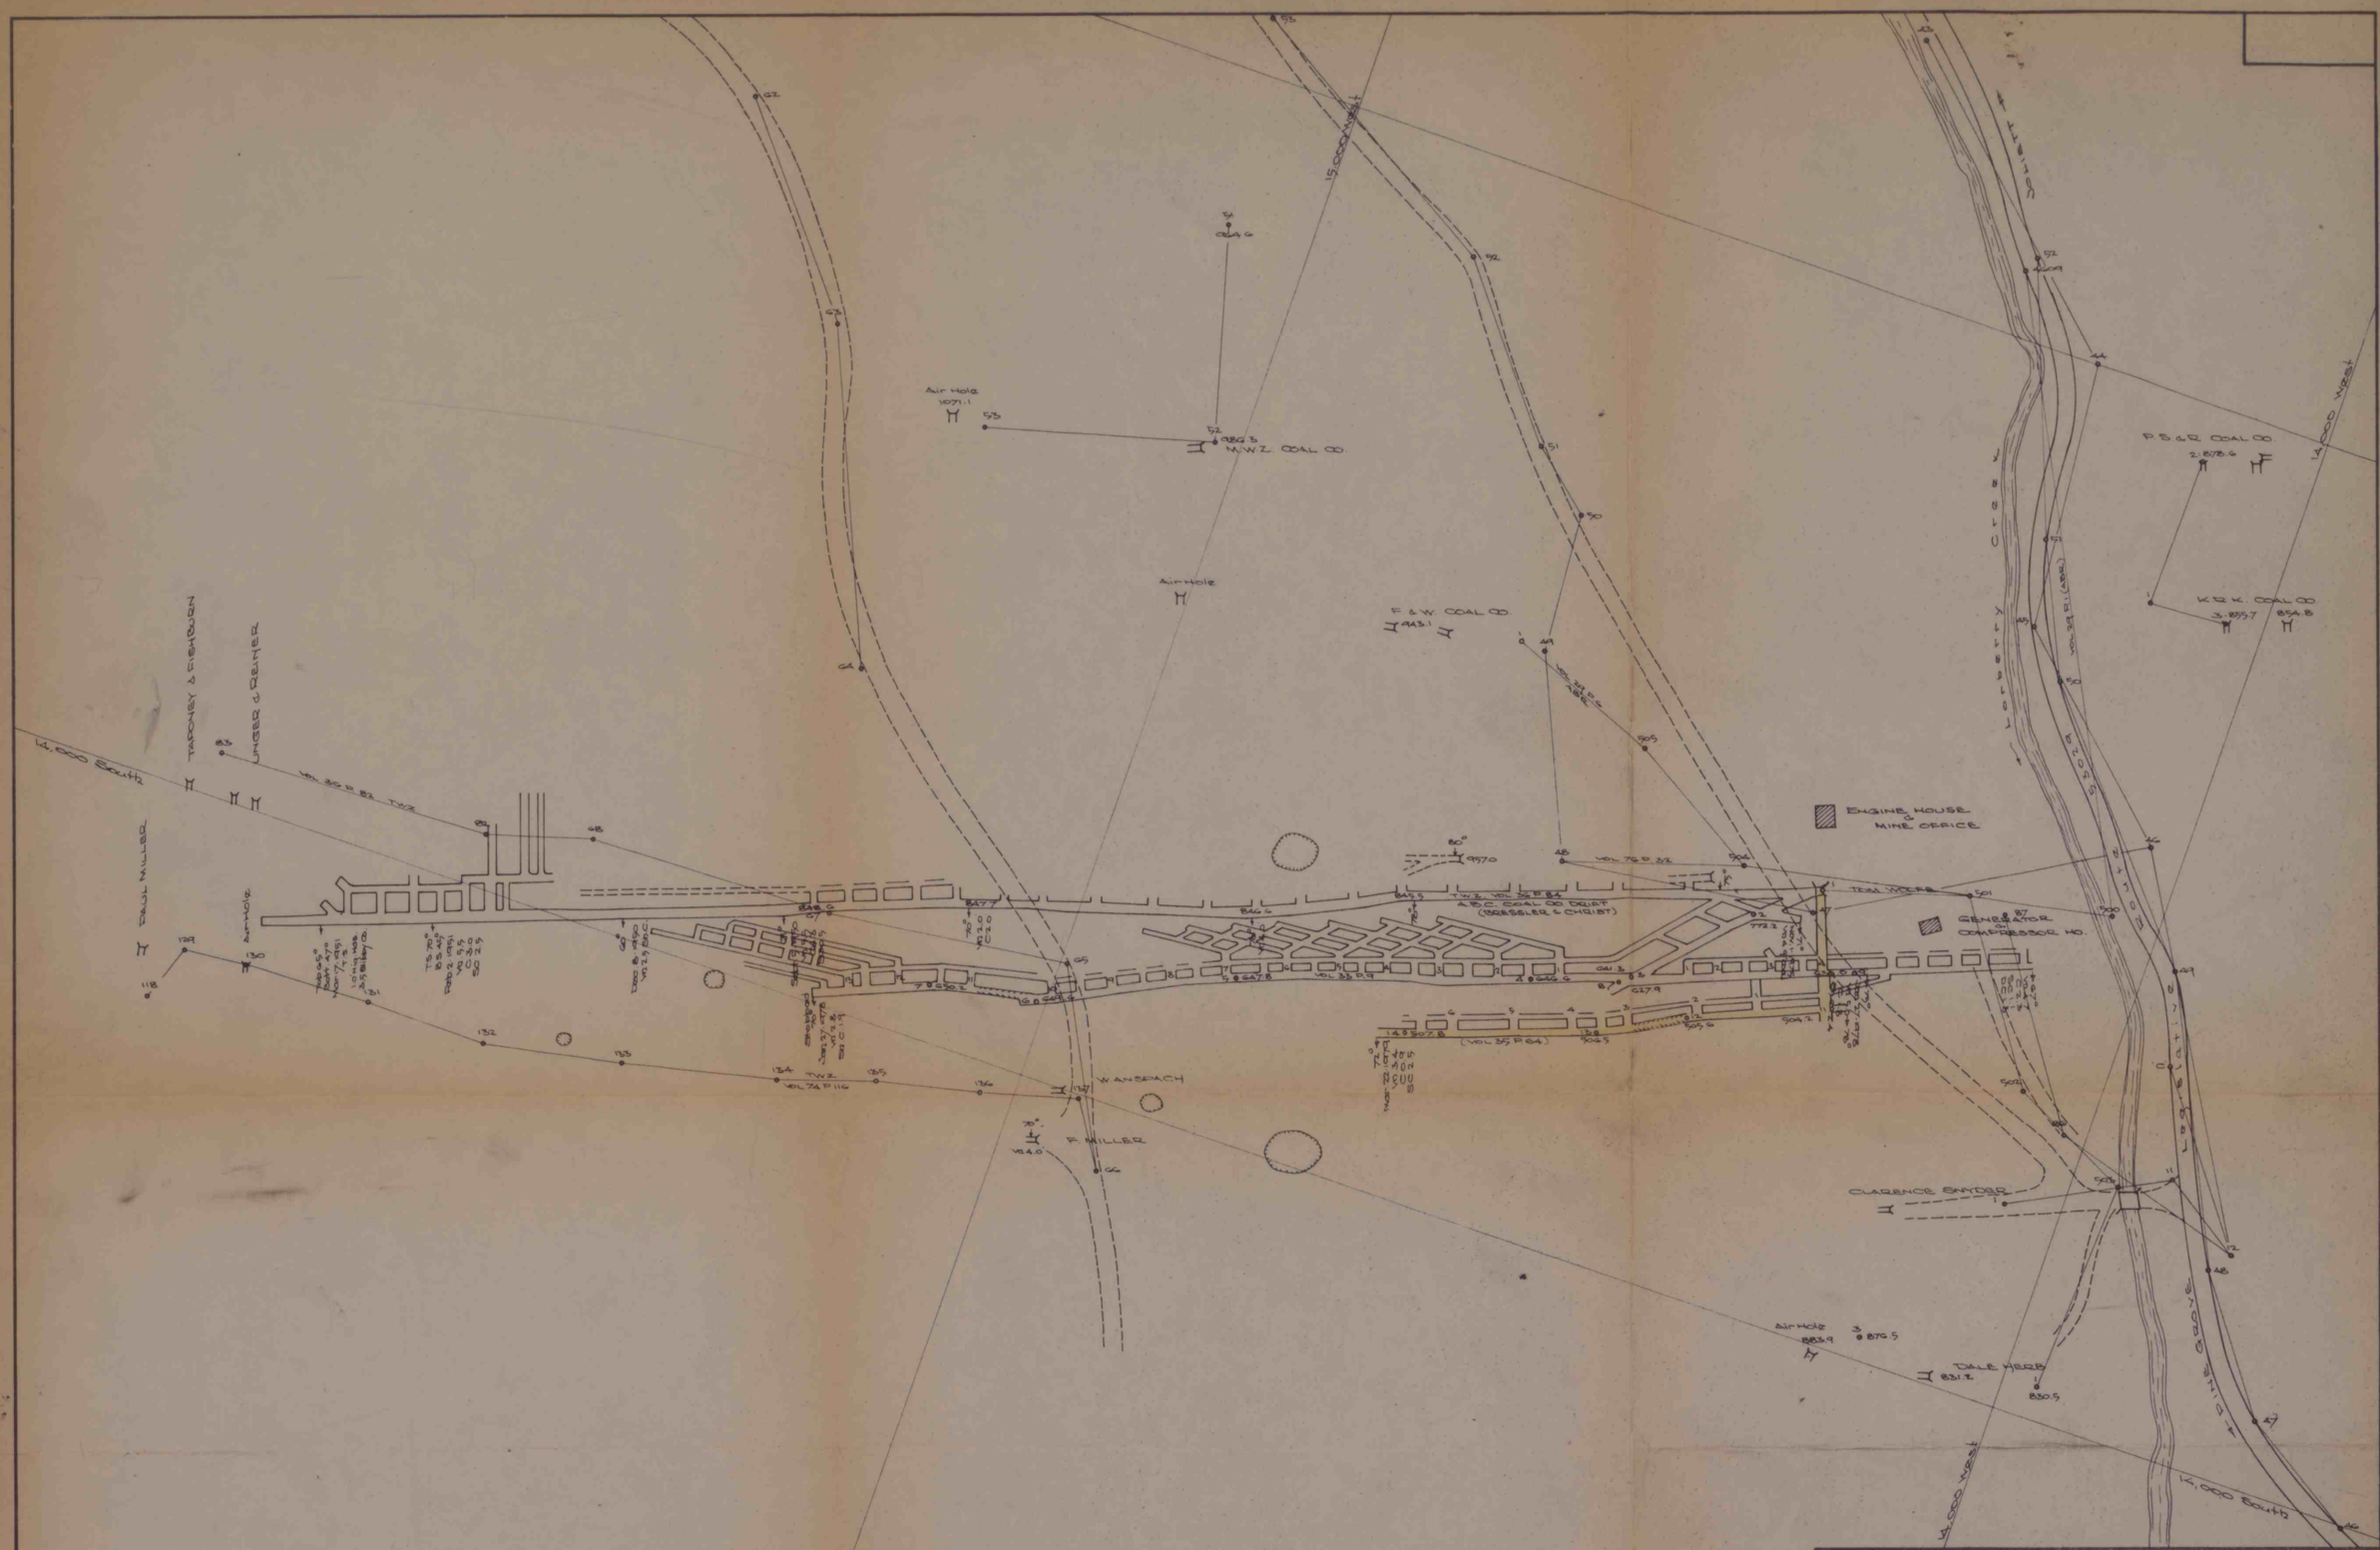

MINE MAP

TOM WOLFE COAL CO. - PANTHER HEAD

TREMONT TOWNSHIP, SCHUYLKILL COUNTY

SCALE: 1" = 100'	APPROVED BY	DRAWN BY
DATE: NOV. 1. 1975	Alfred B. Russel	A. B. RUSSEL
Map Posting :- Nov. 1. 1975, Jun. 2. 1977, Jan. 27. 1978, Mar. 22. 1979		
		DRAWING NUM

DIETZGEN MASTER FORM 198MF