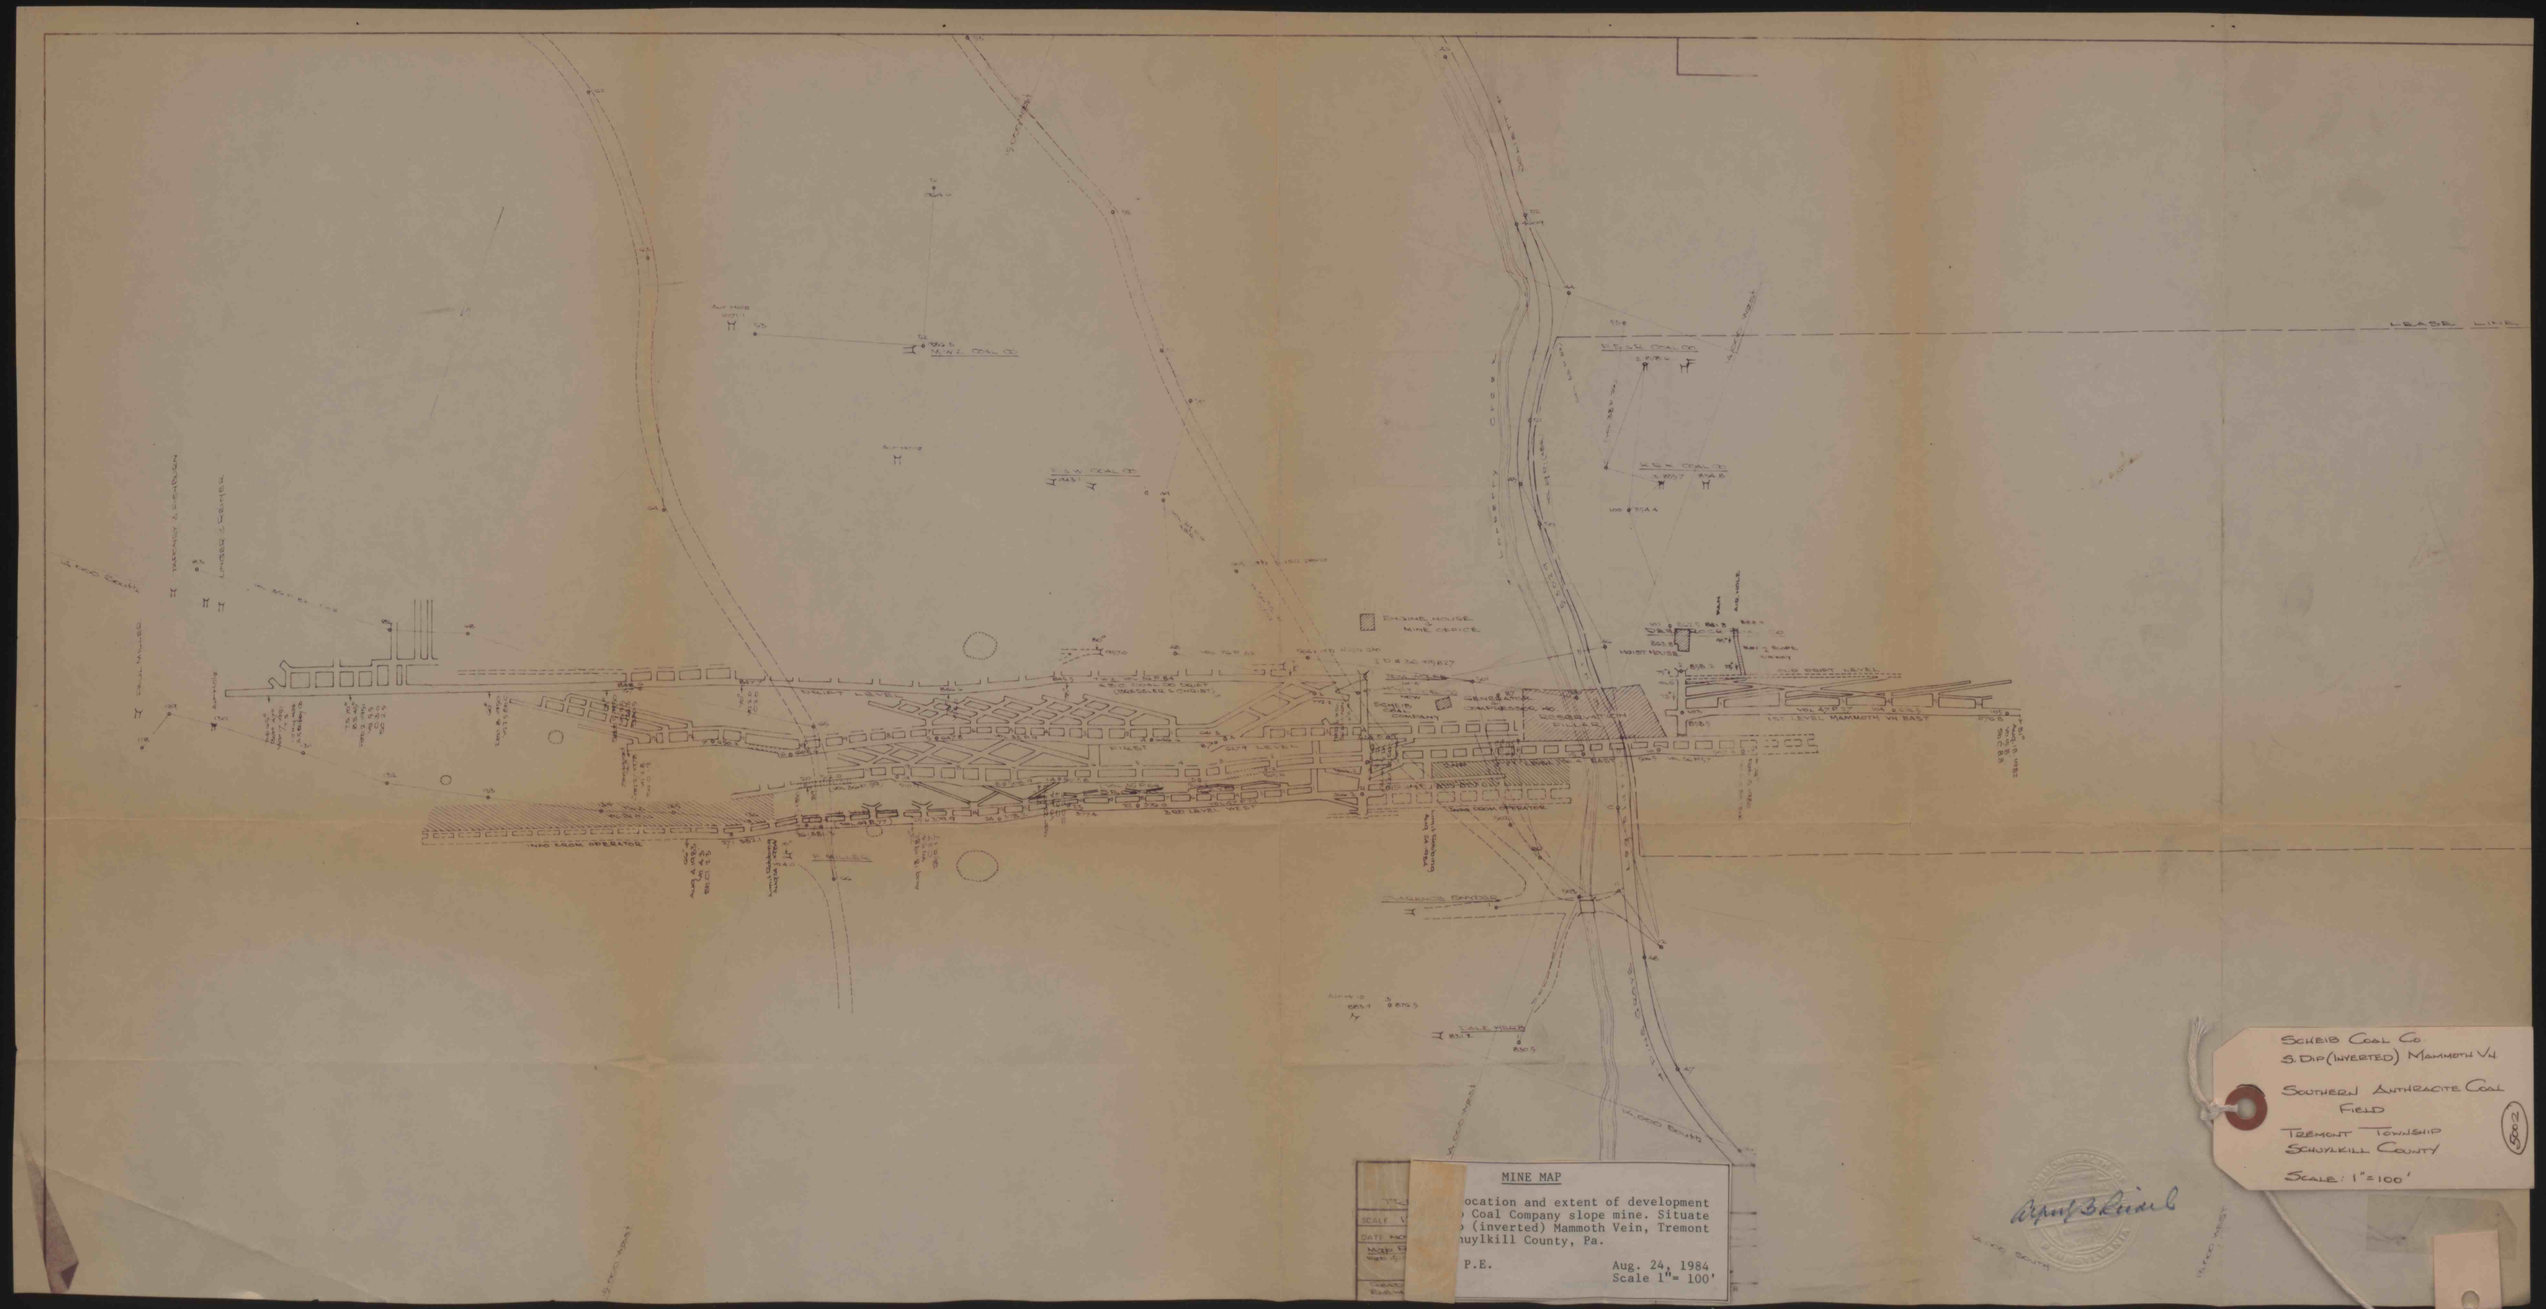
LEASE LINE
ENGINE HOUSE
MINE OFFICE
HOIST HOUSE
1ST LEVEL MAMMOTH VN EAST
INDO LAOK OPERATOR
MINE MAP
ocation and extent of development
Coal Company slope mine. Situate
(inverted) Mammoth Vein, Tremont
uylkill County, Pa.
P.E.
Aug. 24, 1984
Scale 1"= 100'
SCHEIB COAL CO
S. DIP (INVERTED) MAMMOTH VN
SOUTHERN ANTHRACITE COAL
FIELD
TREMONT TOWNSHIP
SCHUYLKILL COUNTY
SCALE: 1"=100'
(302)