


No. 1 Drill hole..48°..Southwest of Bottom
40° from face..Lost bit at 9'

No. 2 Drill hole..Started at face 2-ft., South of Center-line.
Pitching West at 45° 1' off level hole through
at 8' hit void then solid.

Porter Tunnel, Porter twp., Schuylkill County, Penna.,

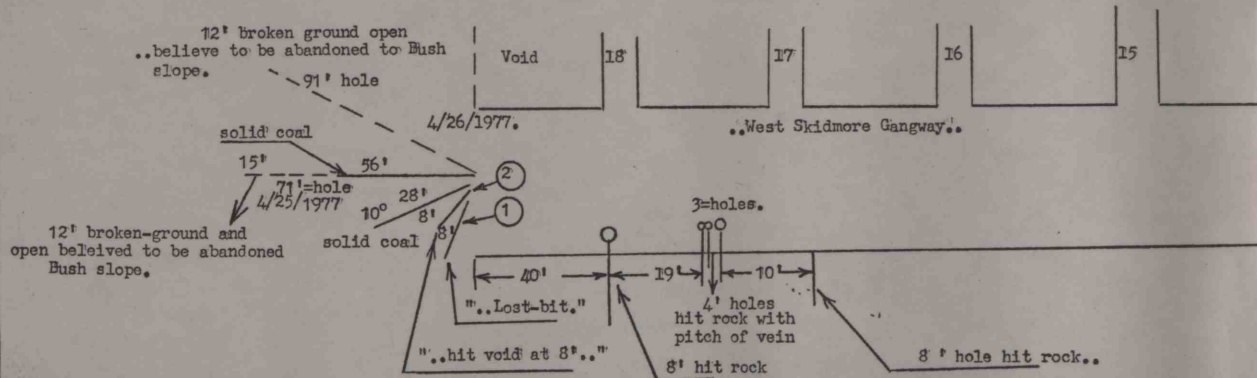

Kocher Coal Co.
Porter Tunnel

Sketch of Drawing
at Face of Skidmore

Gangway

Schubert Anthracite

Coal Field

Porter Twp. - Schuylkill County

Scale: 1"=1'

5667