


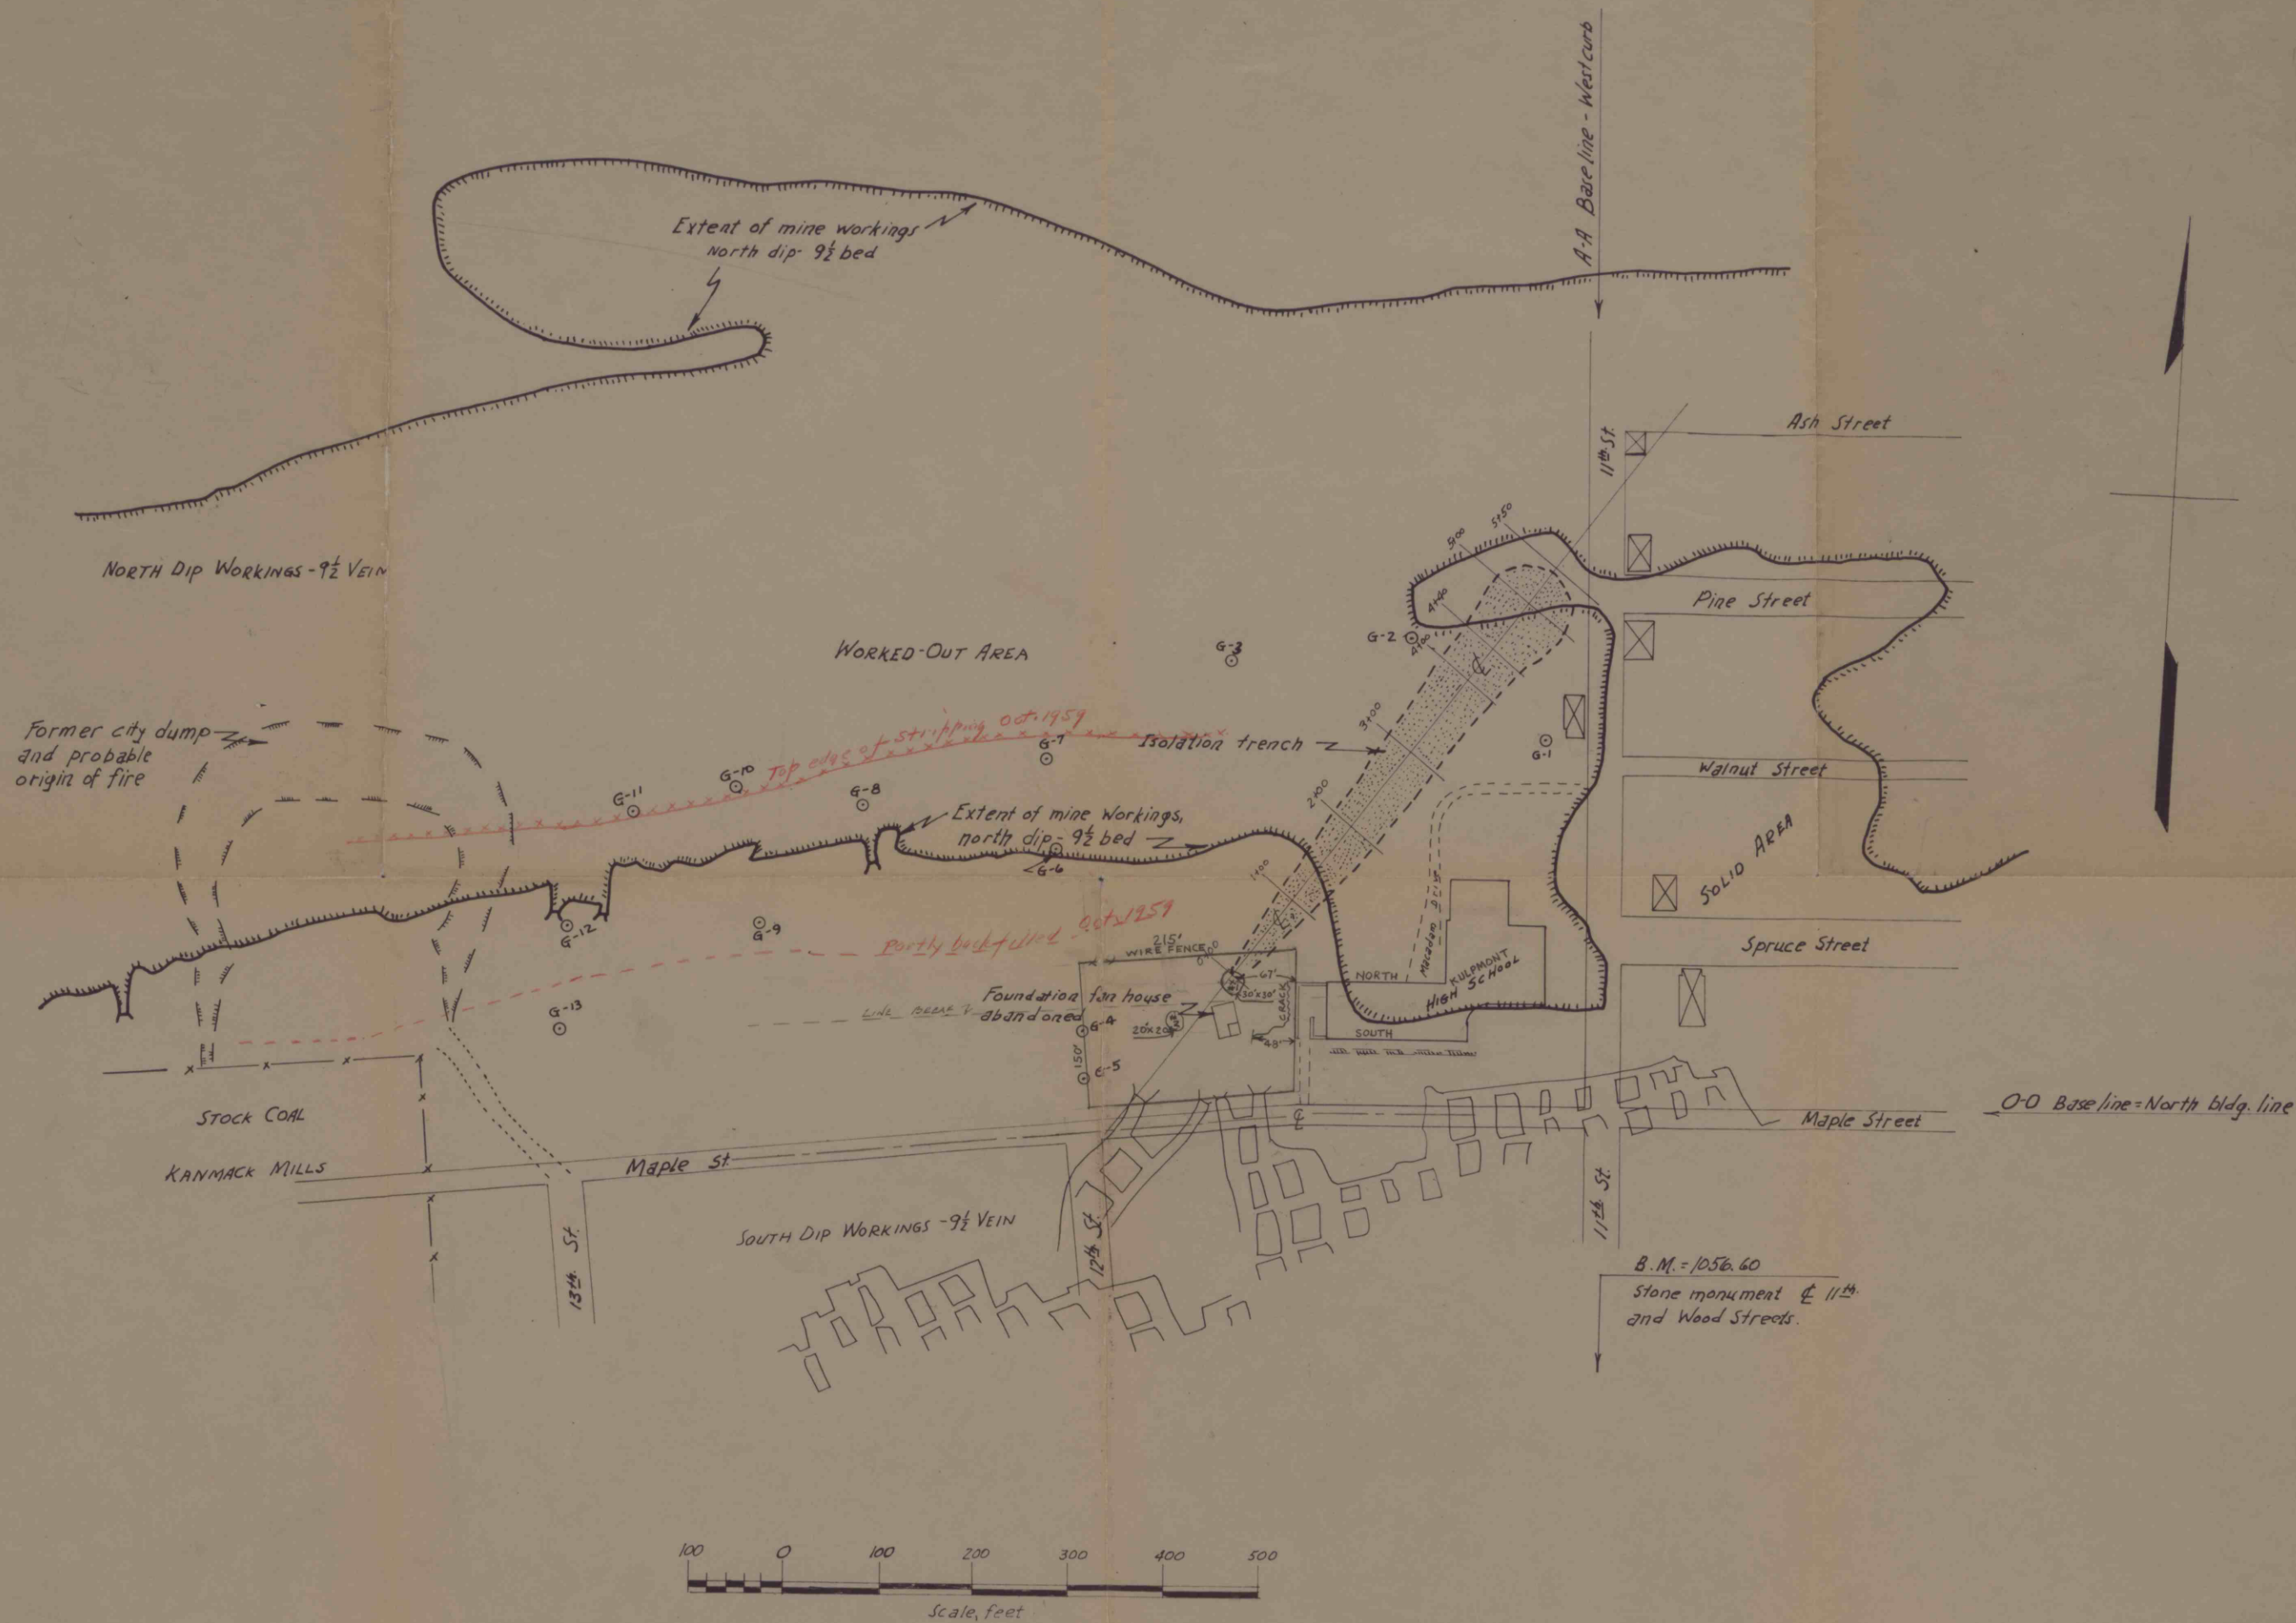

Map of fire area near high school, Kulpmont, Northumberland Co., Penna.

Scale: 1" = 100'

9 1/2 Vein

Easton Middle

Antisaccate Coal Field

Kulpmont Boro.

Northumberland Co.

5061