


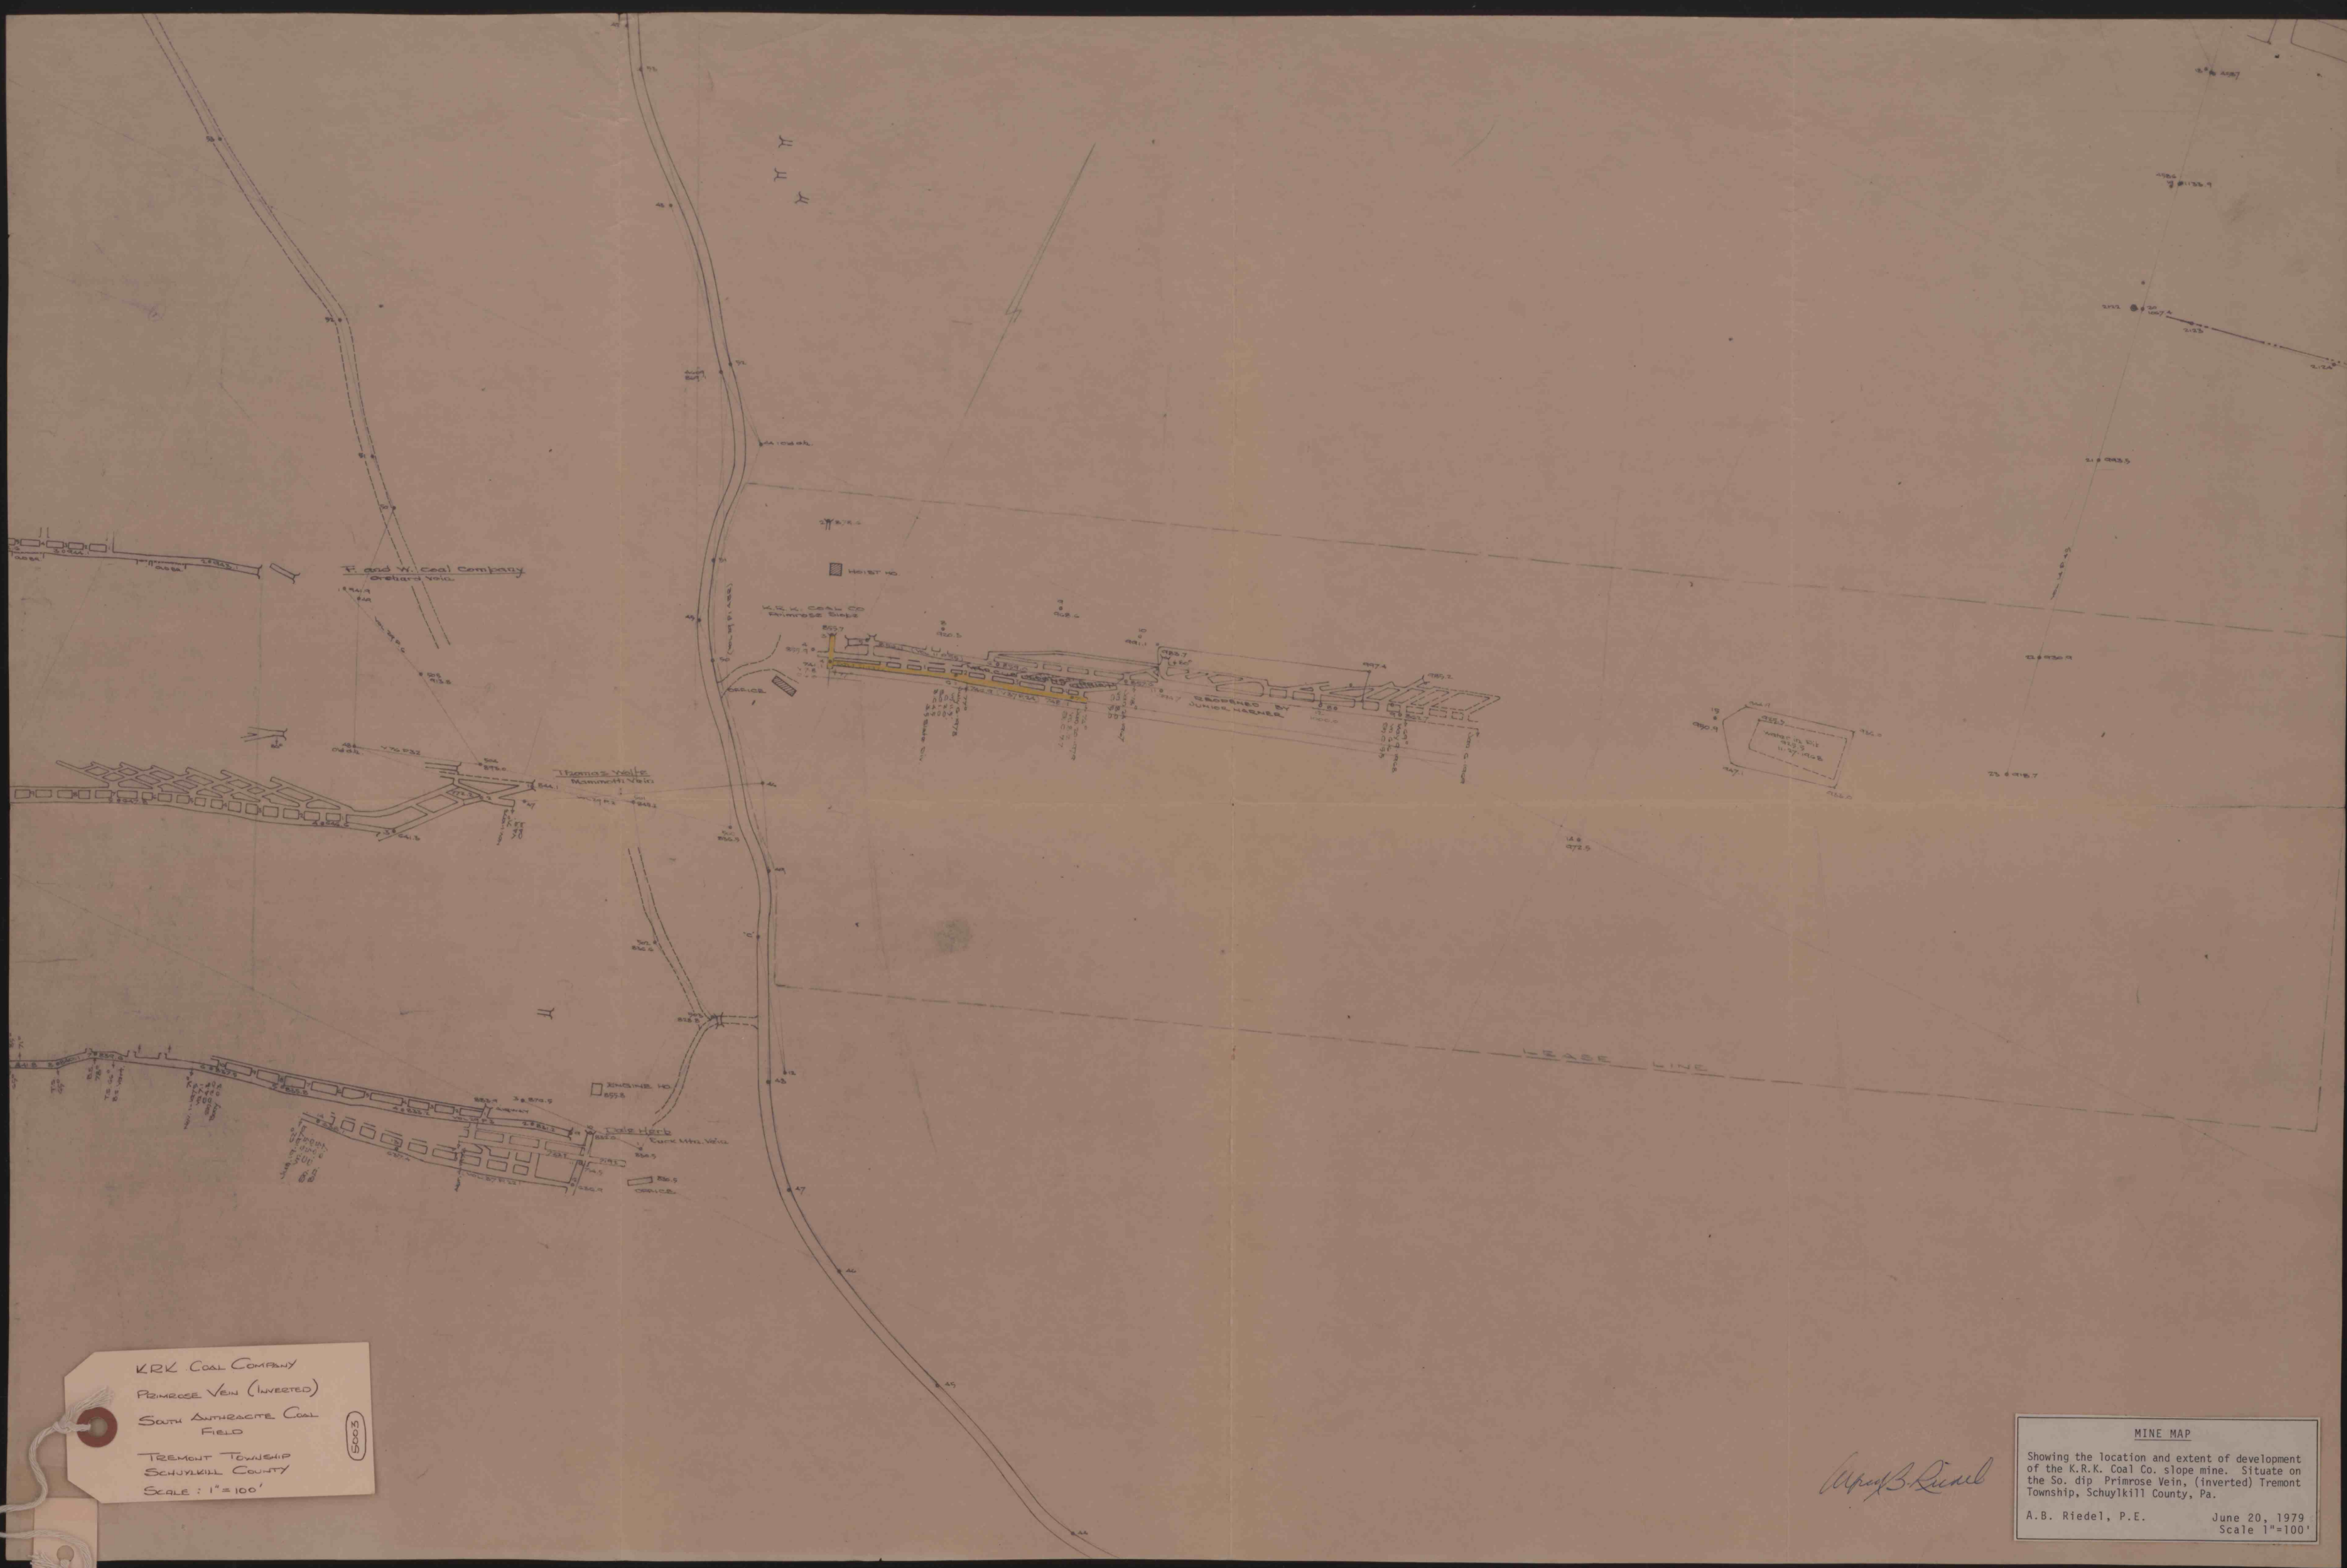

KRK COAL COMPANY
 PRIMROSE VEIN (INVERTED)
 SOUTH ANTHRACITE COAL
 FIELD
 TREMONT TOWNSHIP
 SCHUYLKILL COUNTY
 SCALE: 1"=100'

5003

A.B. Riedel

MINE MAP
 Showing the location and extent of development
 of the K.R.K. Coal Co. slope mine. Situate on
 the So. dip Primrose Vein, (inverted) Tremont
 Township, Schuylkill County, Pa.
 A.B. Riedel, P.E. June 20, 1979
 Scale 1"=100'