


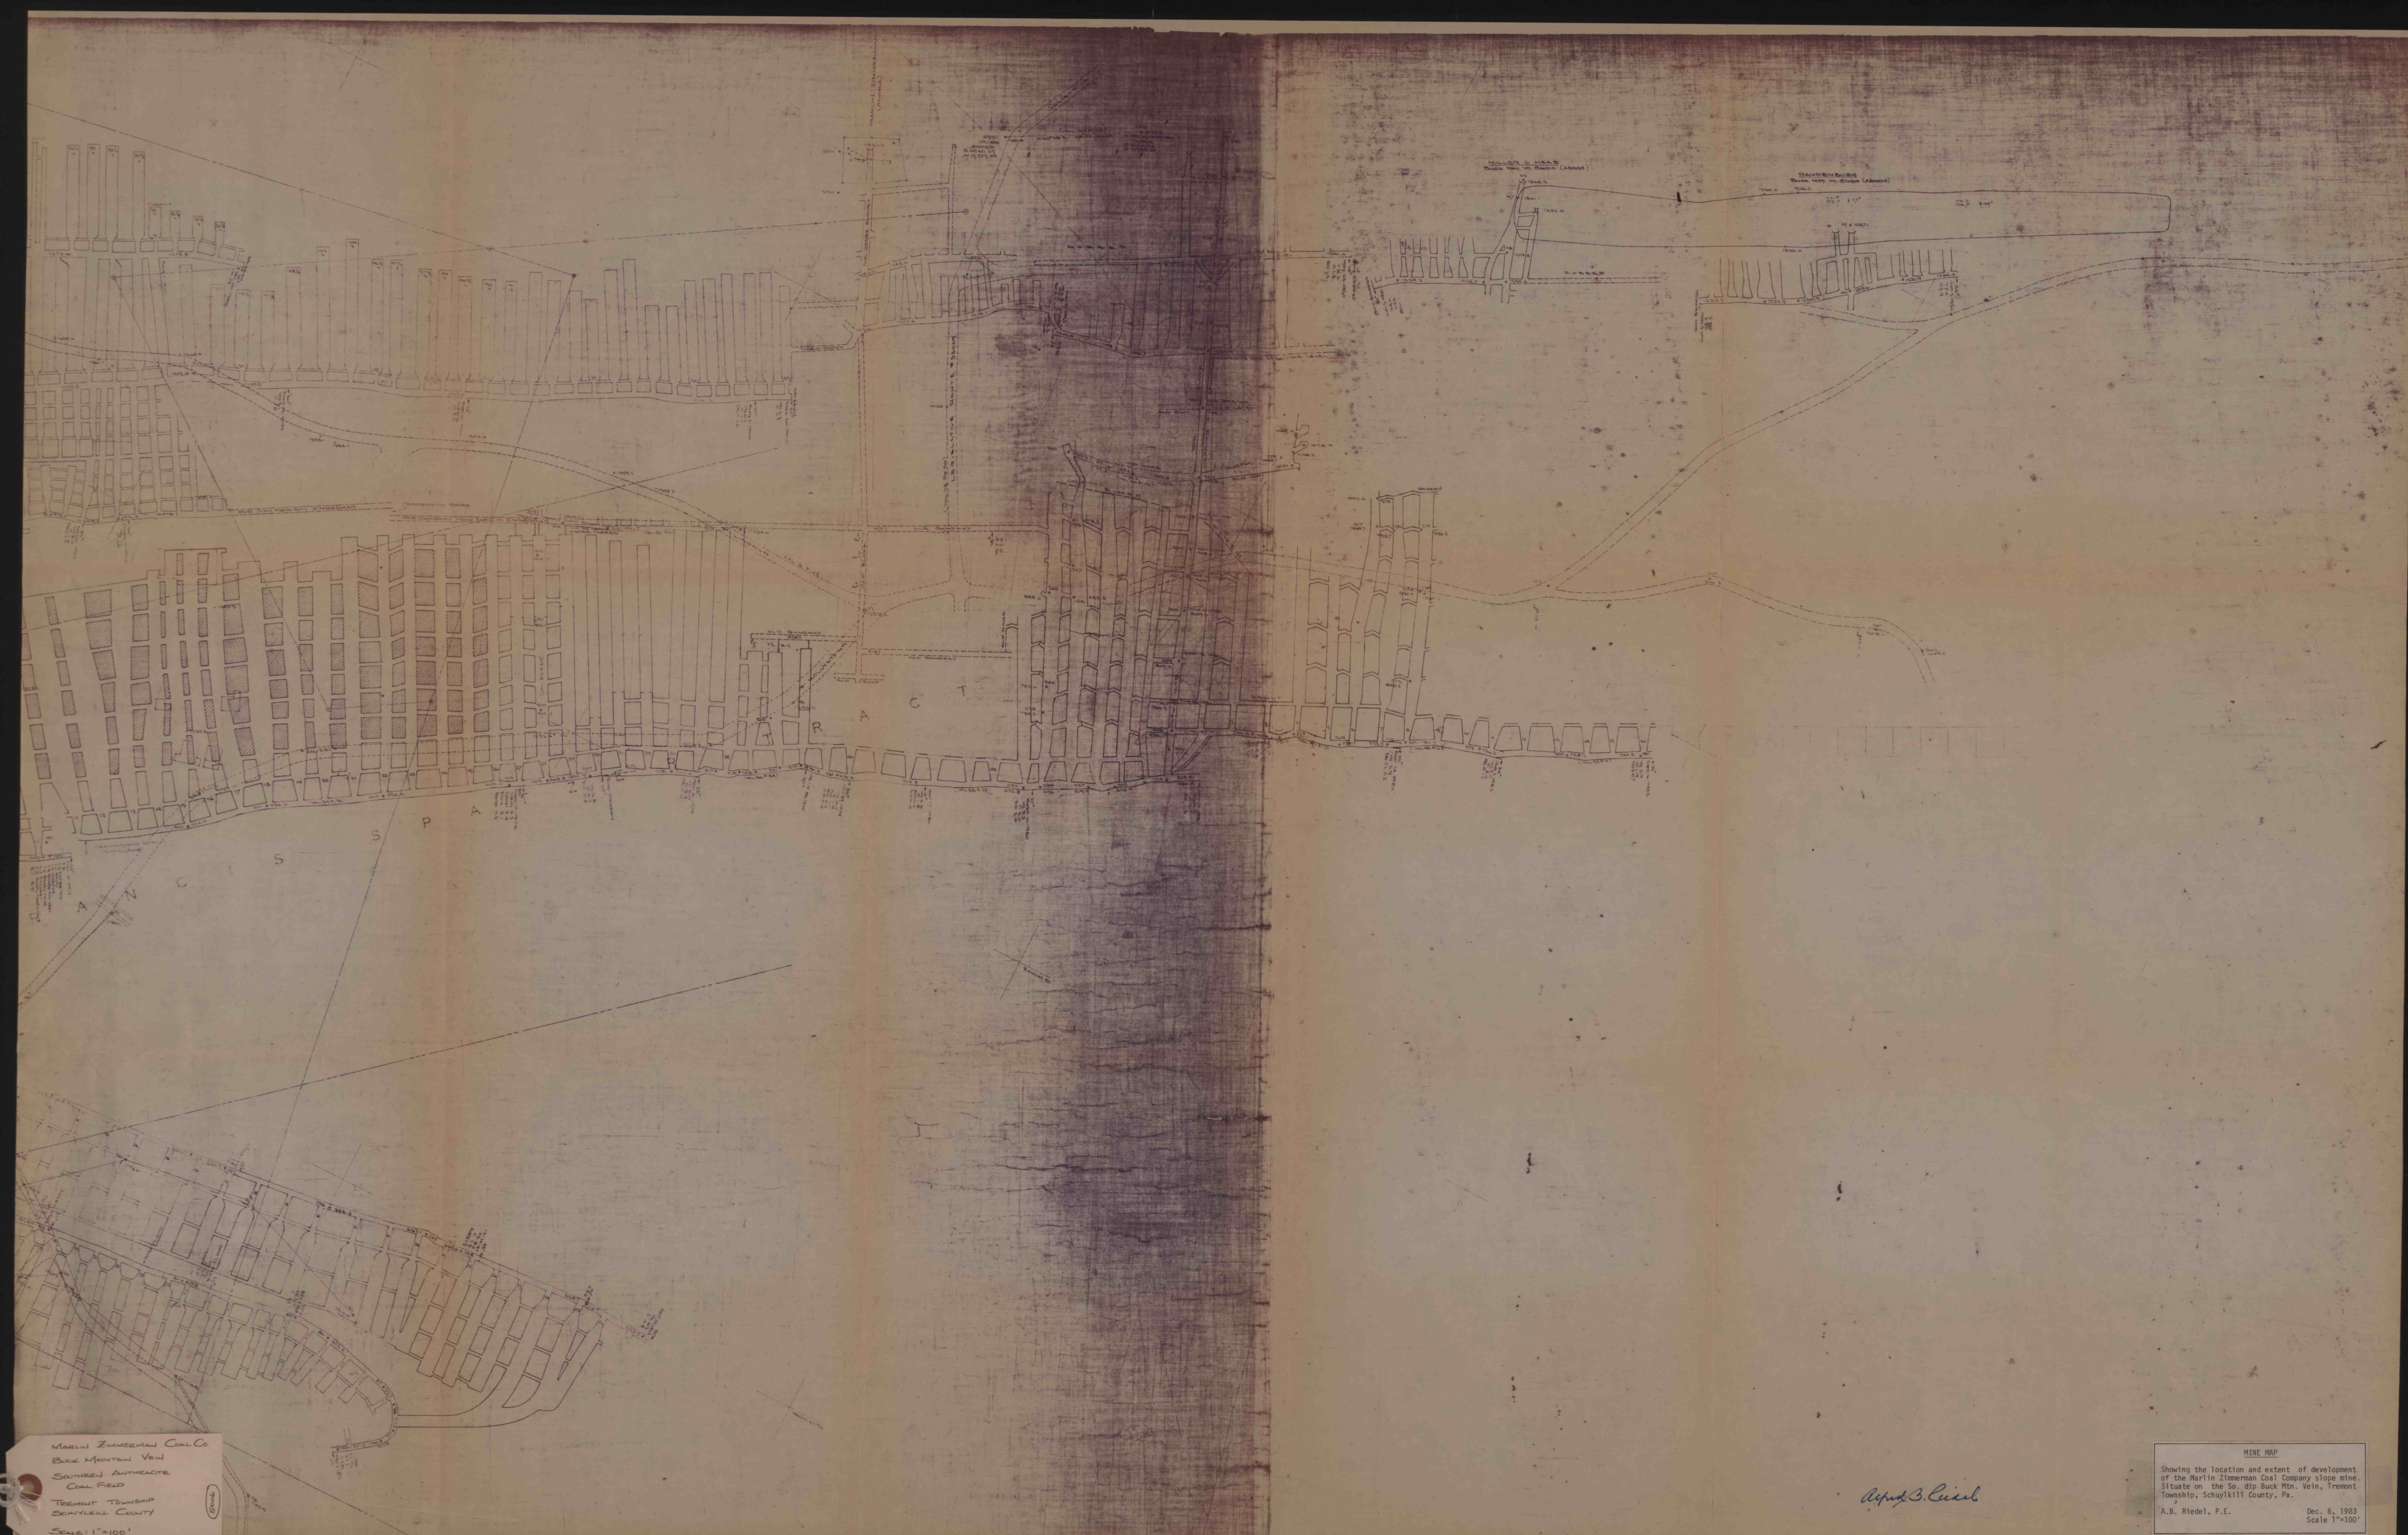

MARLIN ZIMMERMAN COAL CO
BUCK MOUNTAIN VEIN
SOUTHERN ANTHRACITE
COAL FIELD
TREMONT TOWNSHIP
SCHUYLKILL COUNTY
SCALE: 1"=100'

Appt 3. 1913

MINE MAP
Showing the location and extent of development
of the Marlin Zimmerman Coal Company slope mine.
Situate on the So. dip Buck Mtn. Vein, Tremont
Township, Schuylkill County, Pa.
A.B. Riedel, P.E. Dec. 6, 1913
Scale 1"=100'