



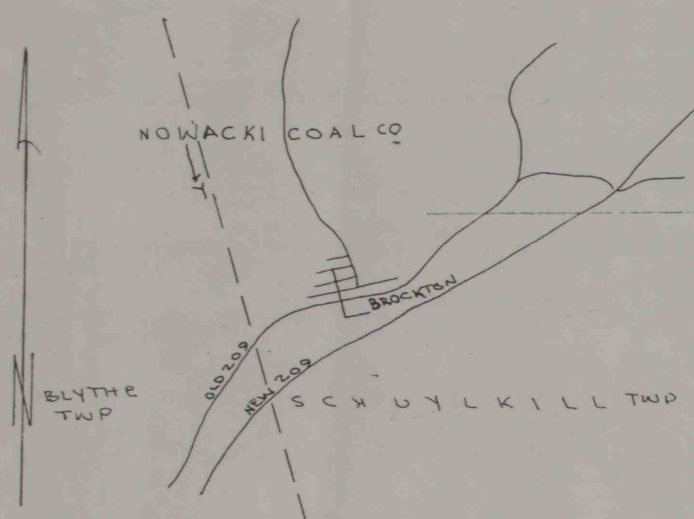


LOCATION MAP
SCALE 1"=2000'

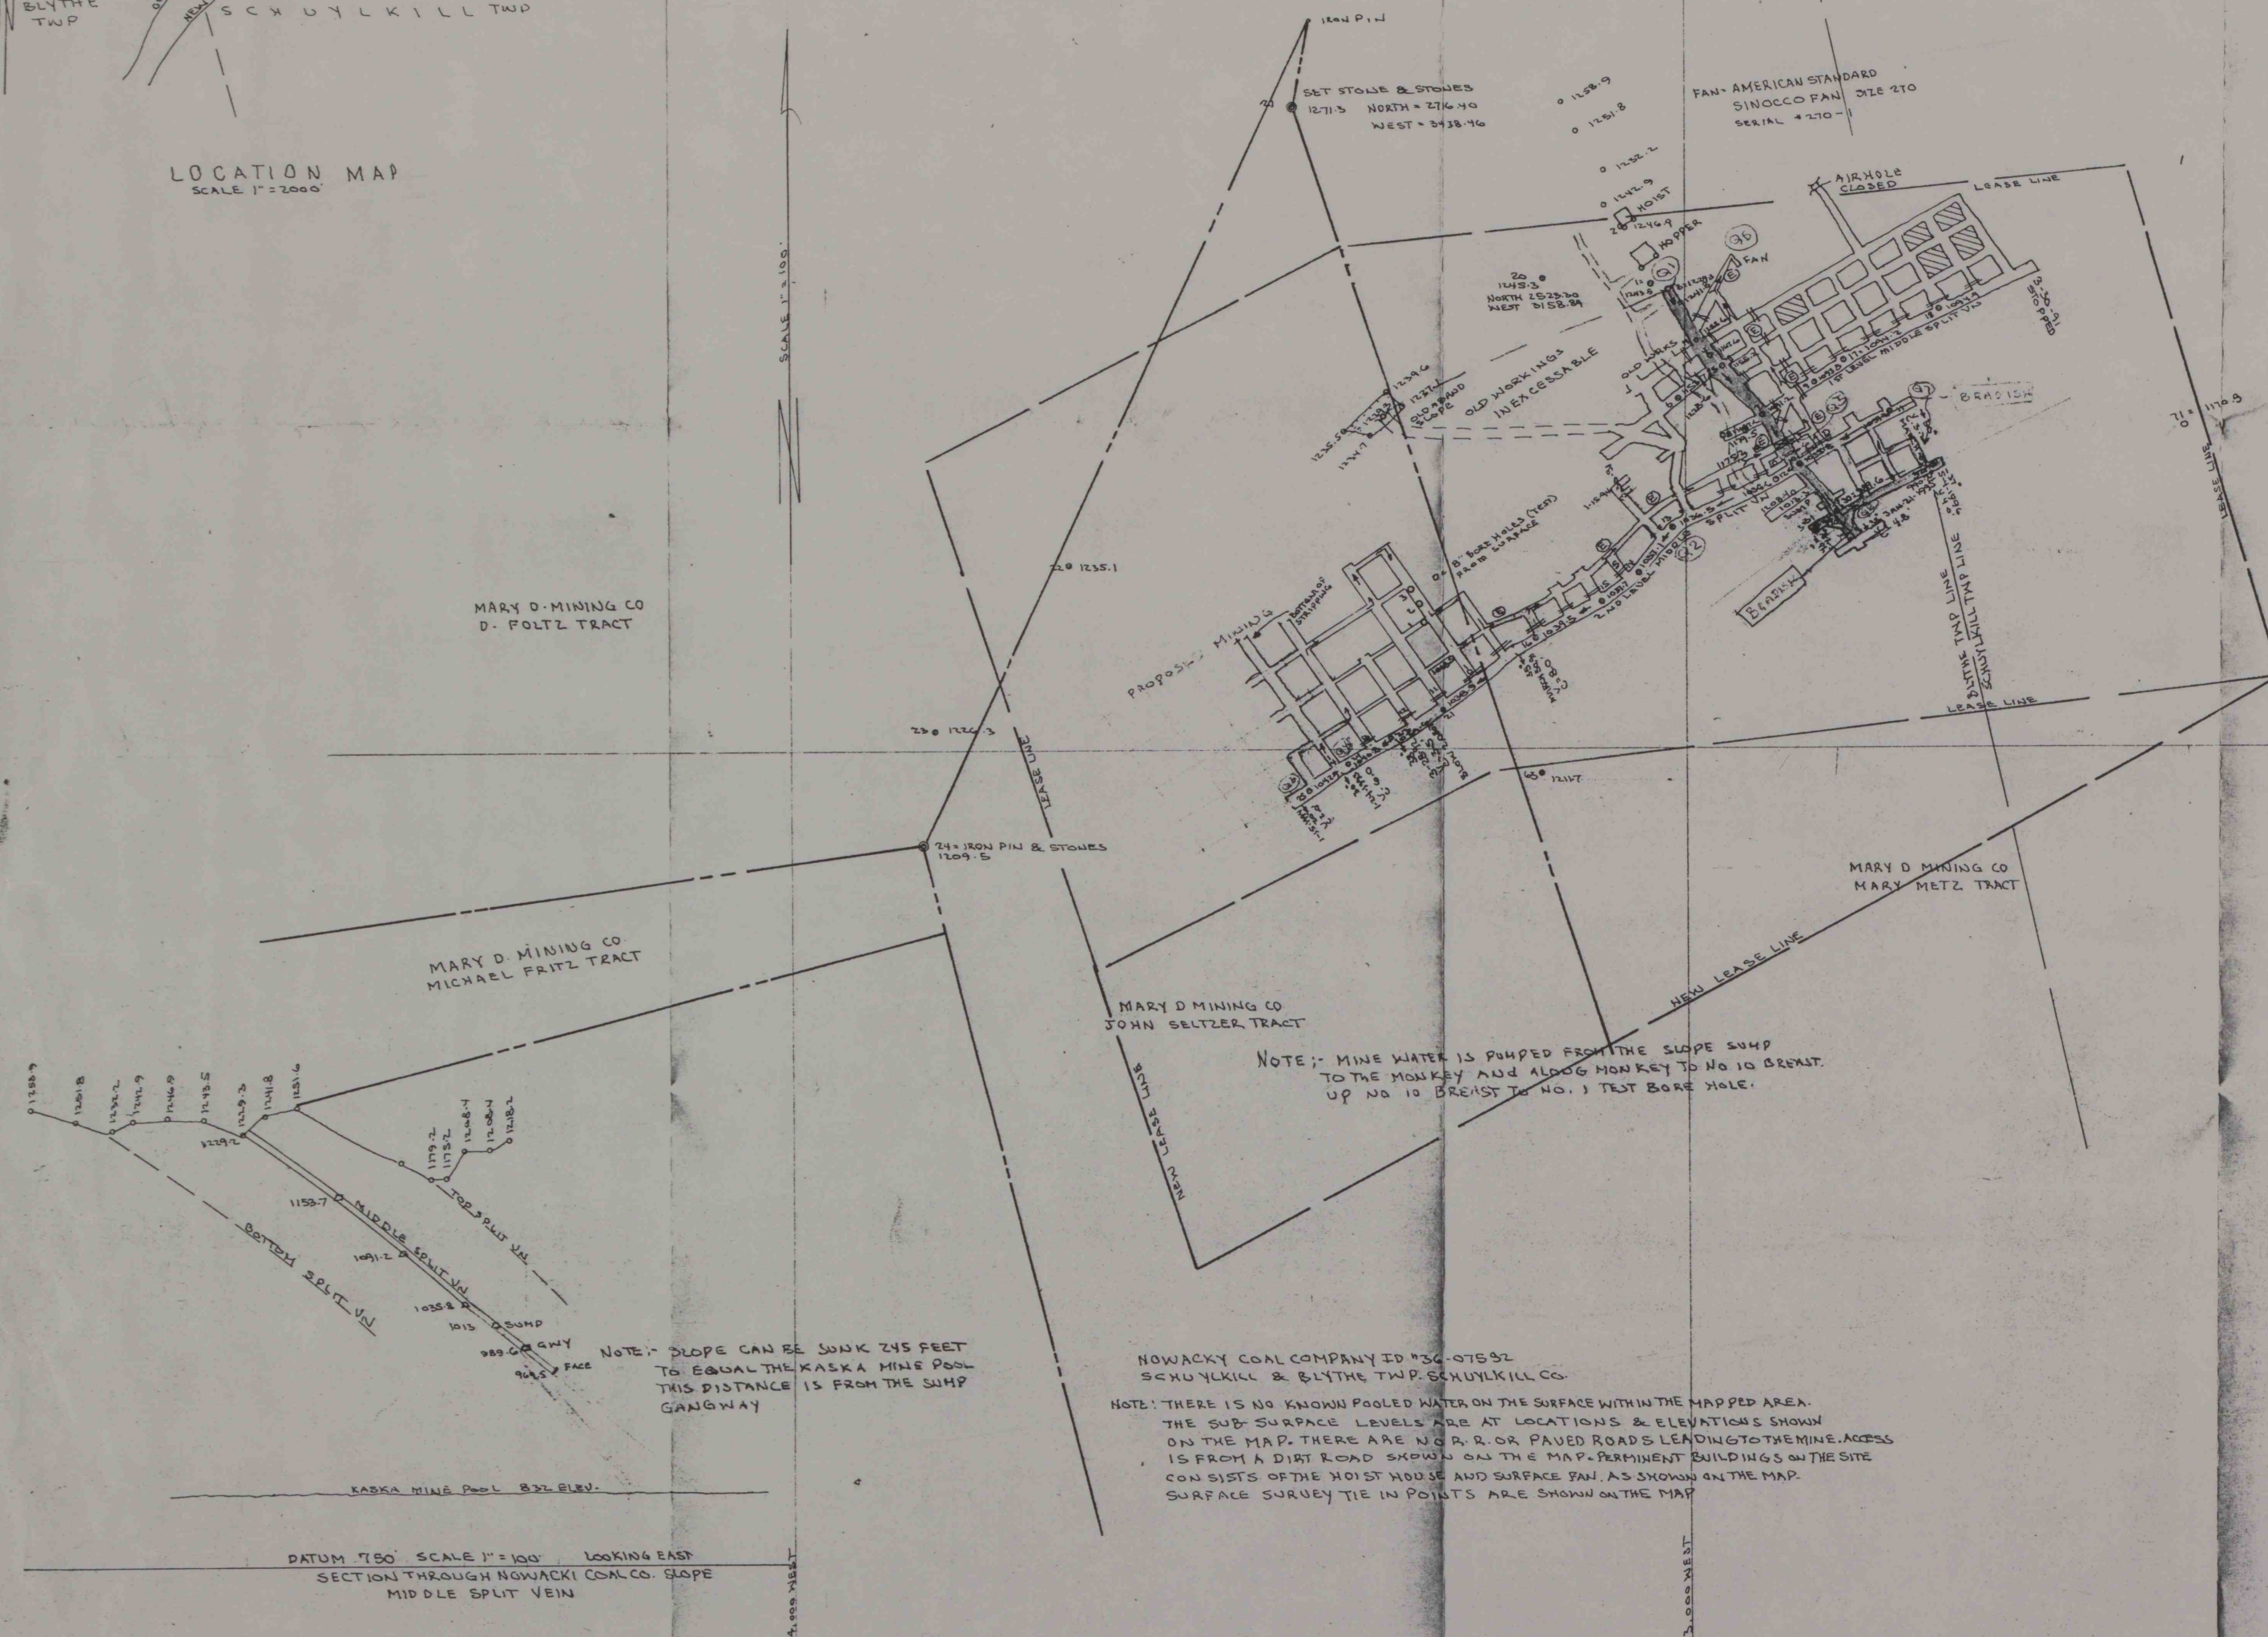

AIR VOLUME

71	15,750
72	
73	
74	
75	
76	15,500
77	15,120
78	

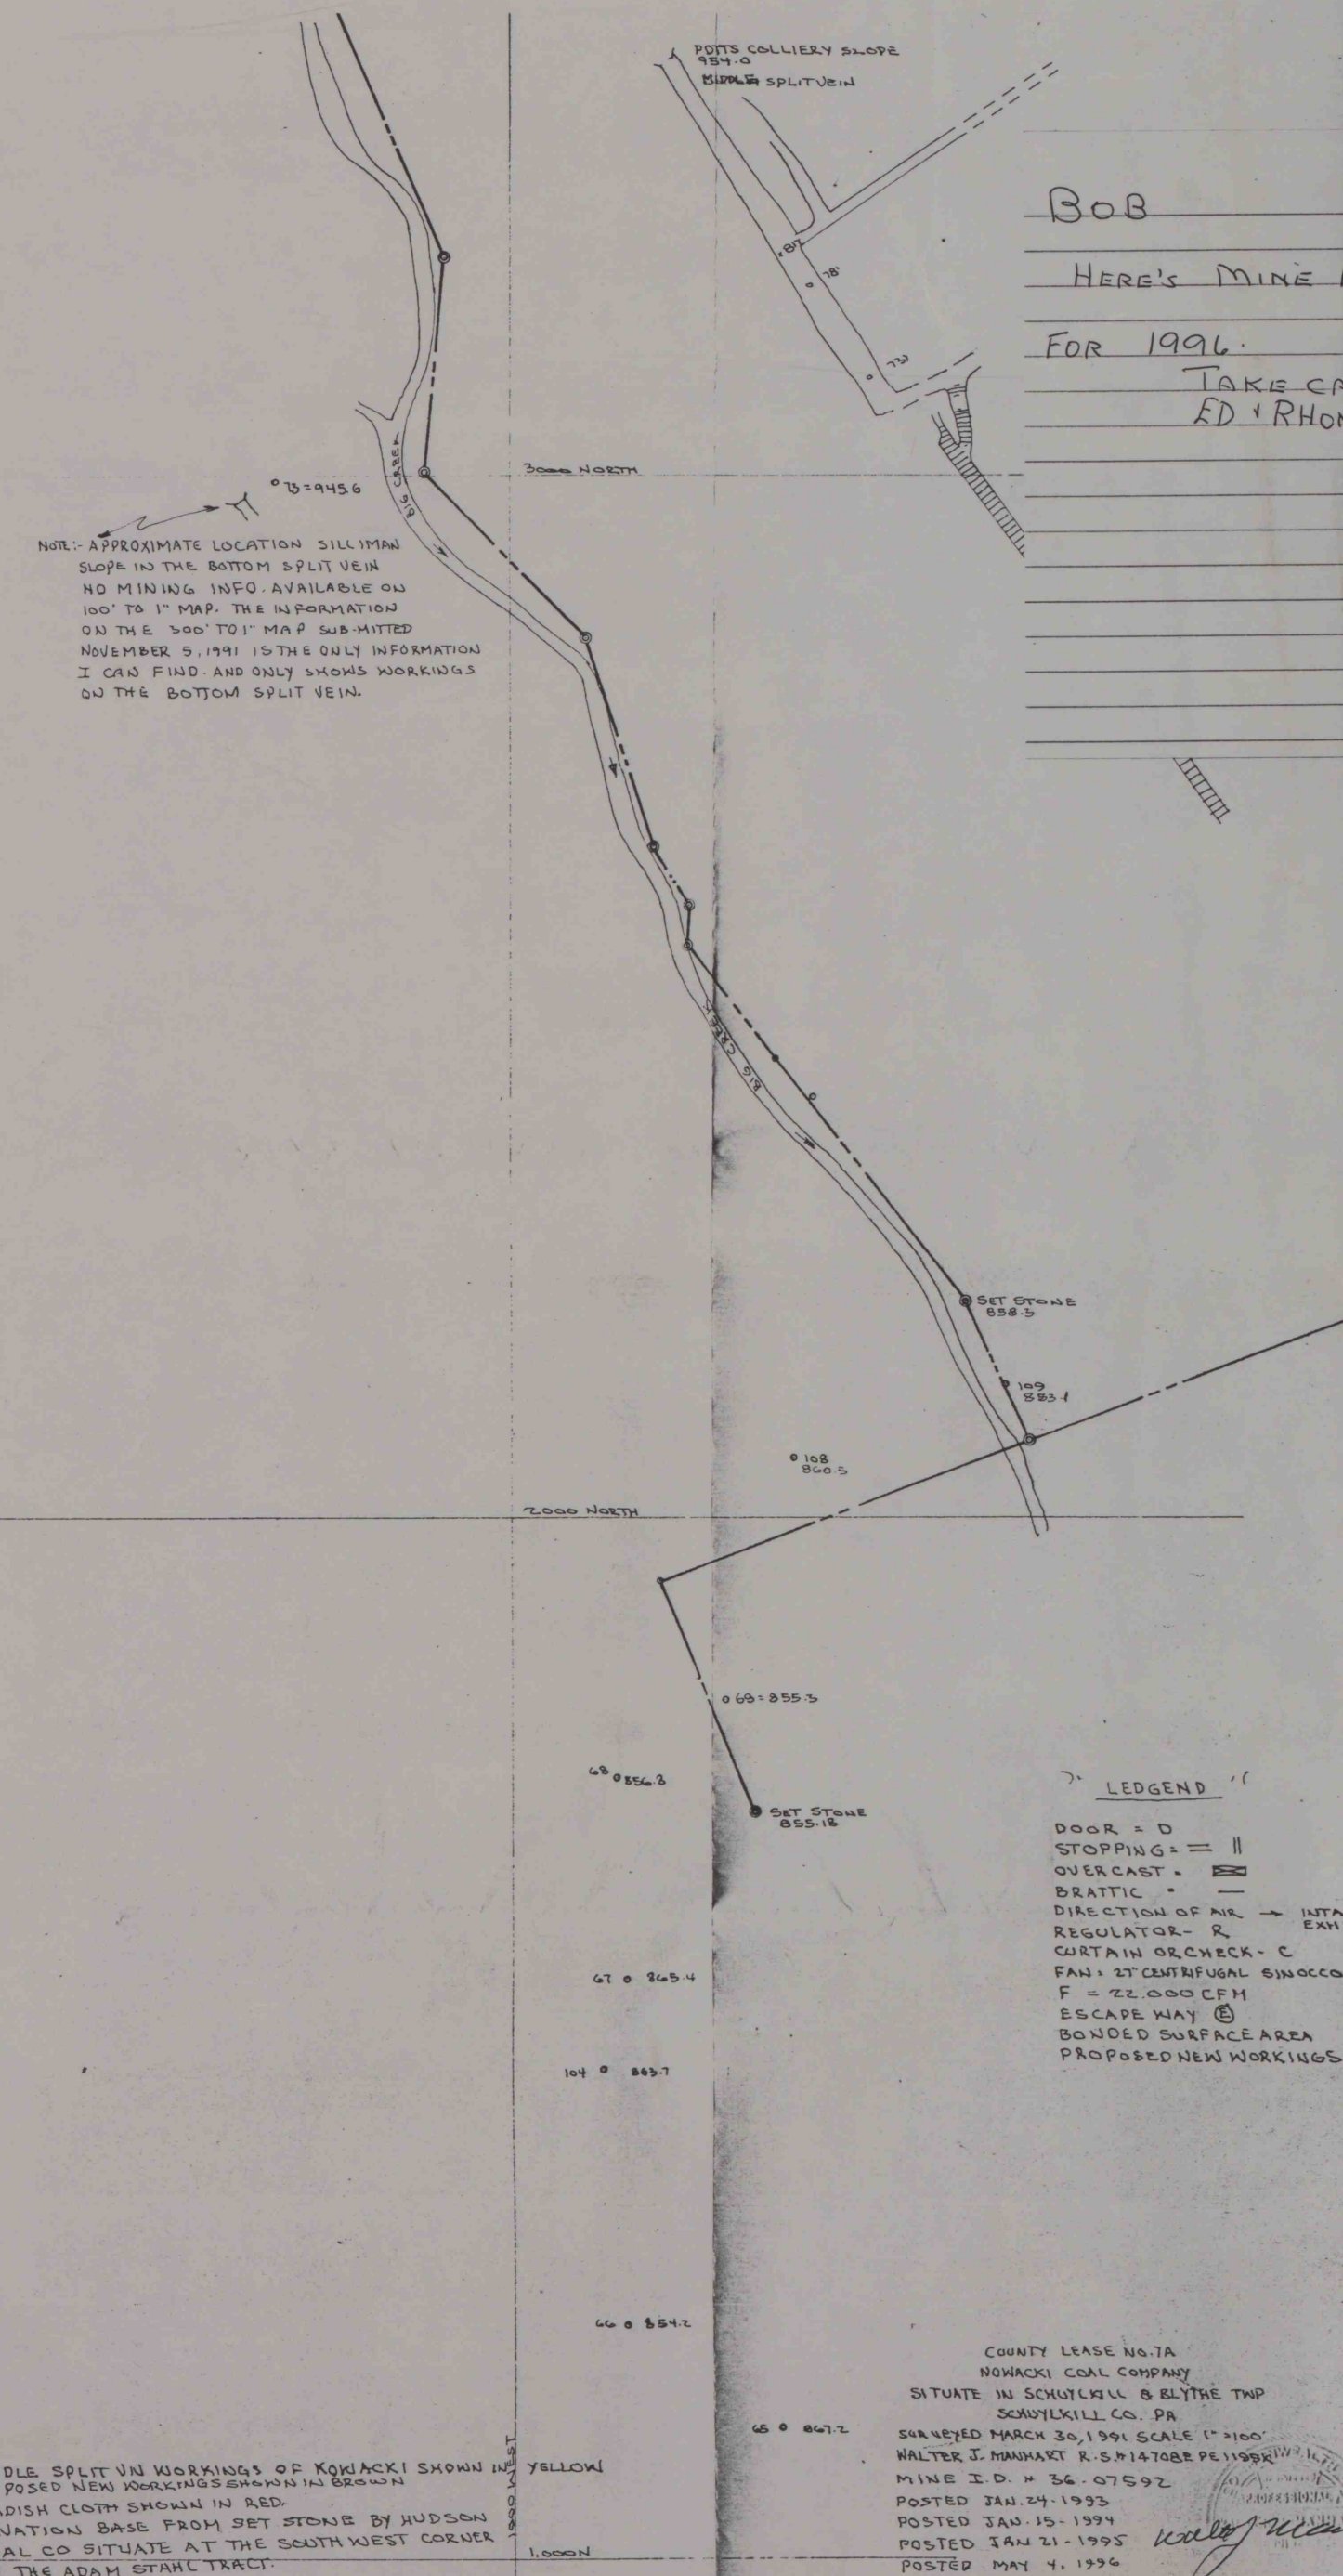

Nowacki Coal Company
Middle Split Vein
Schuylkill County
Scale 1"=100'