


Graymont (PA) Inc.

Pleasant Gap Mine

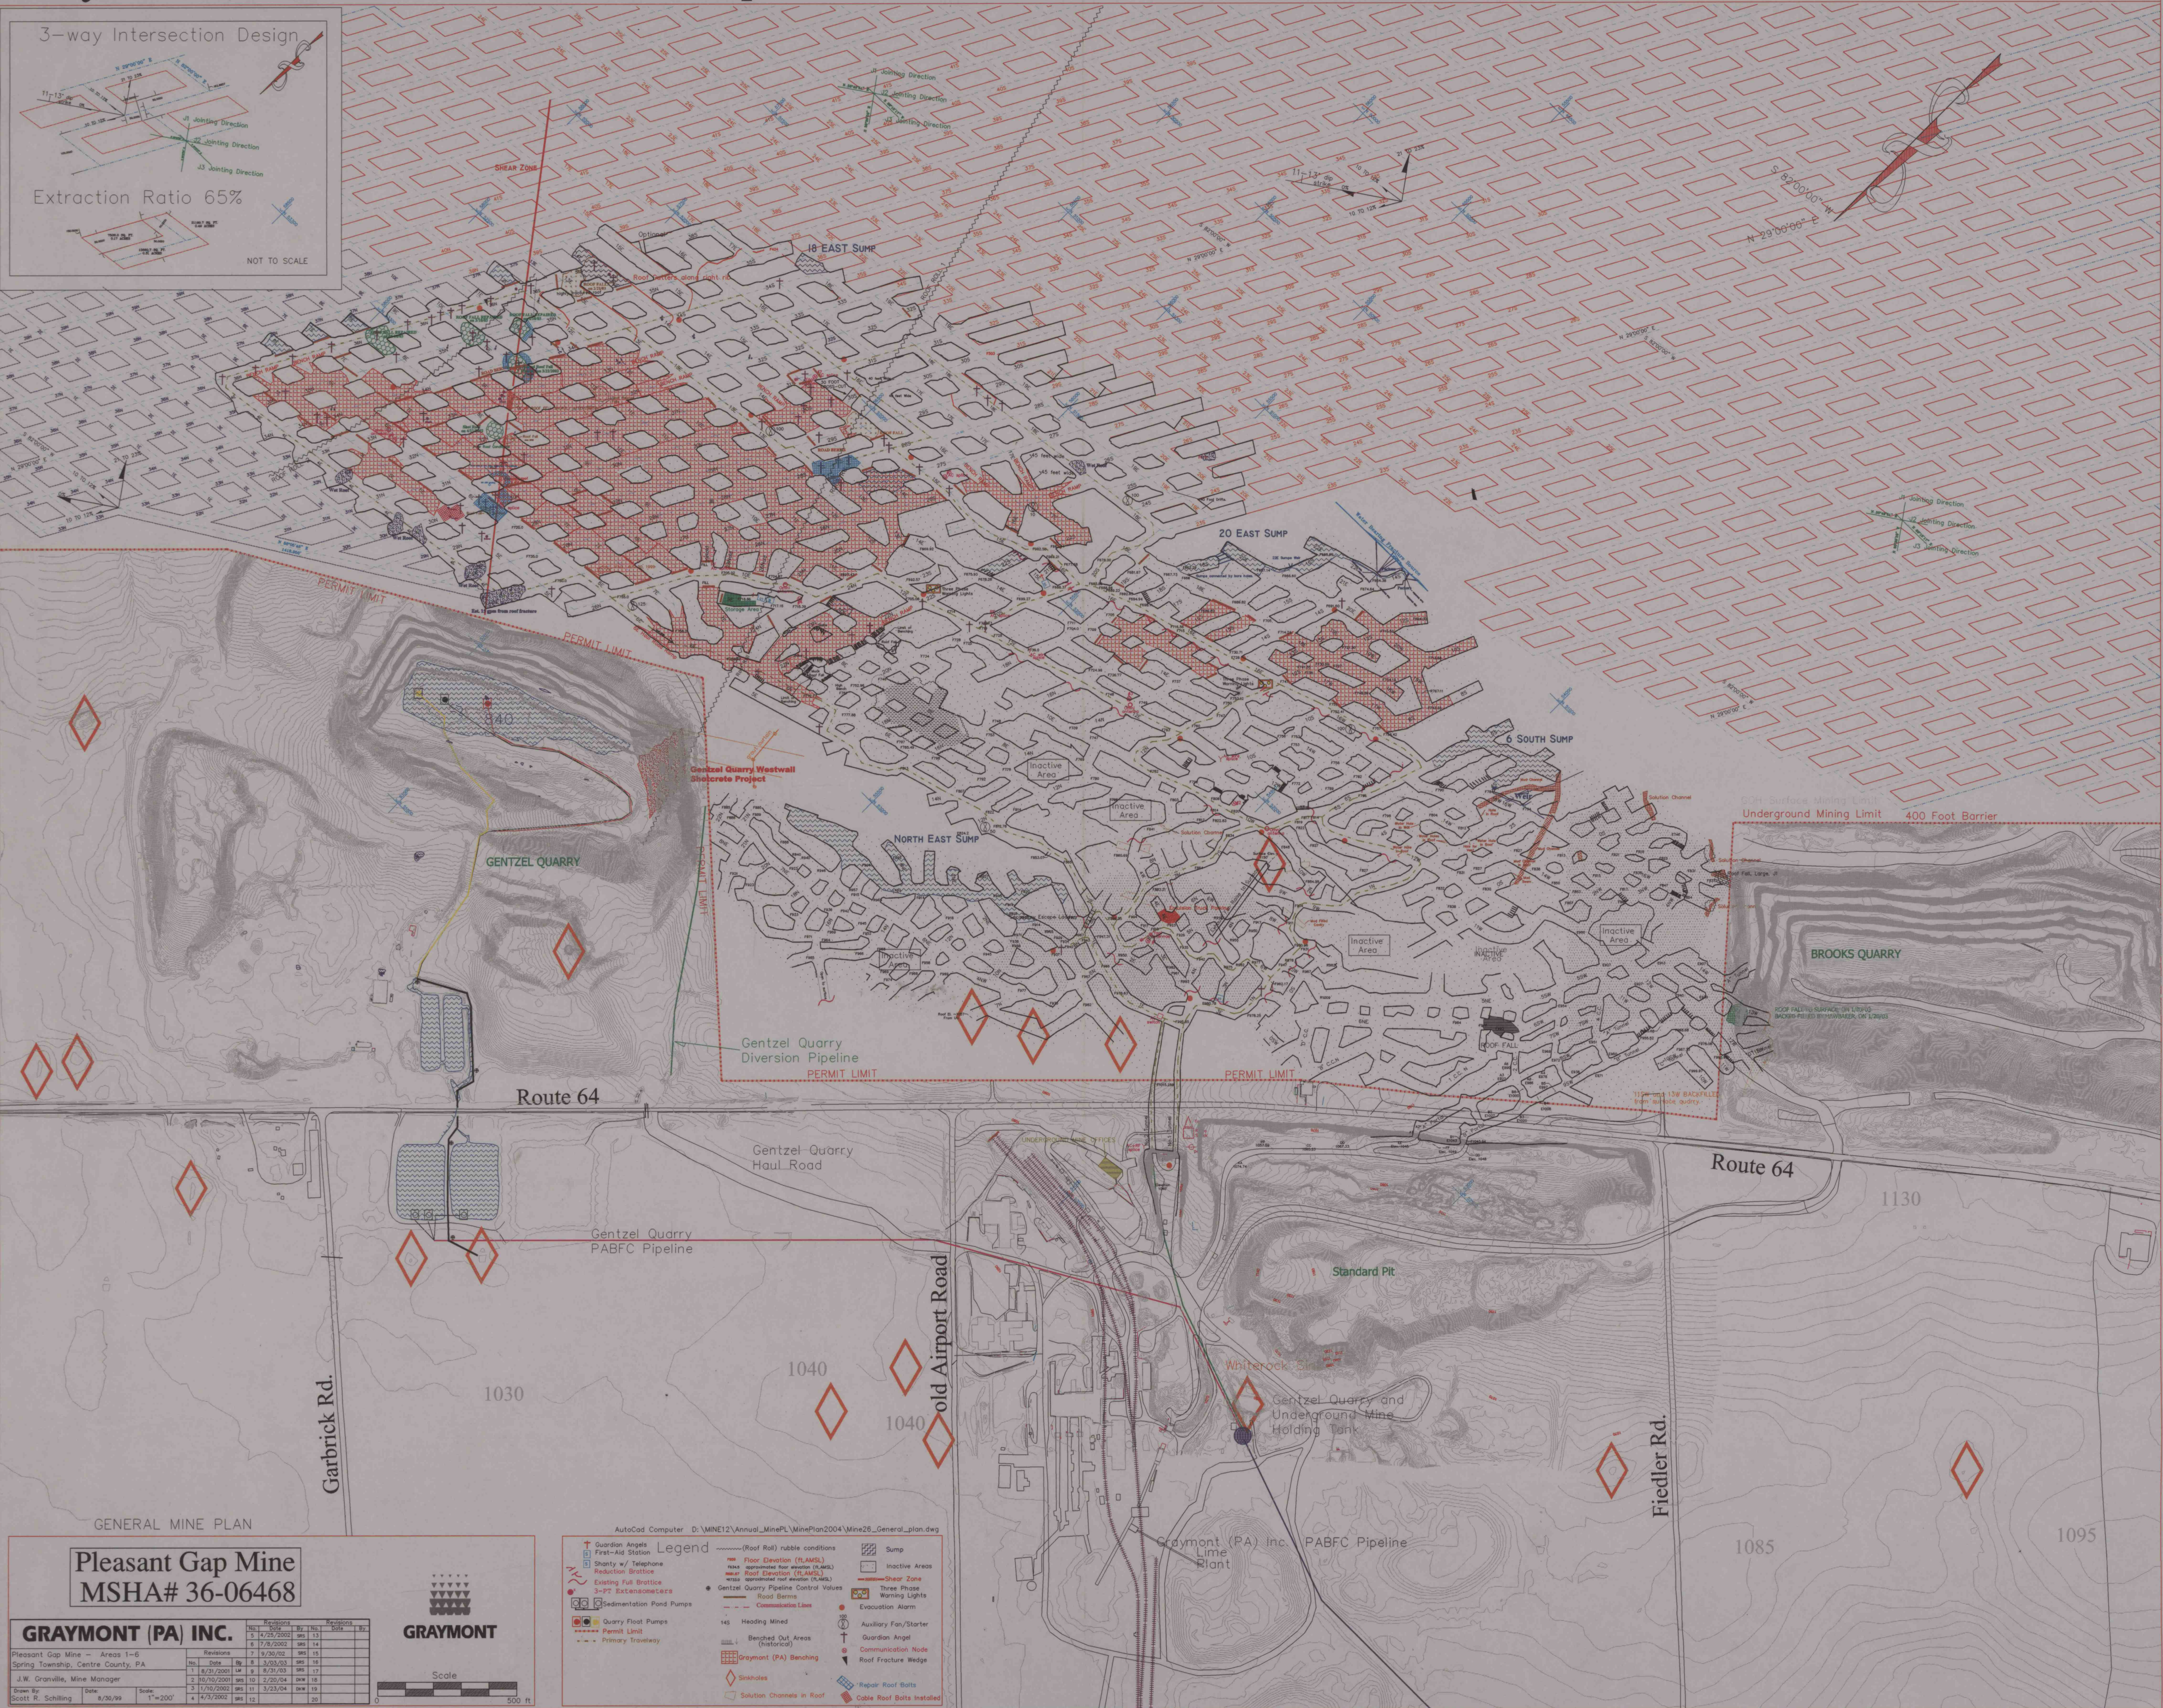

GRAYMONT, INC.
Pleasant Gap Mine
- Limestone -
Spring Township
Centre County
PA
Scale: 1" = 200'