


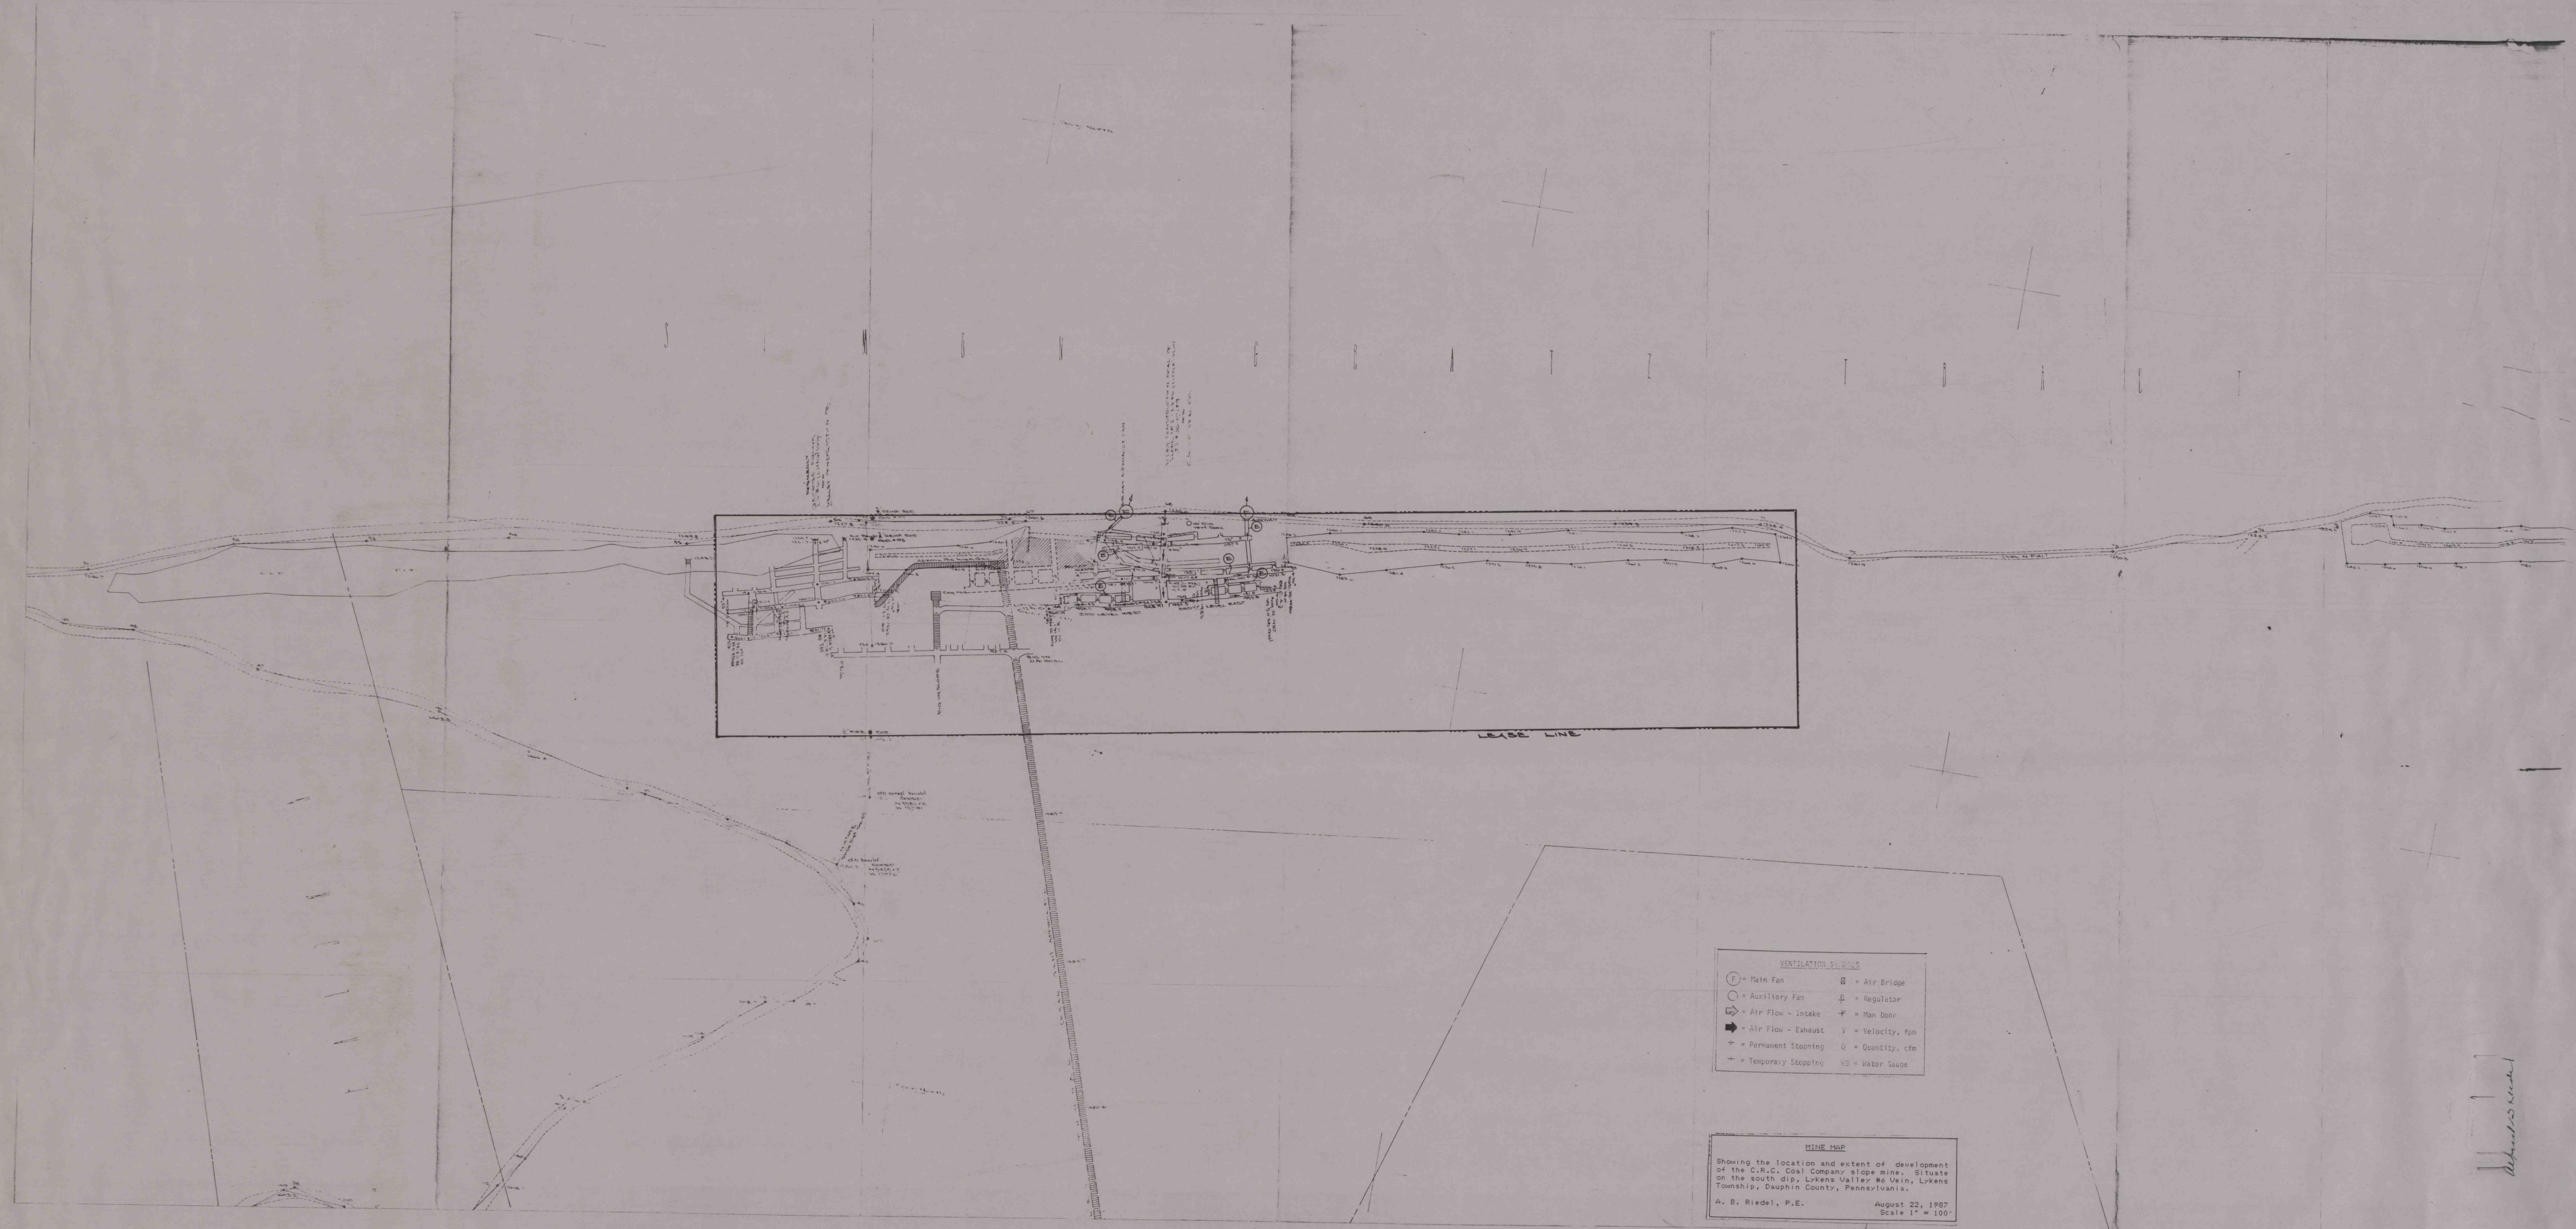

CRC Coal Company
Lycens Valley No. 4
Sloped Airway
Coal Road
Dauphin County
Scale 1" = 100'