


H E N R Y S C H R E I N E R

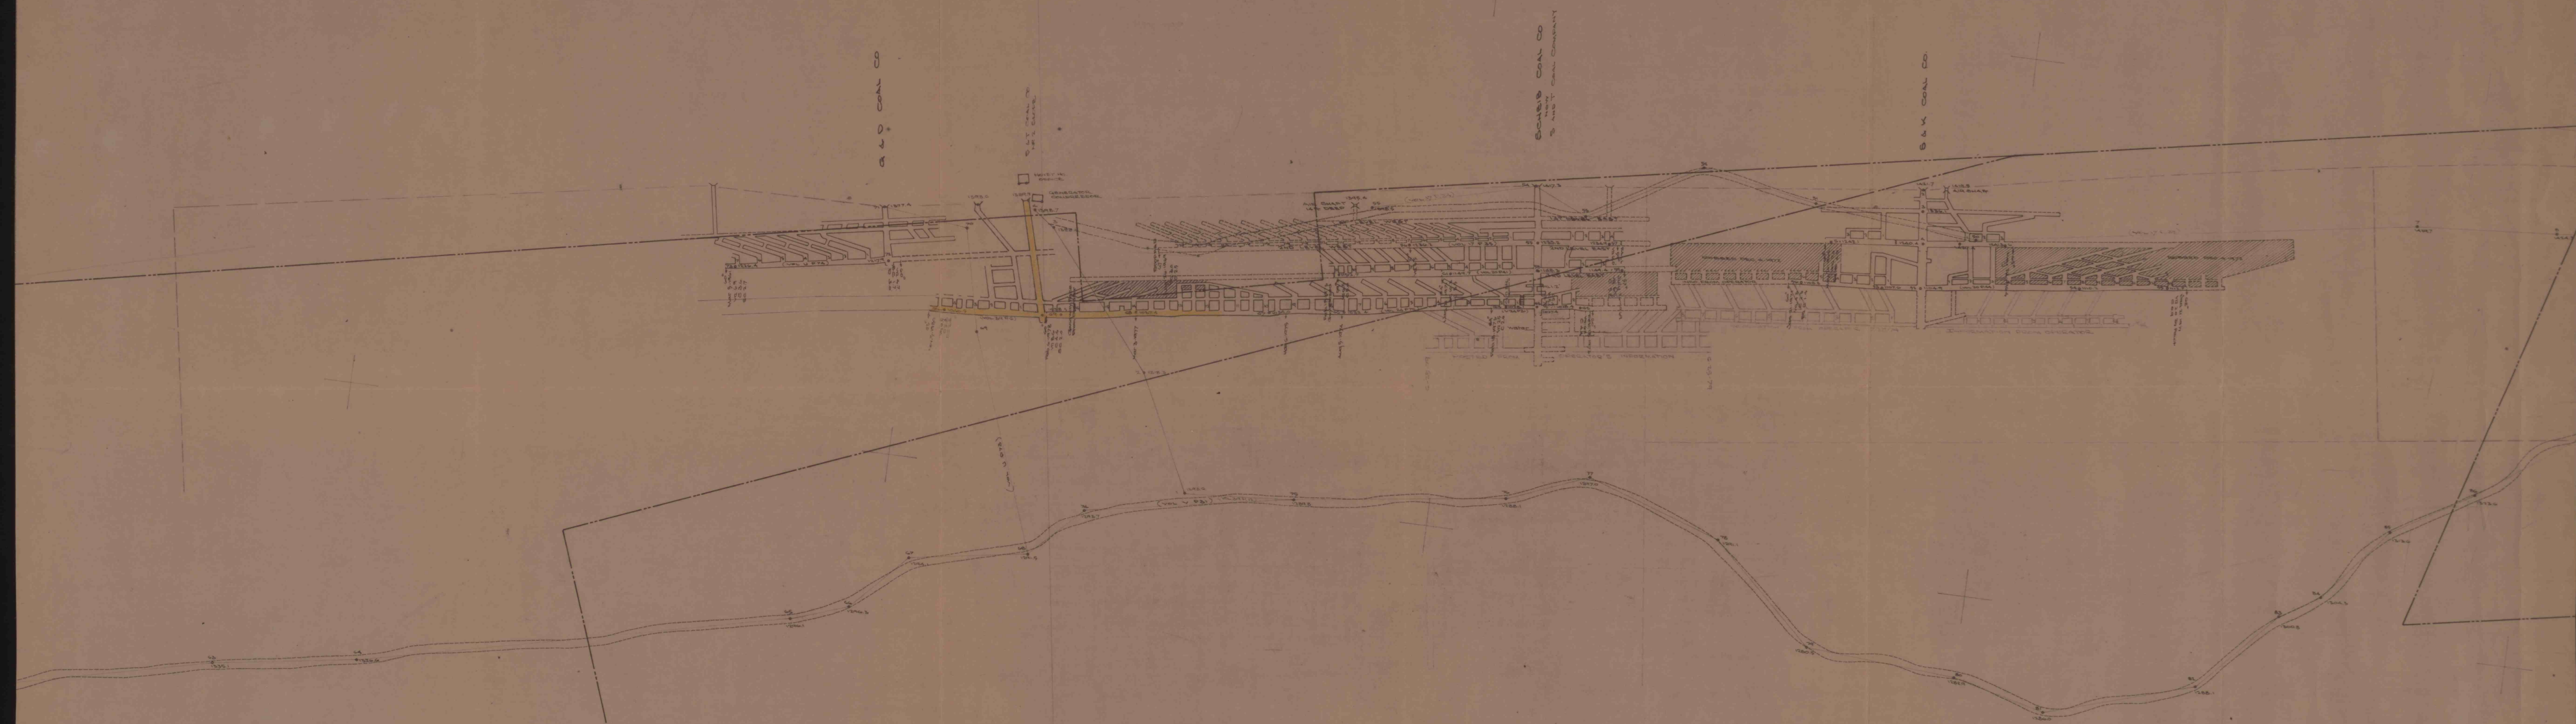

D A N I E L W I L L I A M

*April 1892*