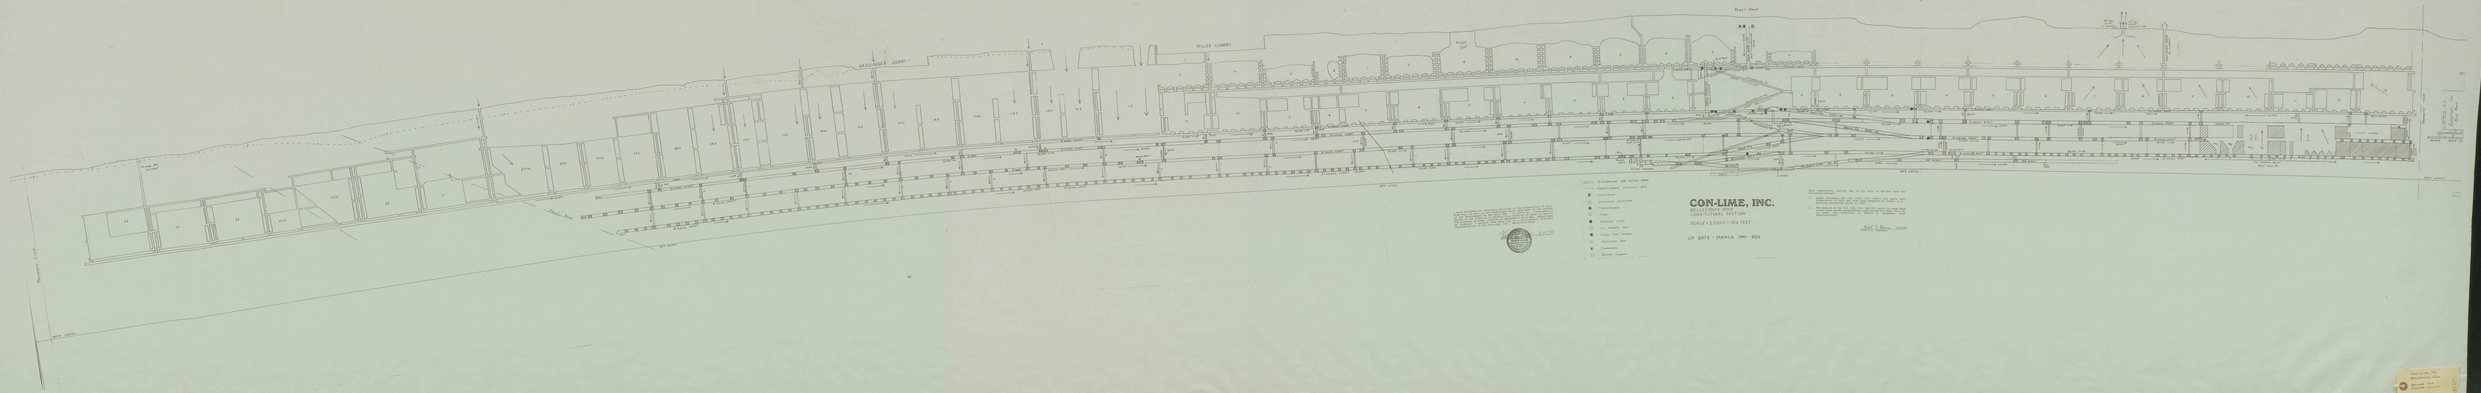
MILLER QUARRY
MILLER CURRY
PLANT AREA
SEA LEVEL
CONVEYOR
CONVEYOR
CONVEYOR