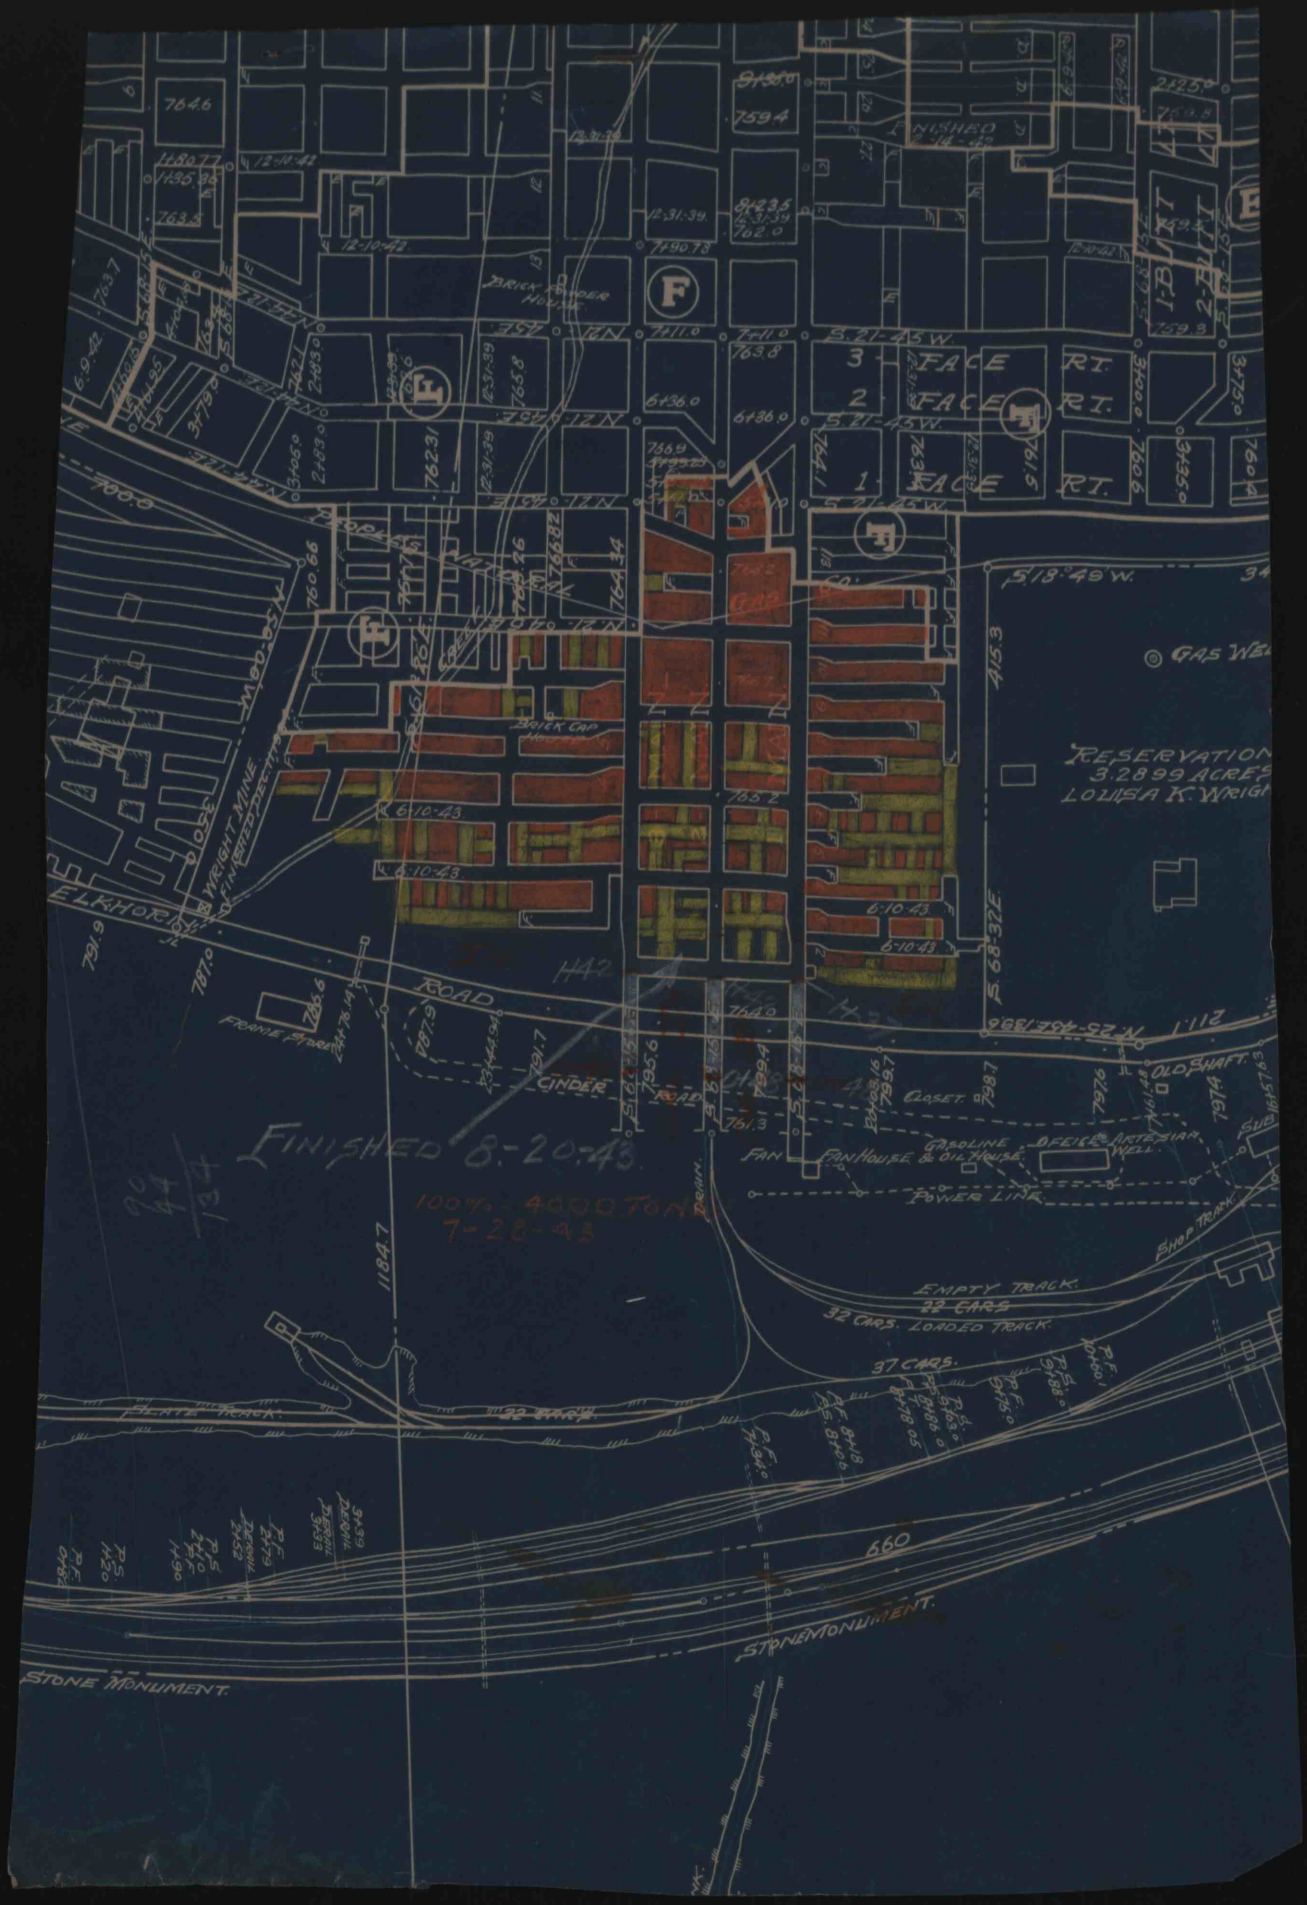
BRICK POWDER HOUSE
3 - FACE R.T.
2 - FACE R.T.
1 - FACE R.T.
BRICK CAP
RESERVATION
3.2899 ACRES
LOUISA K. WRIGH
GAS WE
ROAD
CINDER ROAD
FRAME STABLE
CLOSET
FAN
FAN HOUSE & OIL HOUSE
GASOLINE
DEFIER ARTESIAN WELL
POWER LINE
OLD SHAFT
SHOP TRACK
EMPTY TRACK
32 CARS. LOADED TRACK
37 CARS.
PLATE TRACK
STONE MONUMENT
FINISHED 8-20-43
100% - 4000 TON
7-26-43