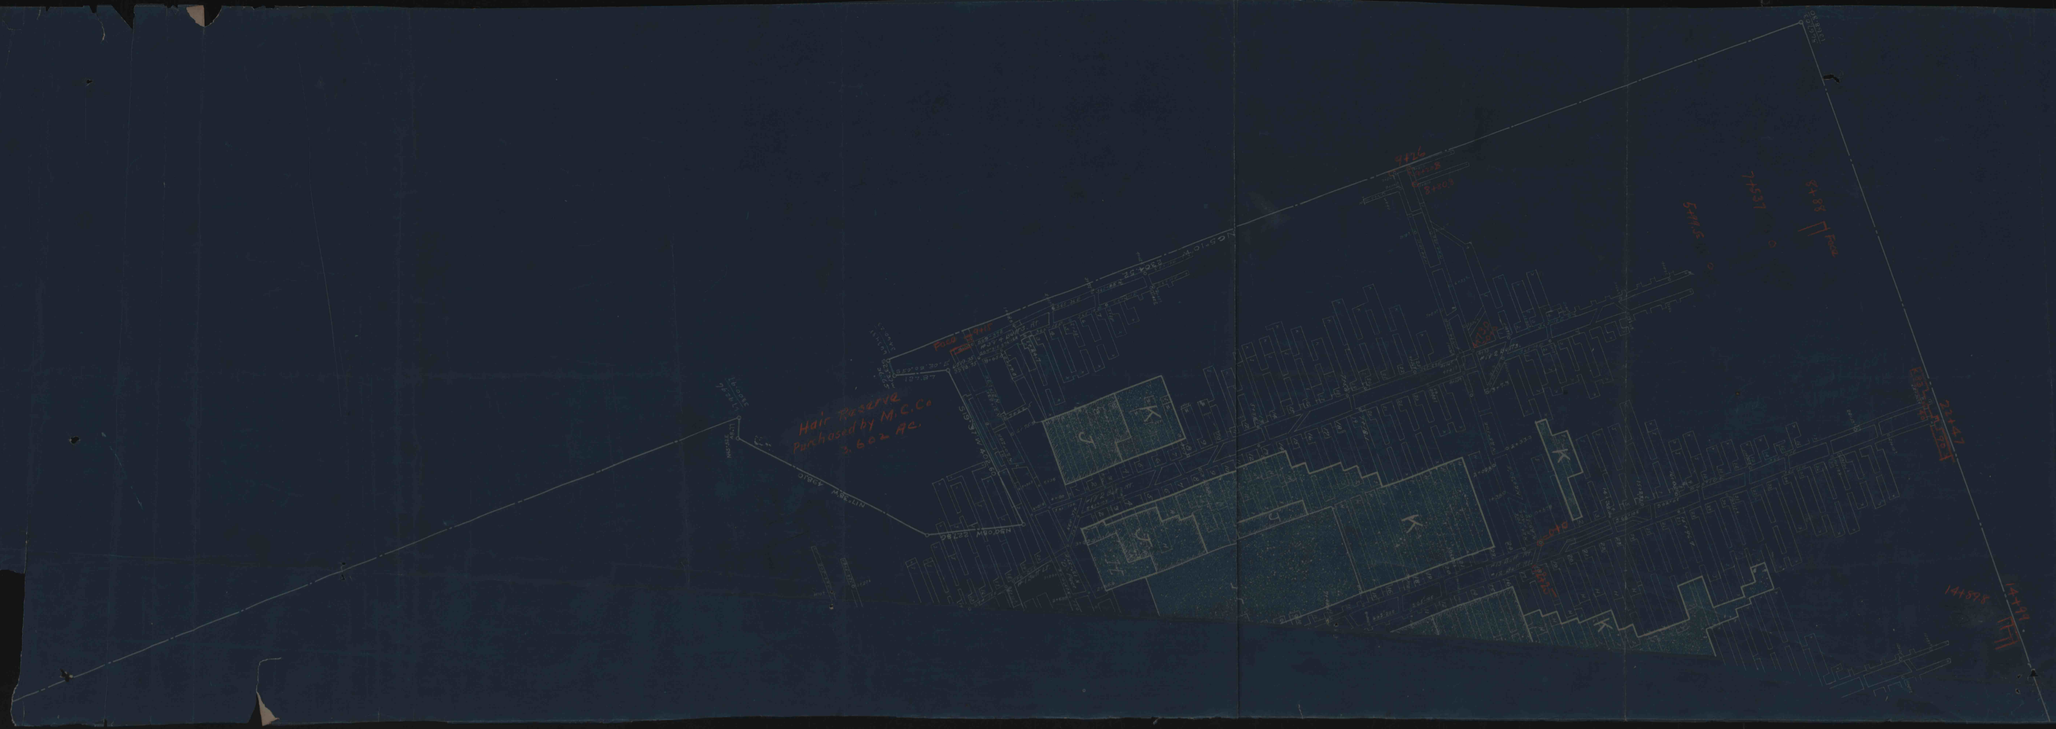
Hall Reserve
Purchased by M.C.Co
3.622 Ac.
DRUCE AVENUE
MOTOR ROAD
