


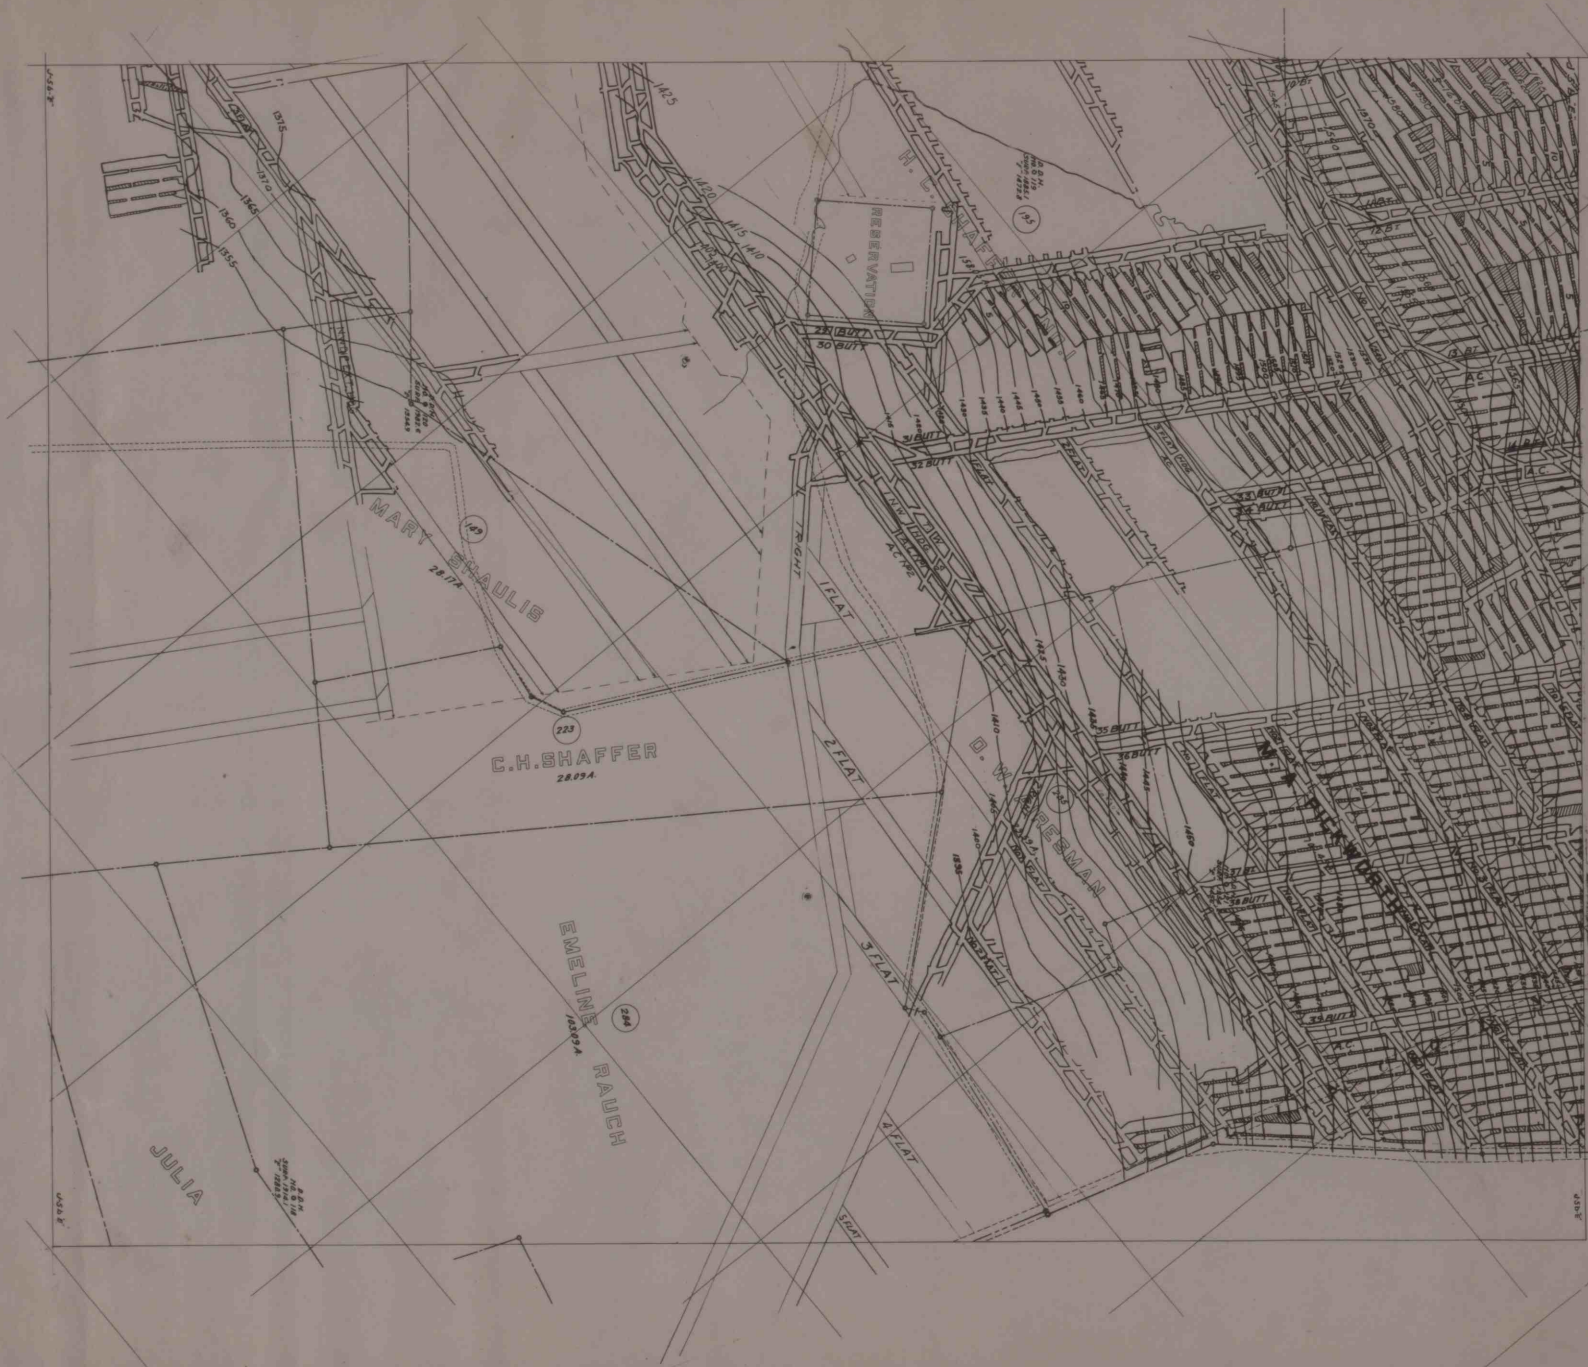

15. 1000