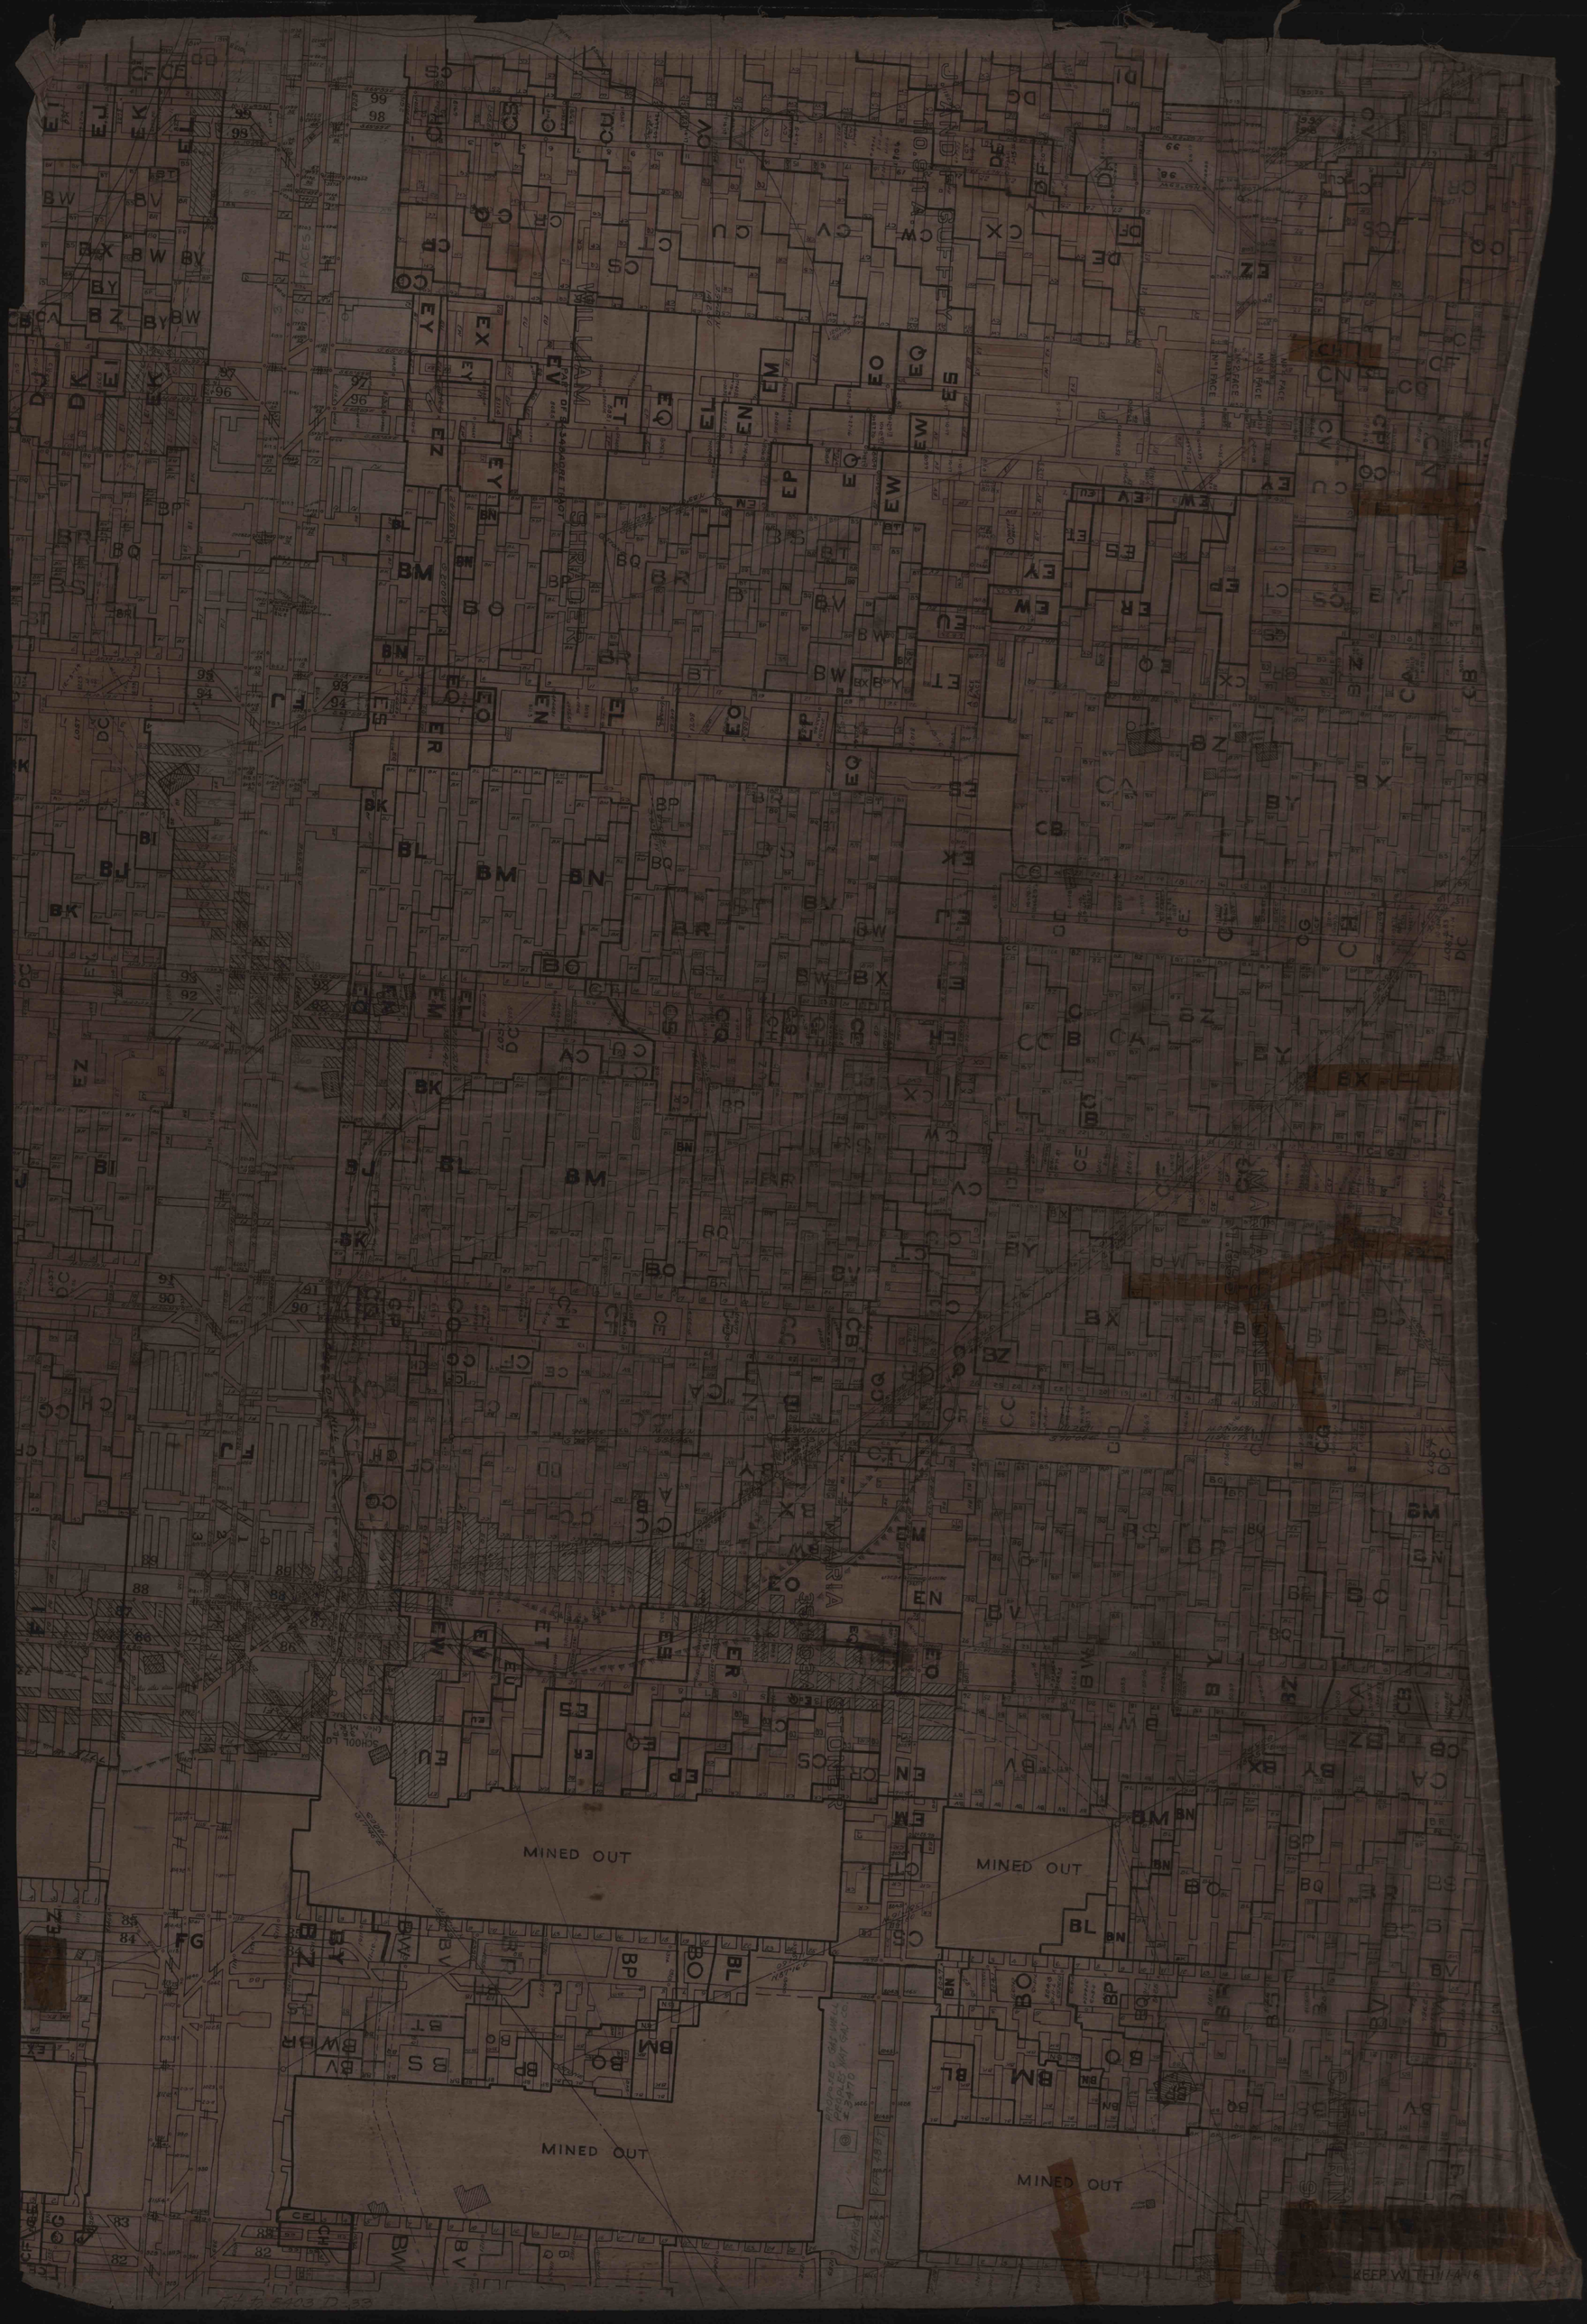
MINED OUT
MINED OUT
MINED OUT
MINED OUT
KEEP WITH MAPS