


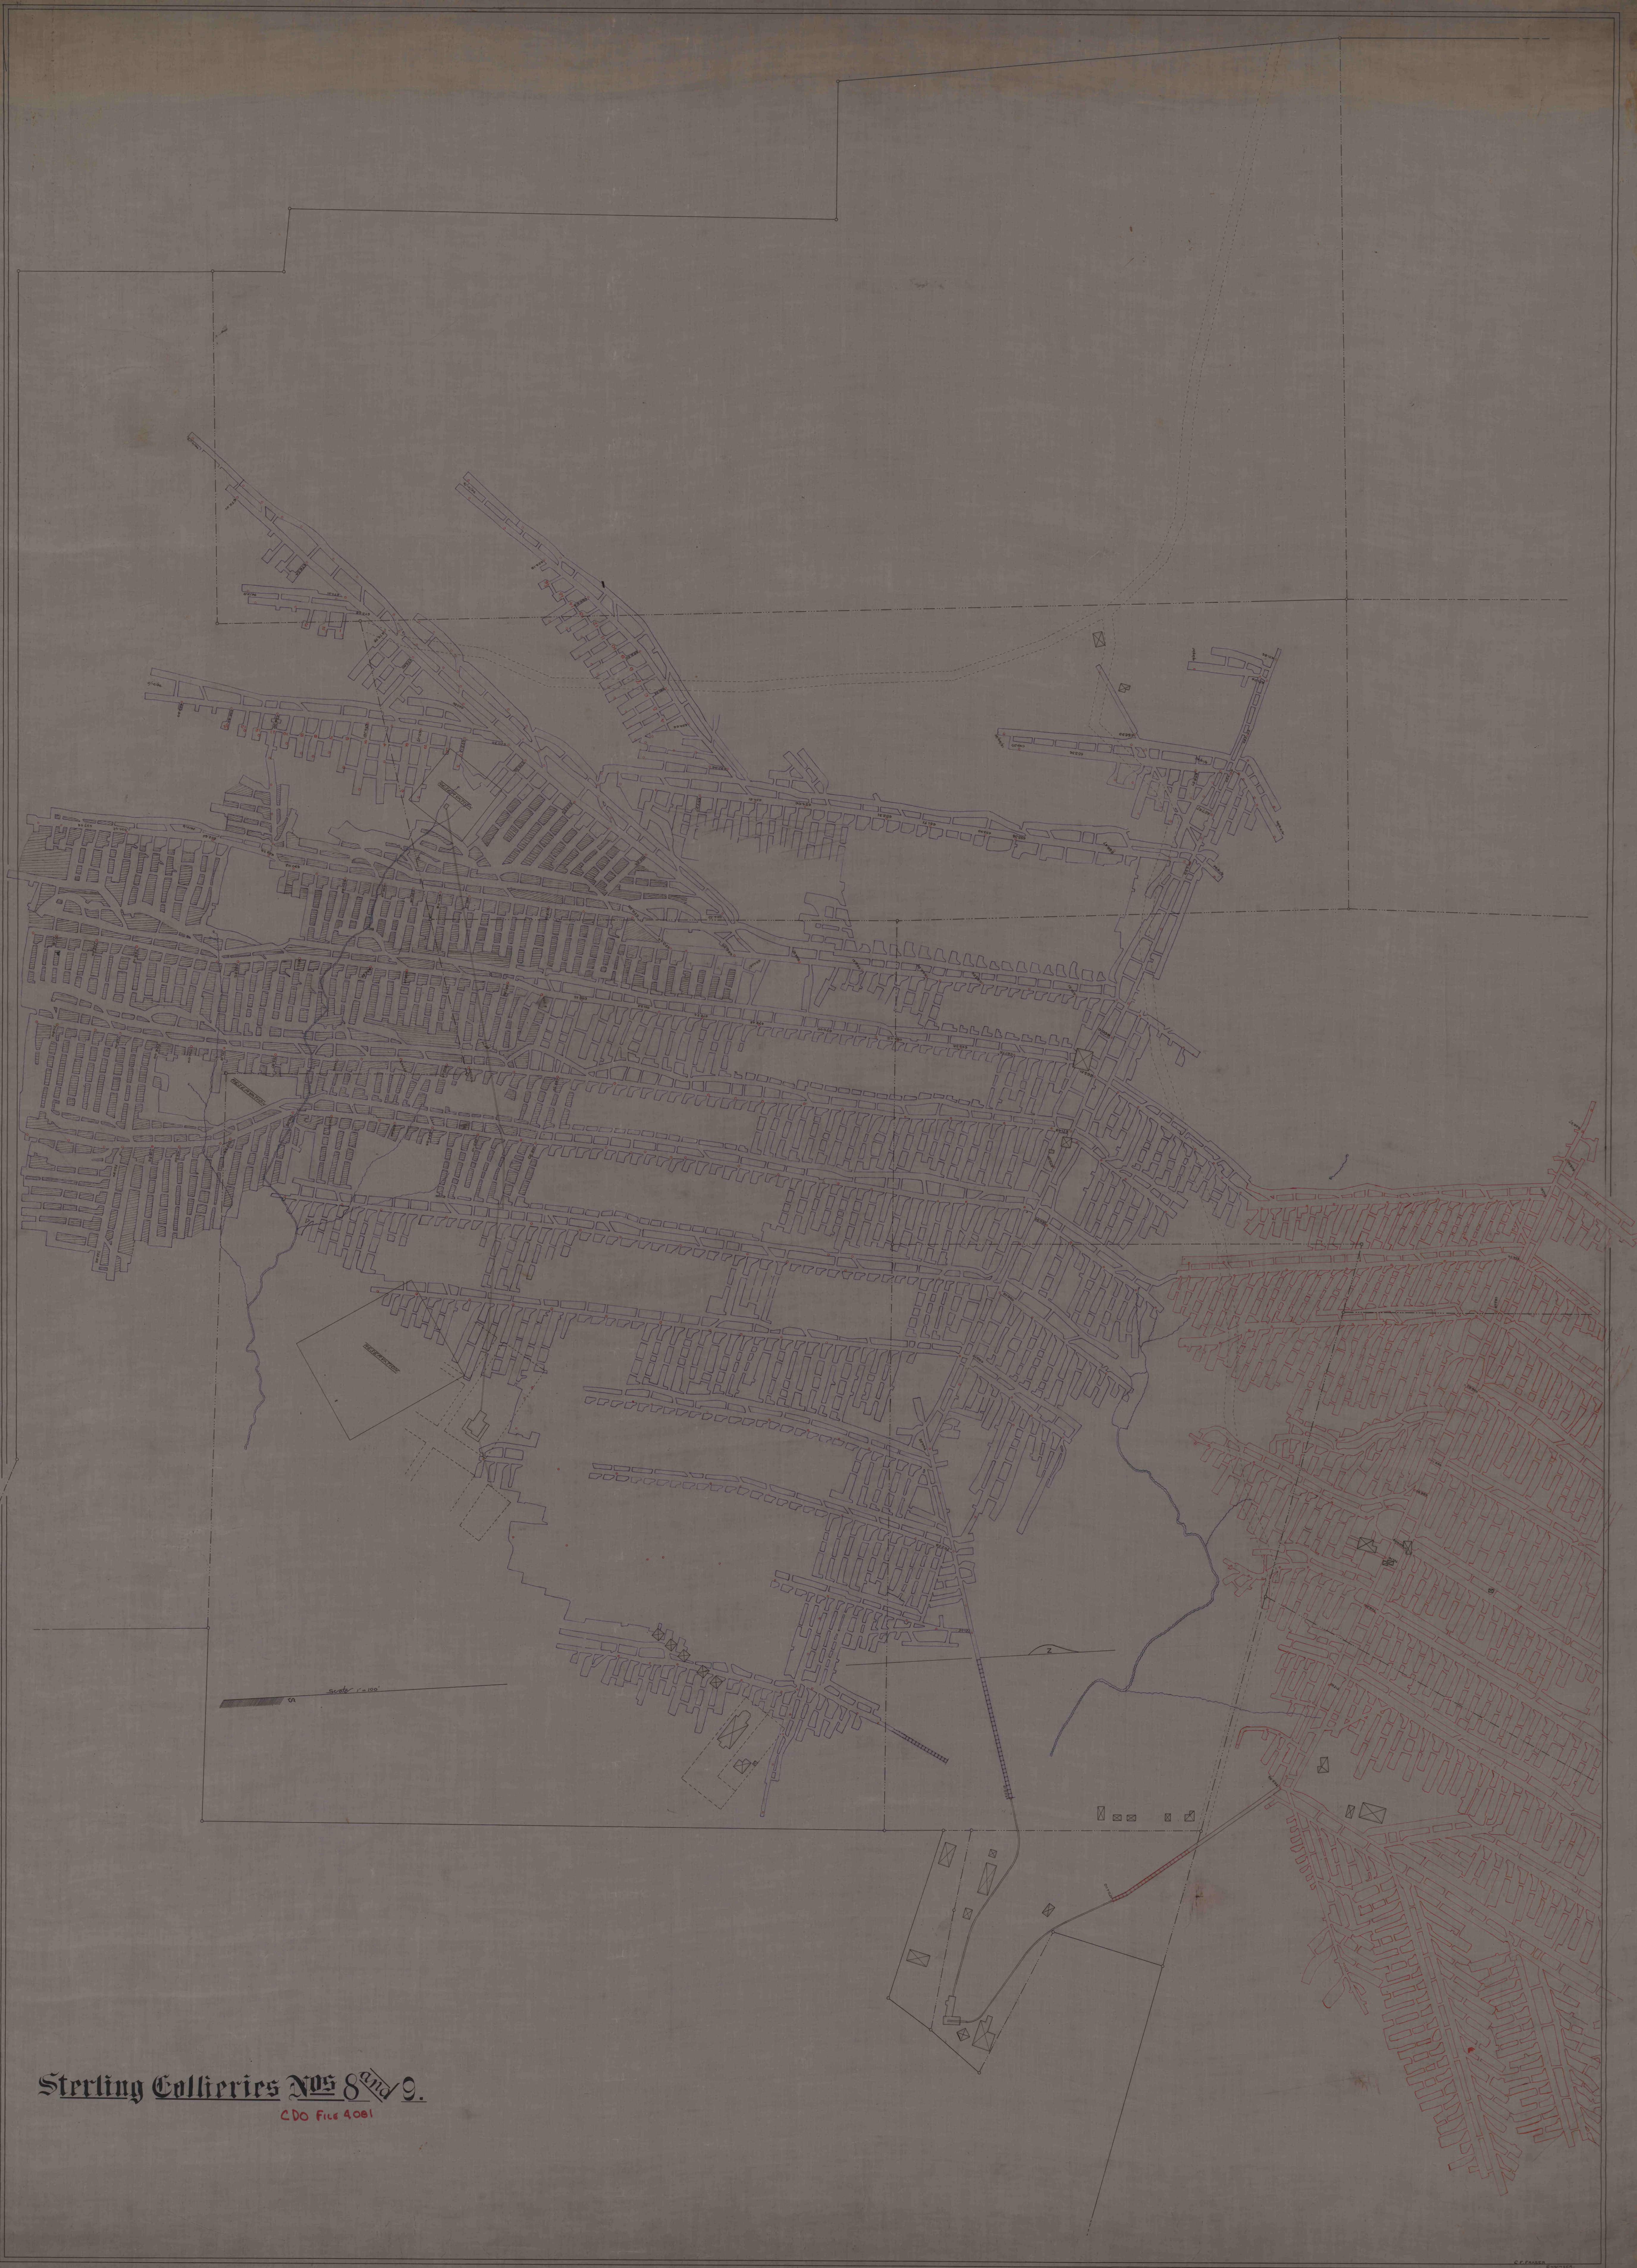

Sterling Collieries Nos 8 and 9.

CDO File 4081