


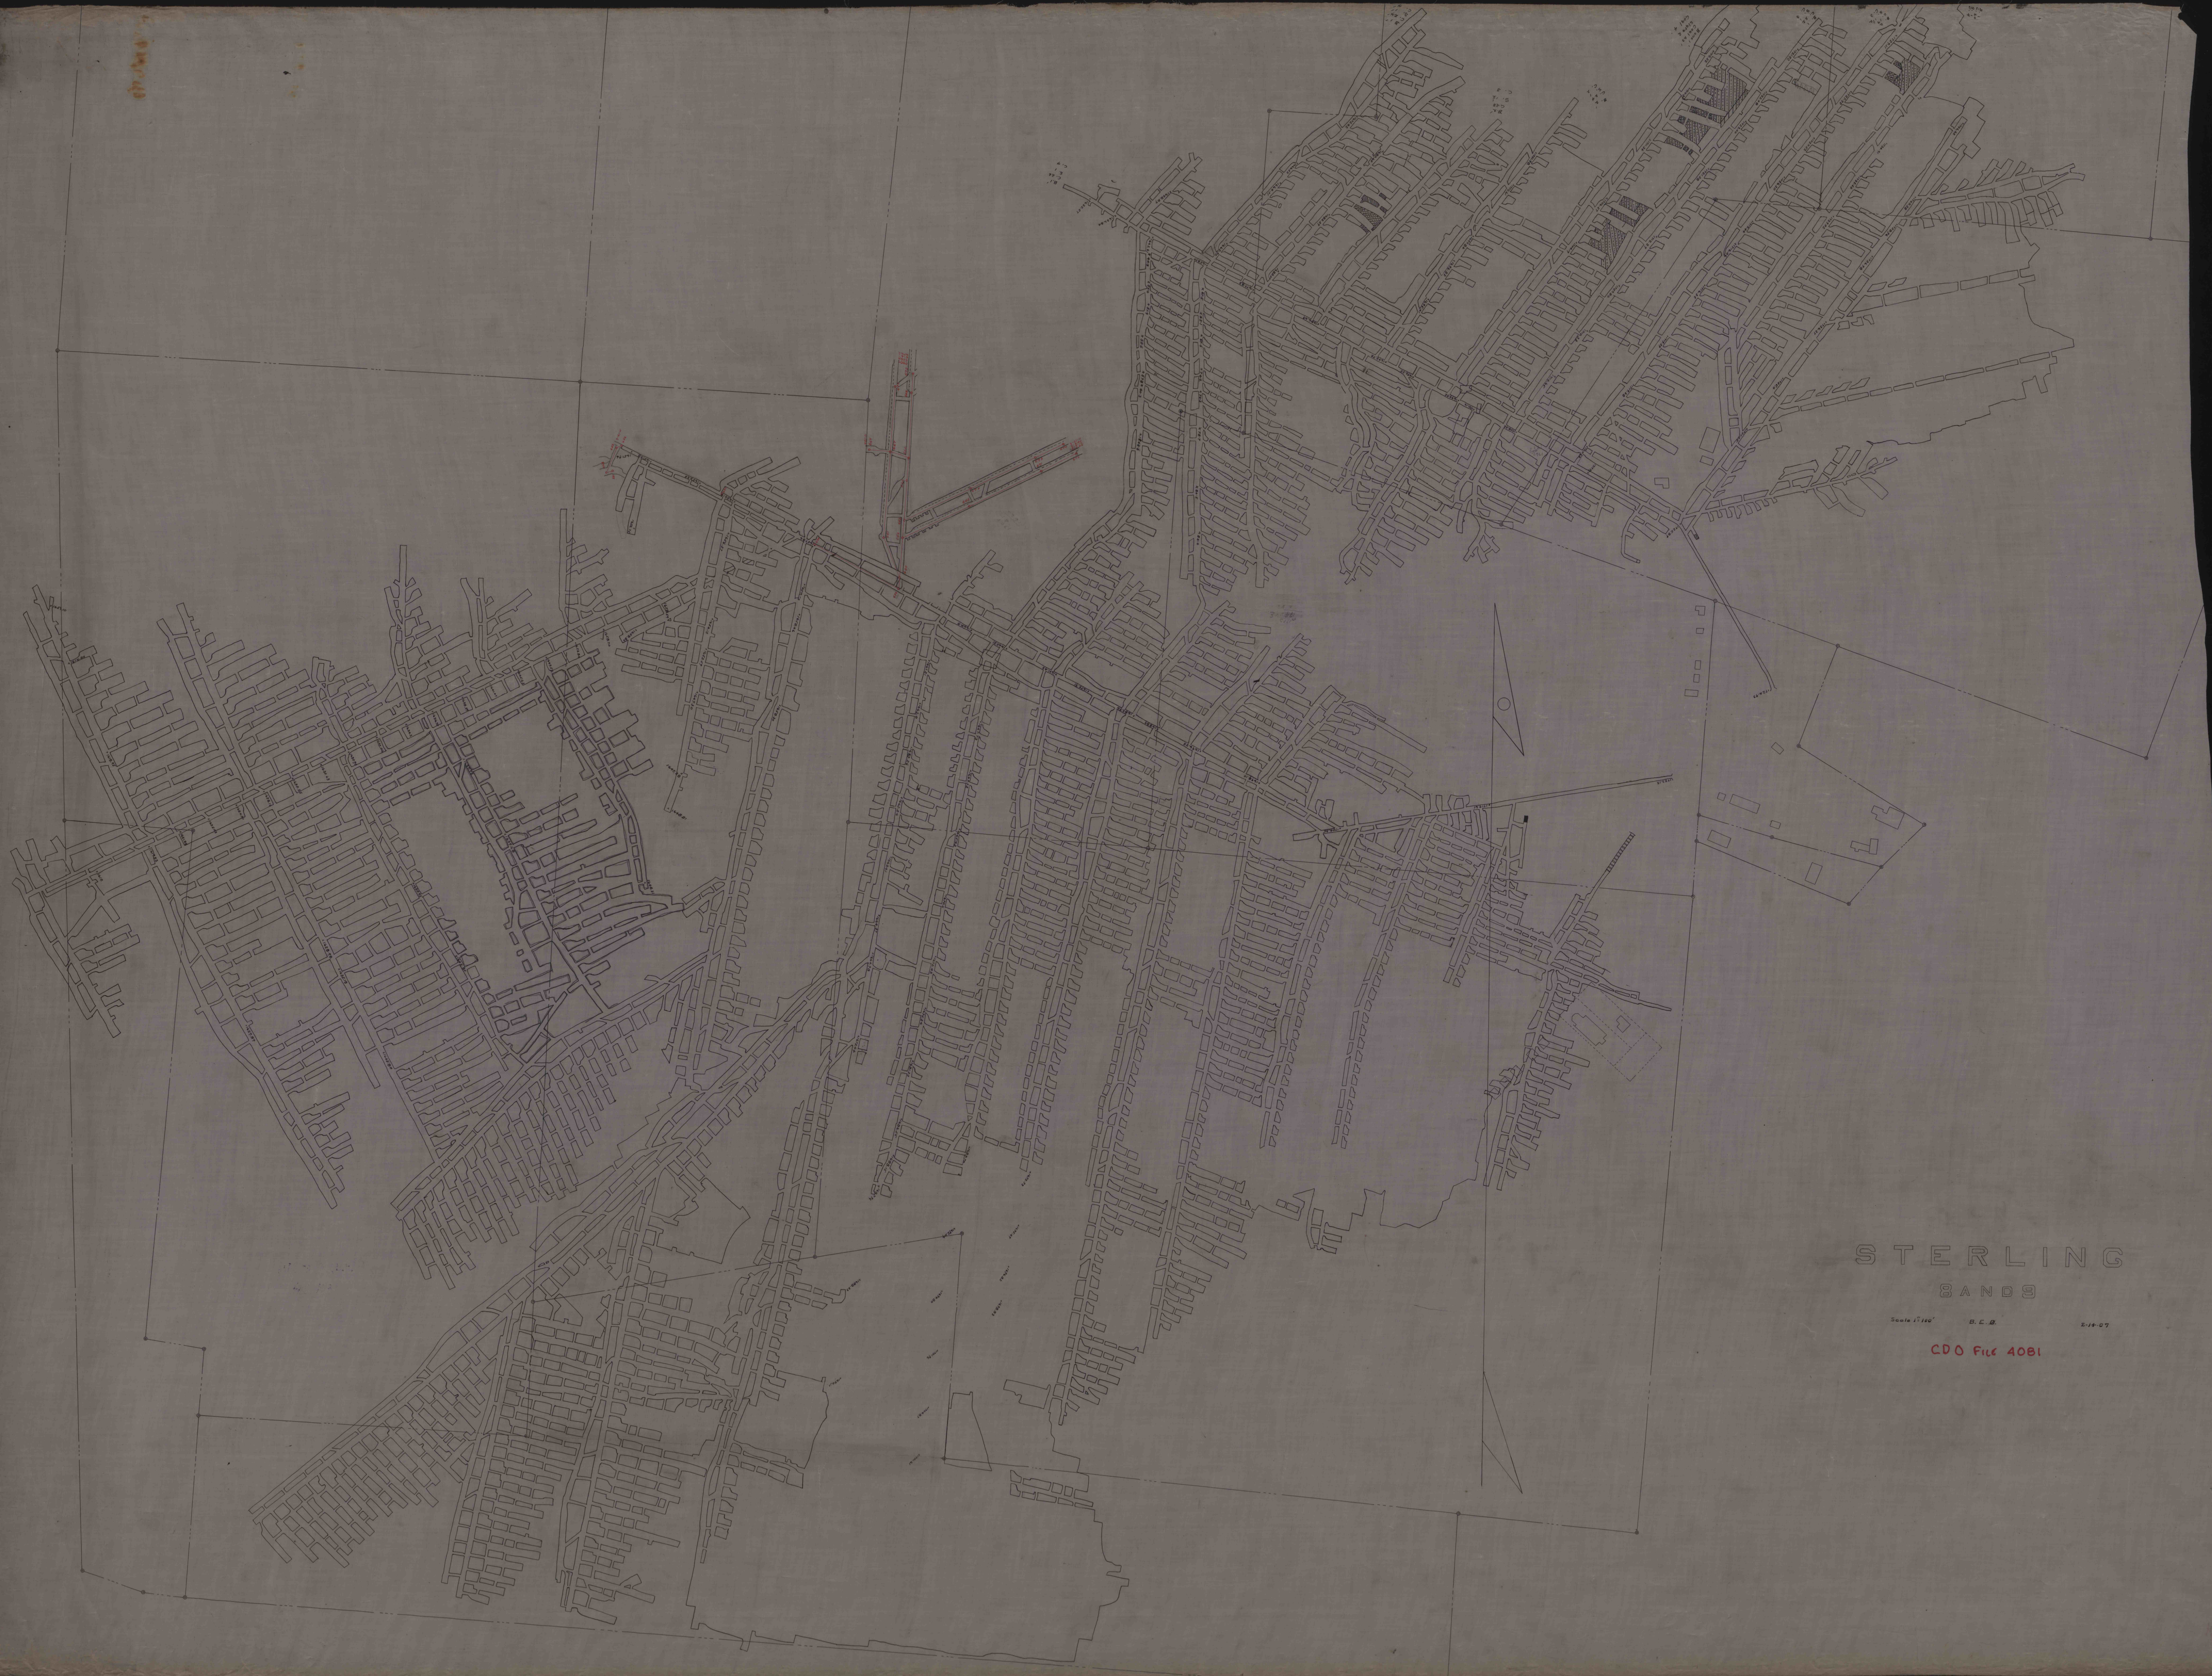

STERLING
SANDS

Scale 1"=100' B. C. D. 2-19-07

CDO File 4081