


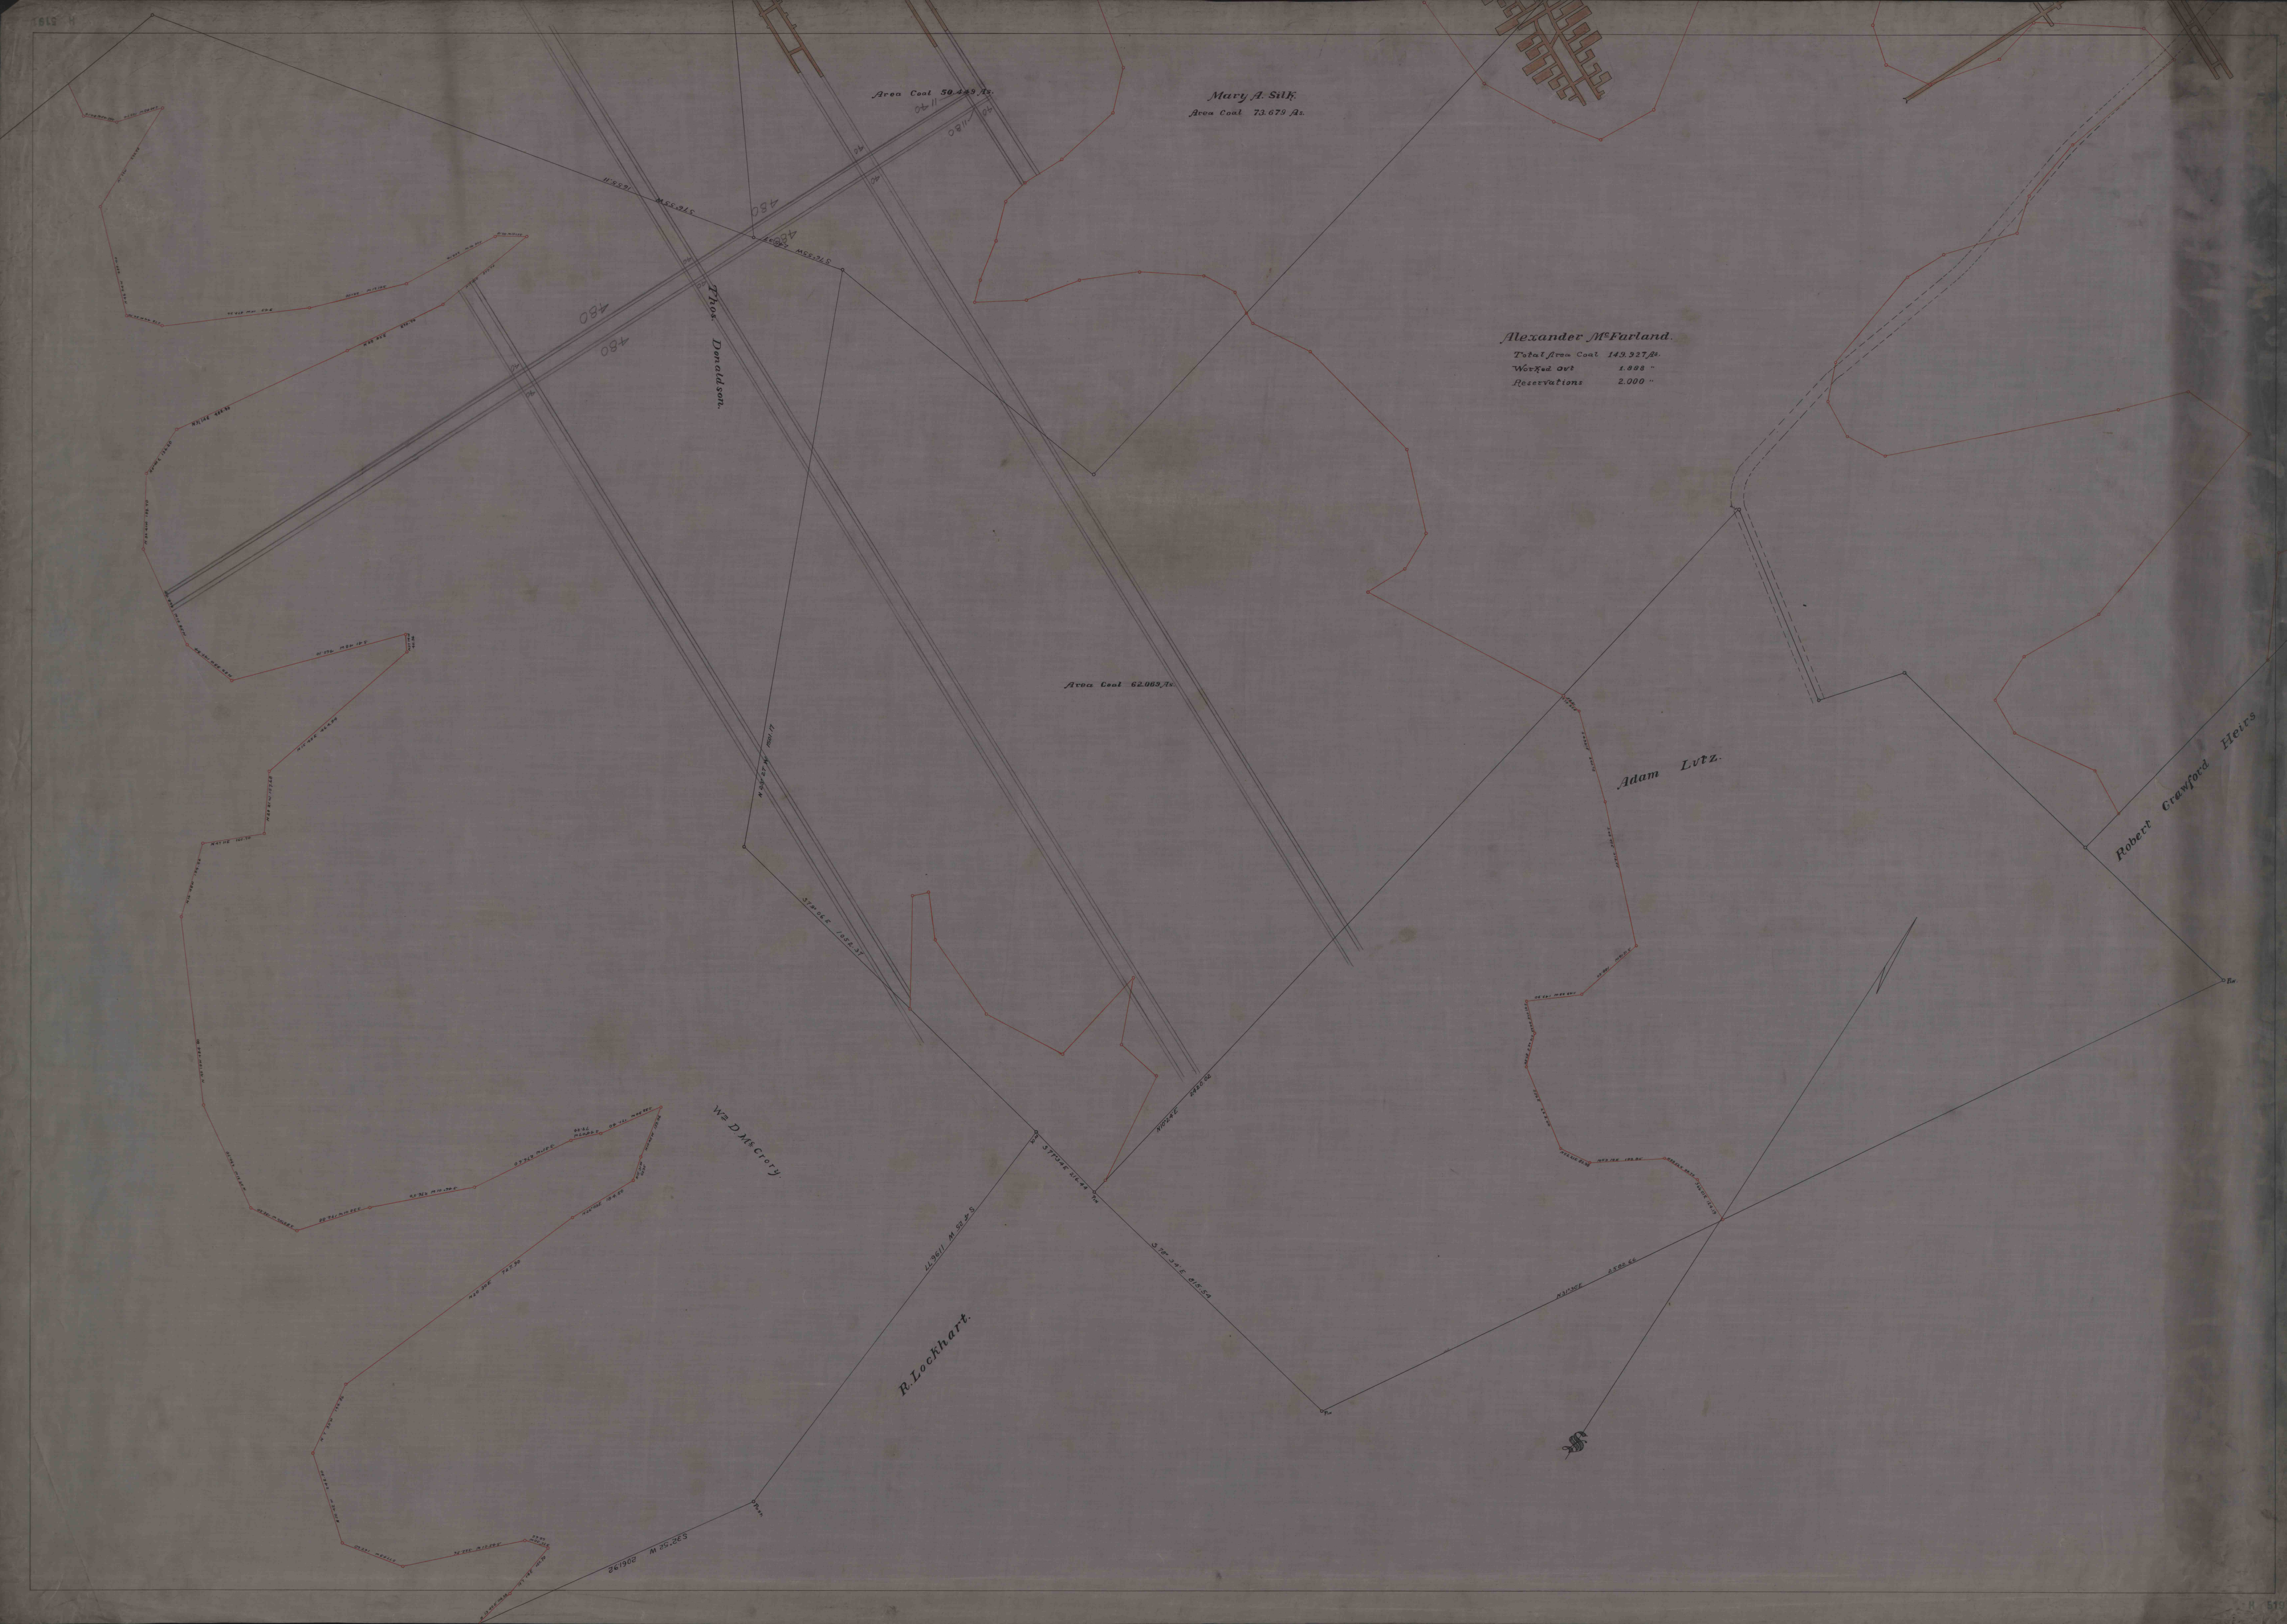

Area Cont 50.423 A.
07 11 06

Mury A. Silk.
Area Cont 73.674 A.

Alexander M. Farland.
Total Area Cont 149.927 A.
Worked Out 1.888 "
Reservations 2.000 "

Thos. Donaldson.

Area Cont 62.009 A.

Adam Lutz.

Robert Crawford Heirs

Wm D. McCree.

R. Lockhart.

