H5197 N

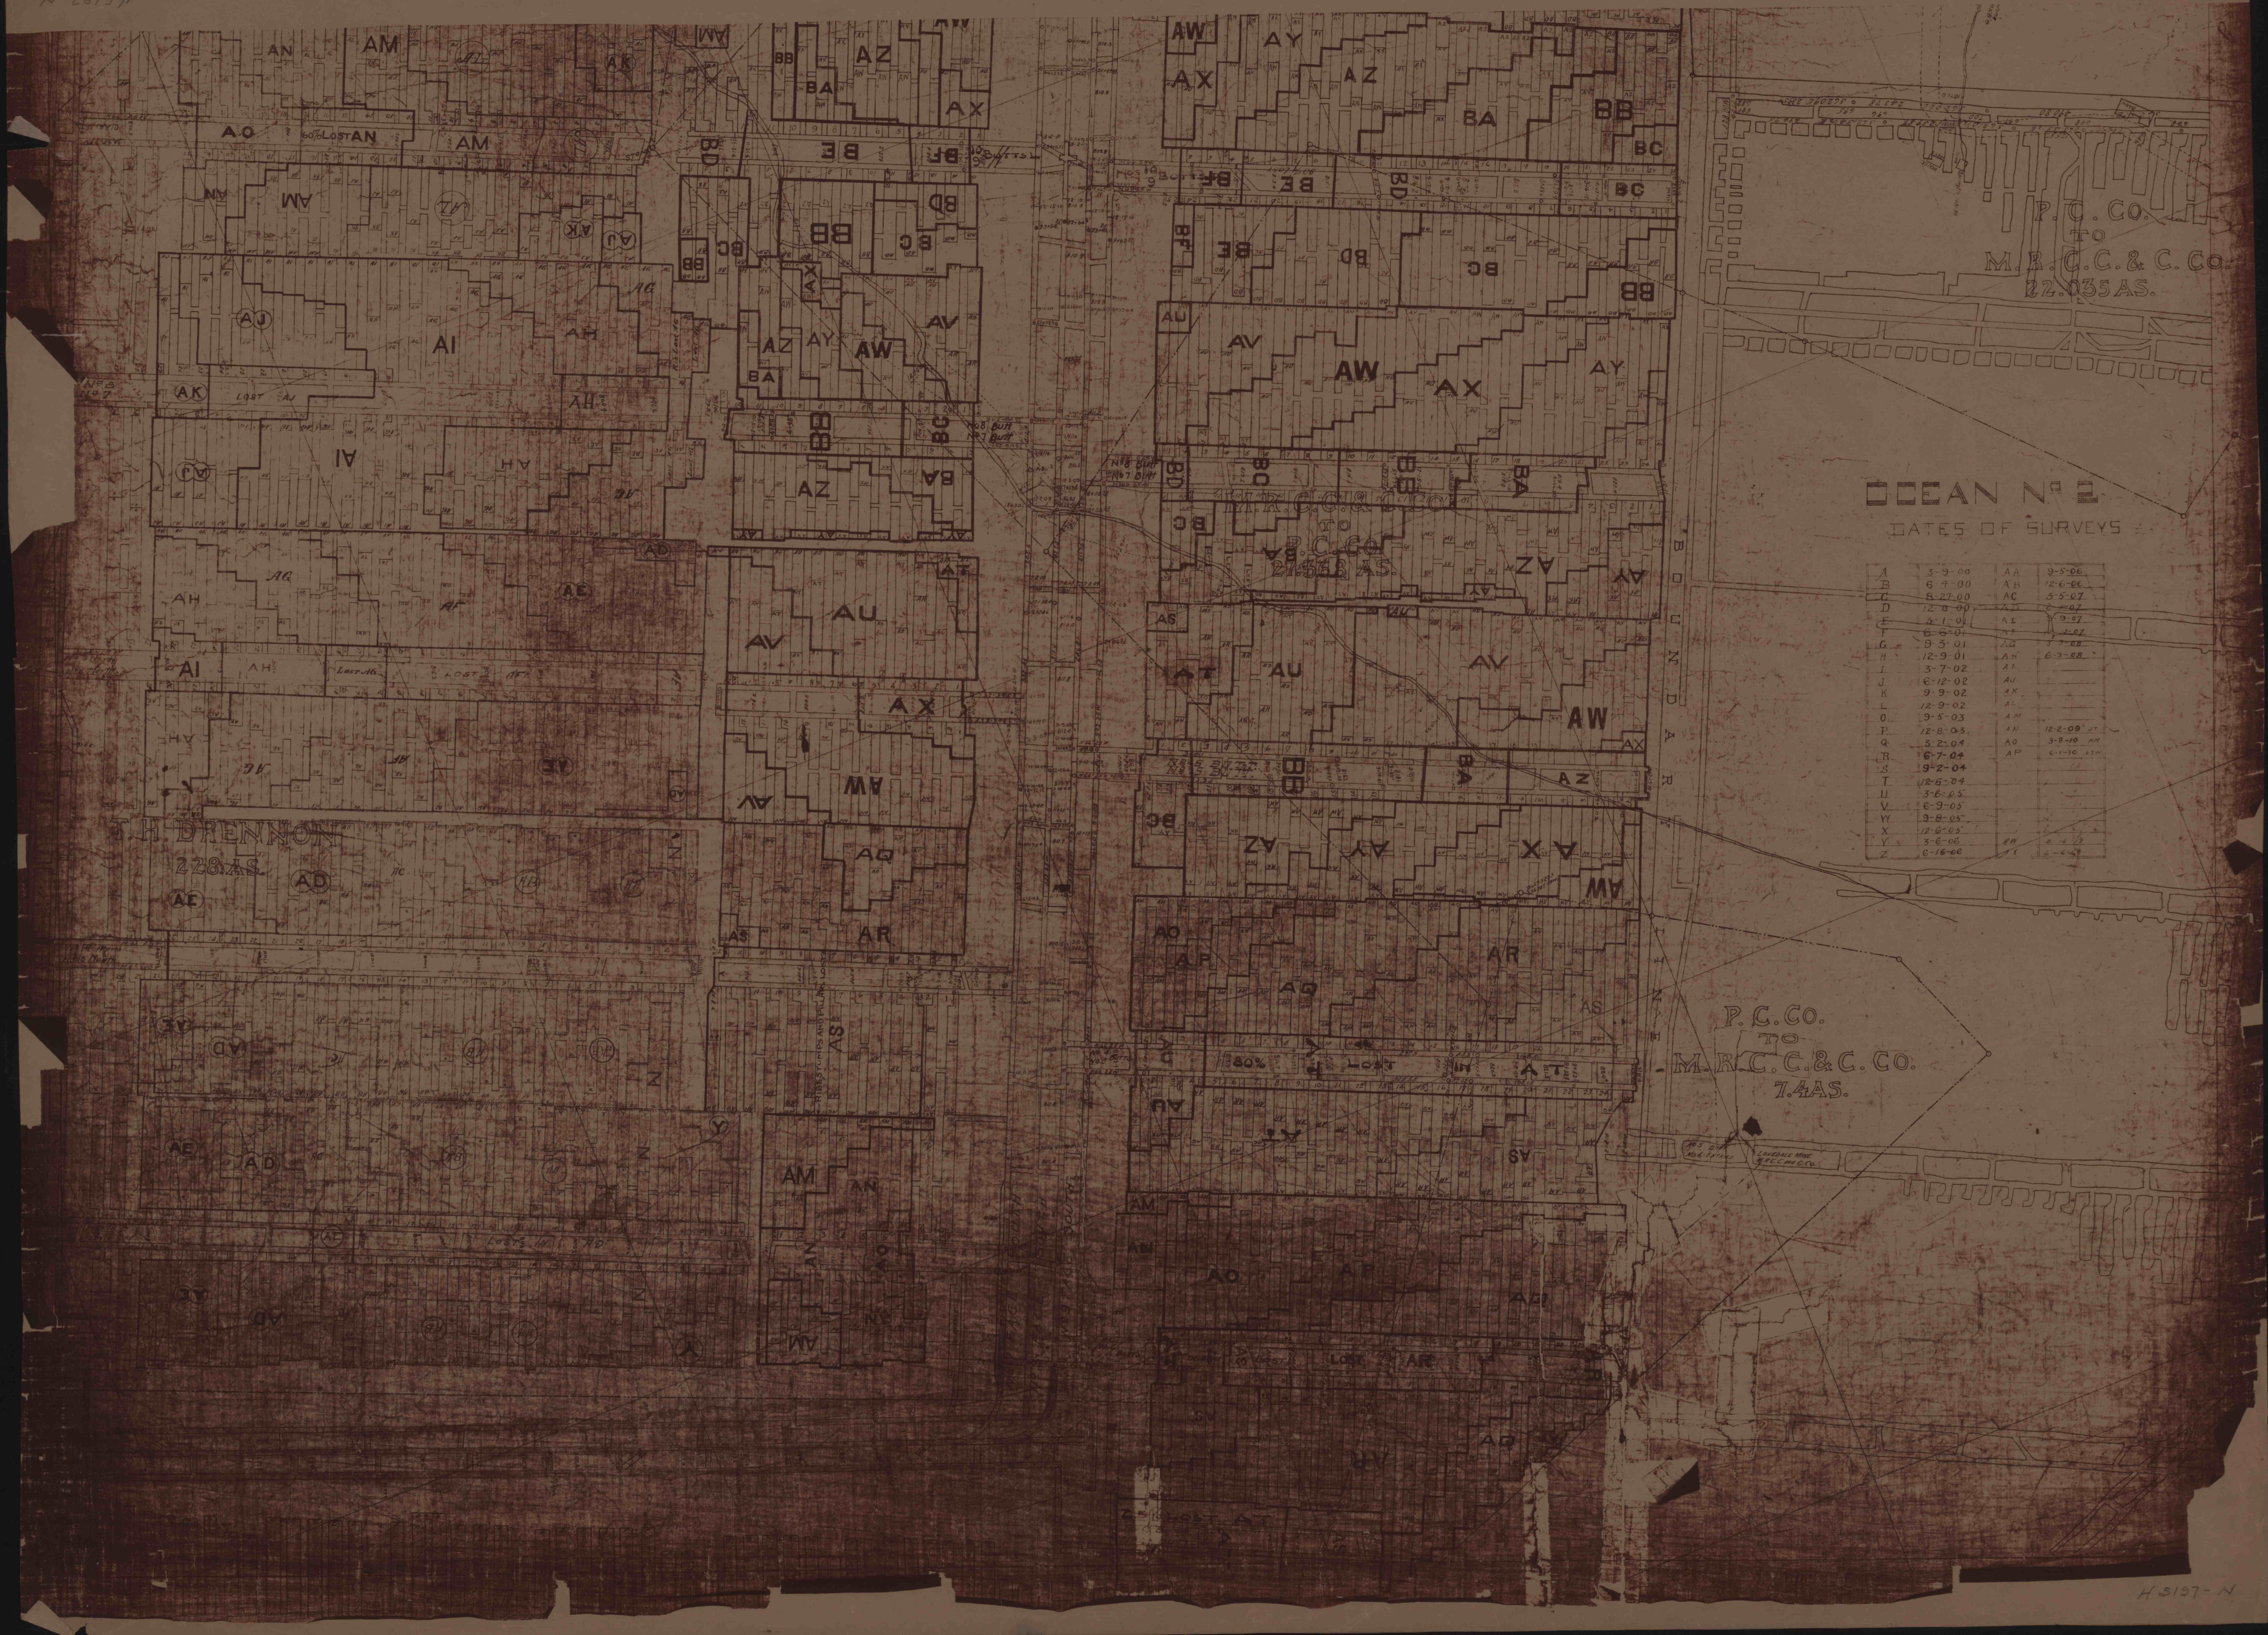

OCEAN No 2

DATES OF SURVEYS

A	3-9-00	AA	9-5-06
B	6-4-00	AB	12-6-06
C	8-27-00	AC	3-5-07
D	12-8-00	AD	6-6-07
E	3-1-01	AE	9-9-07
F	6-6-01	AF	12-2-07
G	9-3-01	AG	3-3-08
H	12-9-01	AH	6-3-08
I	3-7-02	AI	
J	6-12-02	AJ	
K	9-9-02	AK	
L	12-9-02	AL	
O	9-5-03	AM	
P	12-8-03	AN	12-2-09 J.T.
Q	3-2-04	AO	3-8-10 H.M.
R	6-7-04	AP	6-1-10 E.T.W.
S	9-2-04		
T	12-5-04		
U	3-6-05		
V	6-9-05		
W	9-8-05		
X	12-6-05		
Y	3-6-06	AW	3-16-17
Z	6-16-06	AX	6-6-17

H-5197-N