


H-5204 S

FIT TO H-5406 E

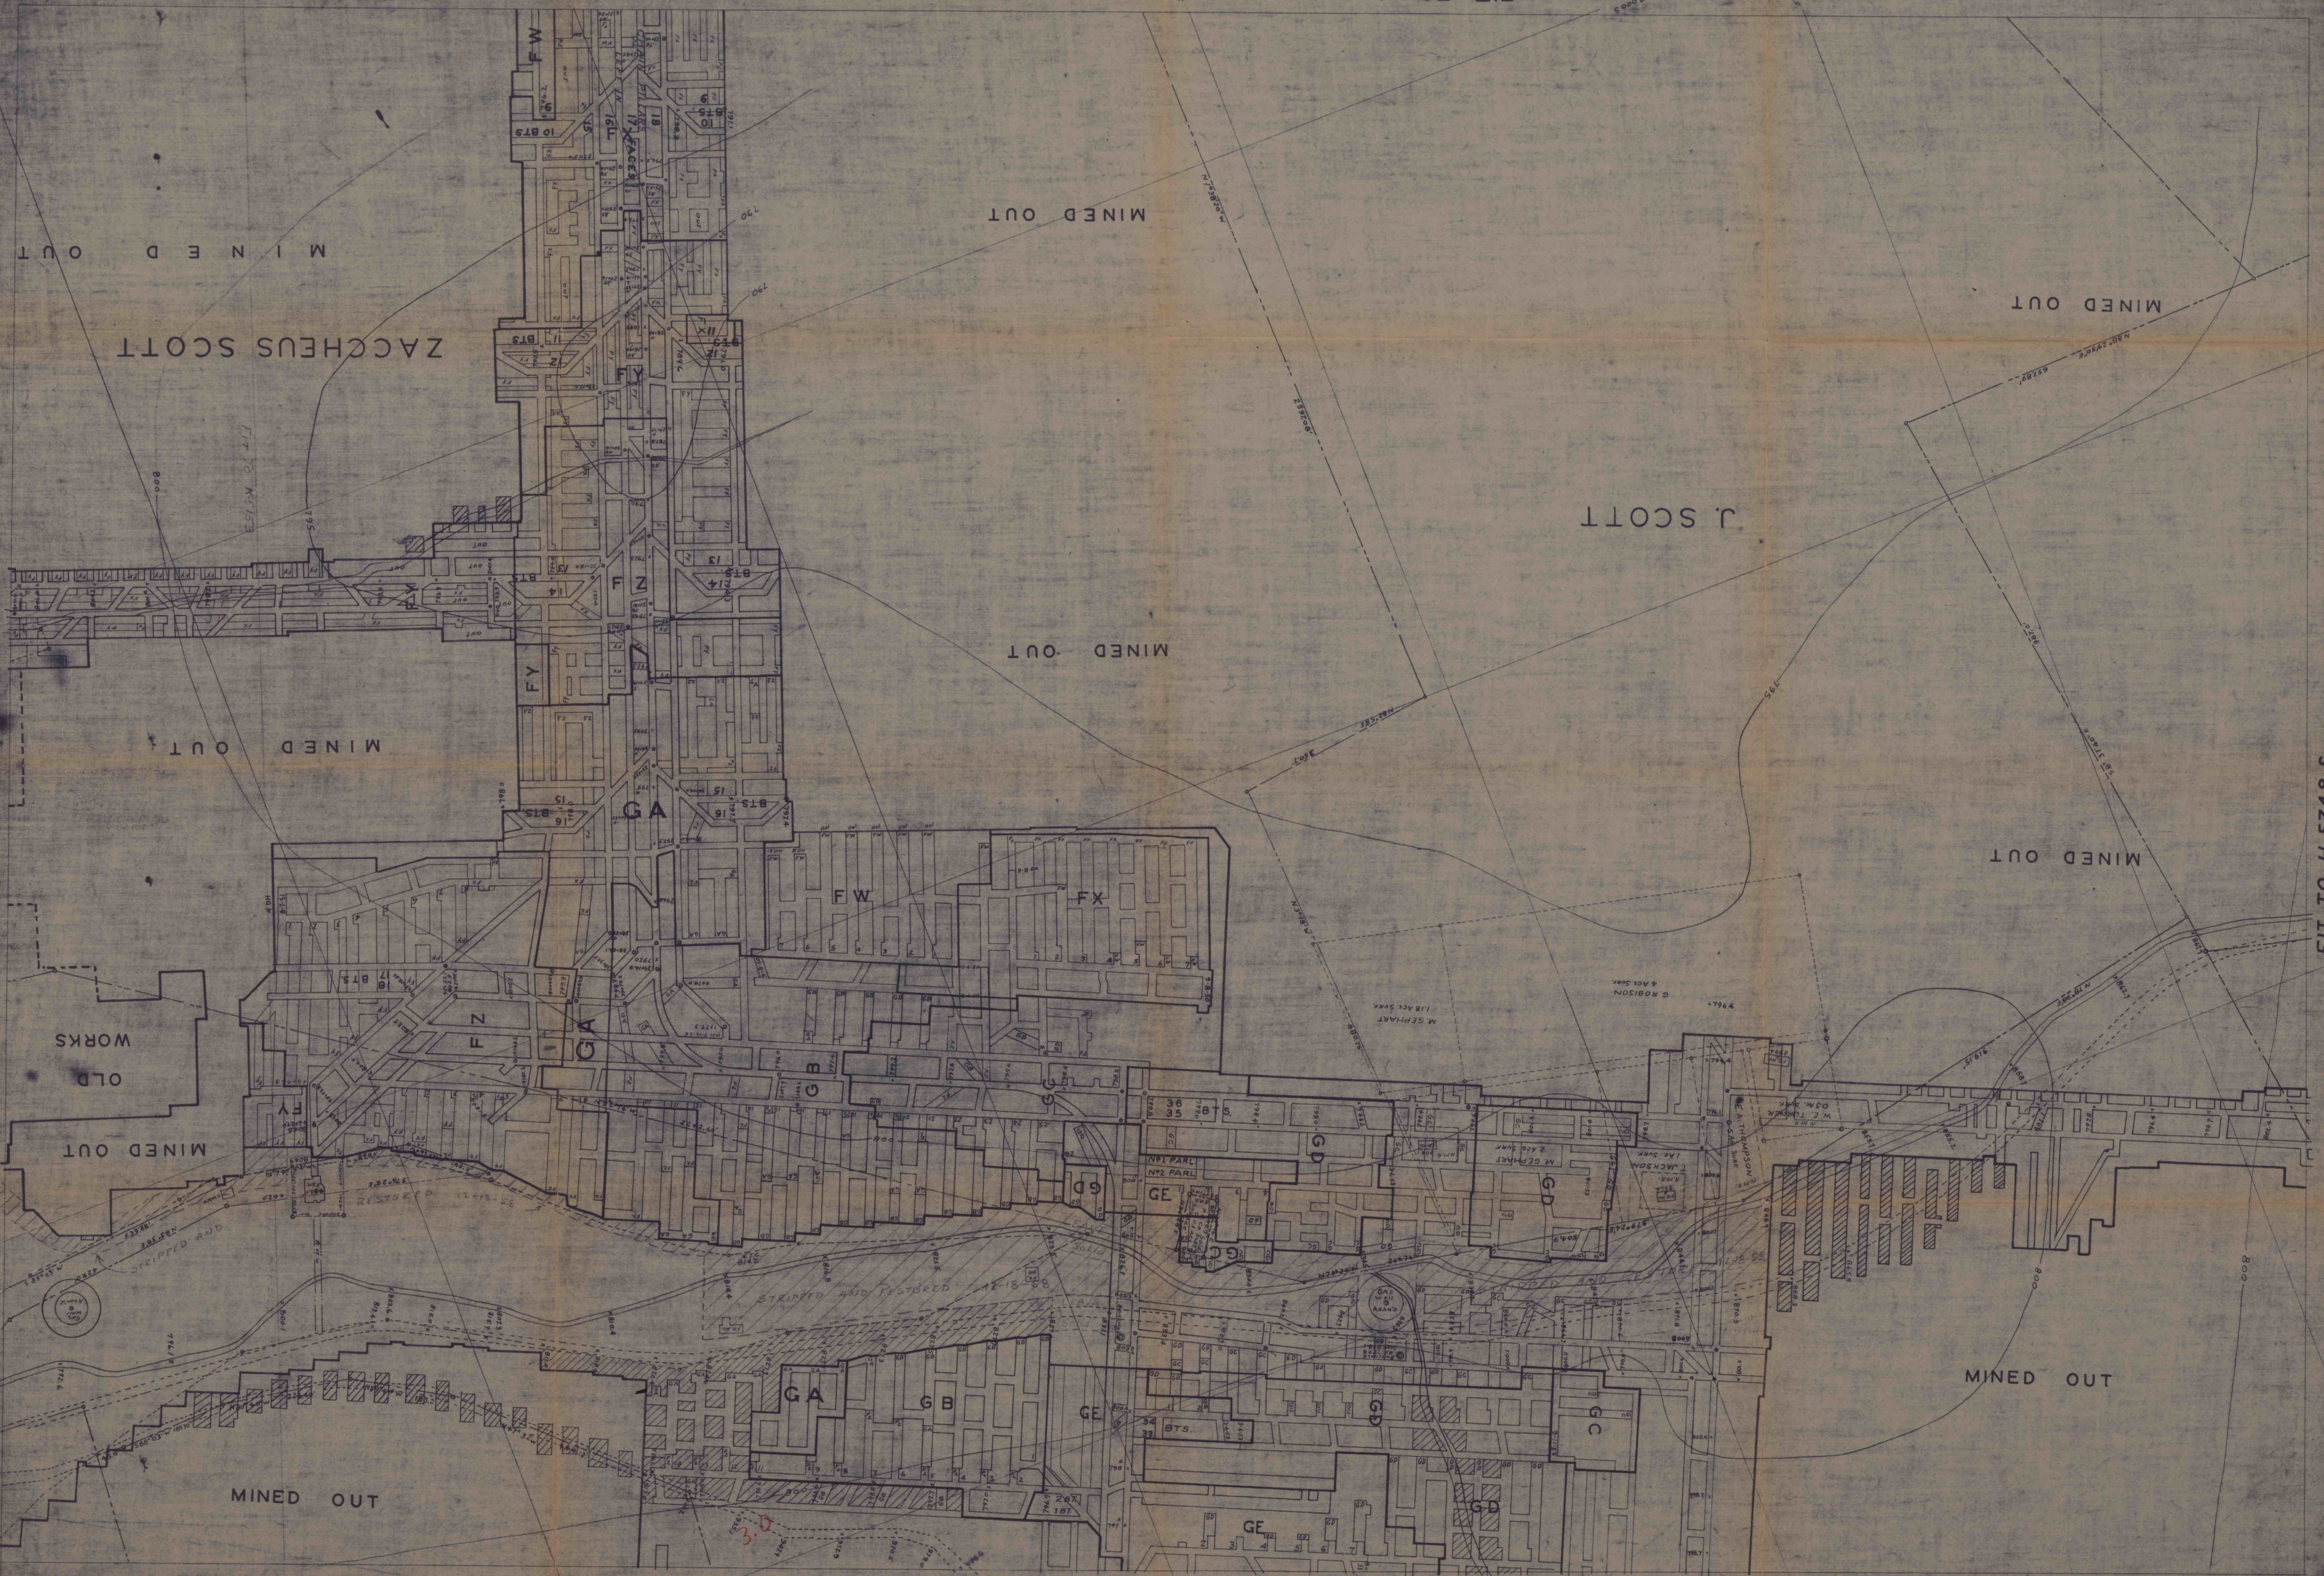

FIT TO H-5204 N

H-5204 S

FIT TO H-5348 S