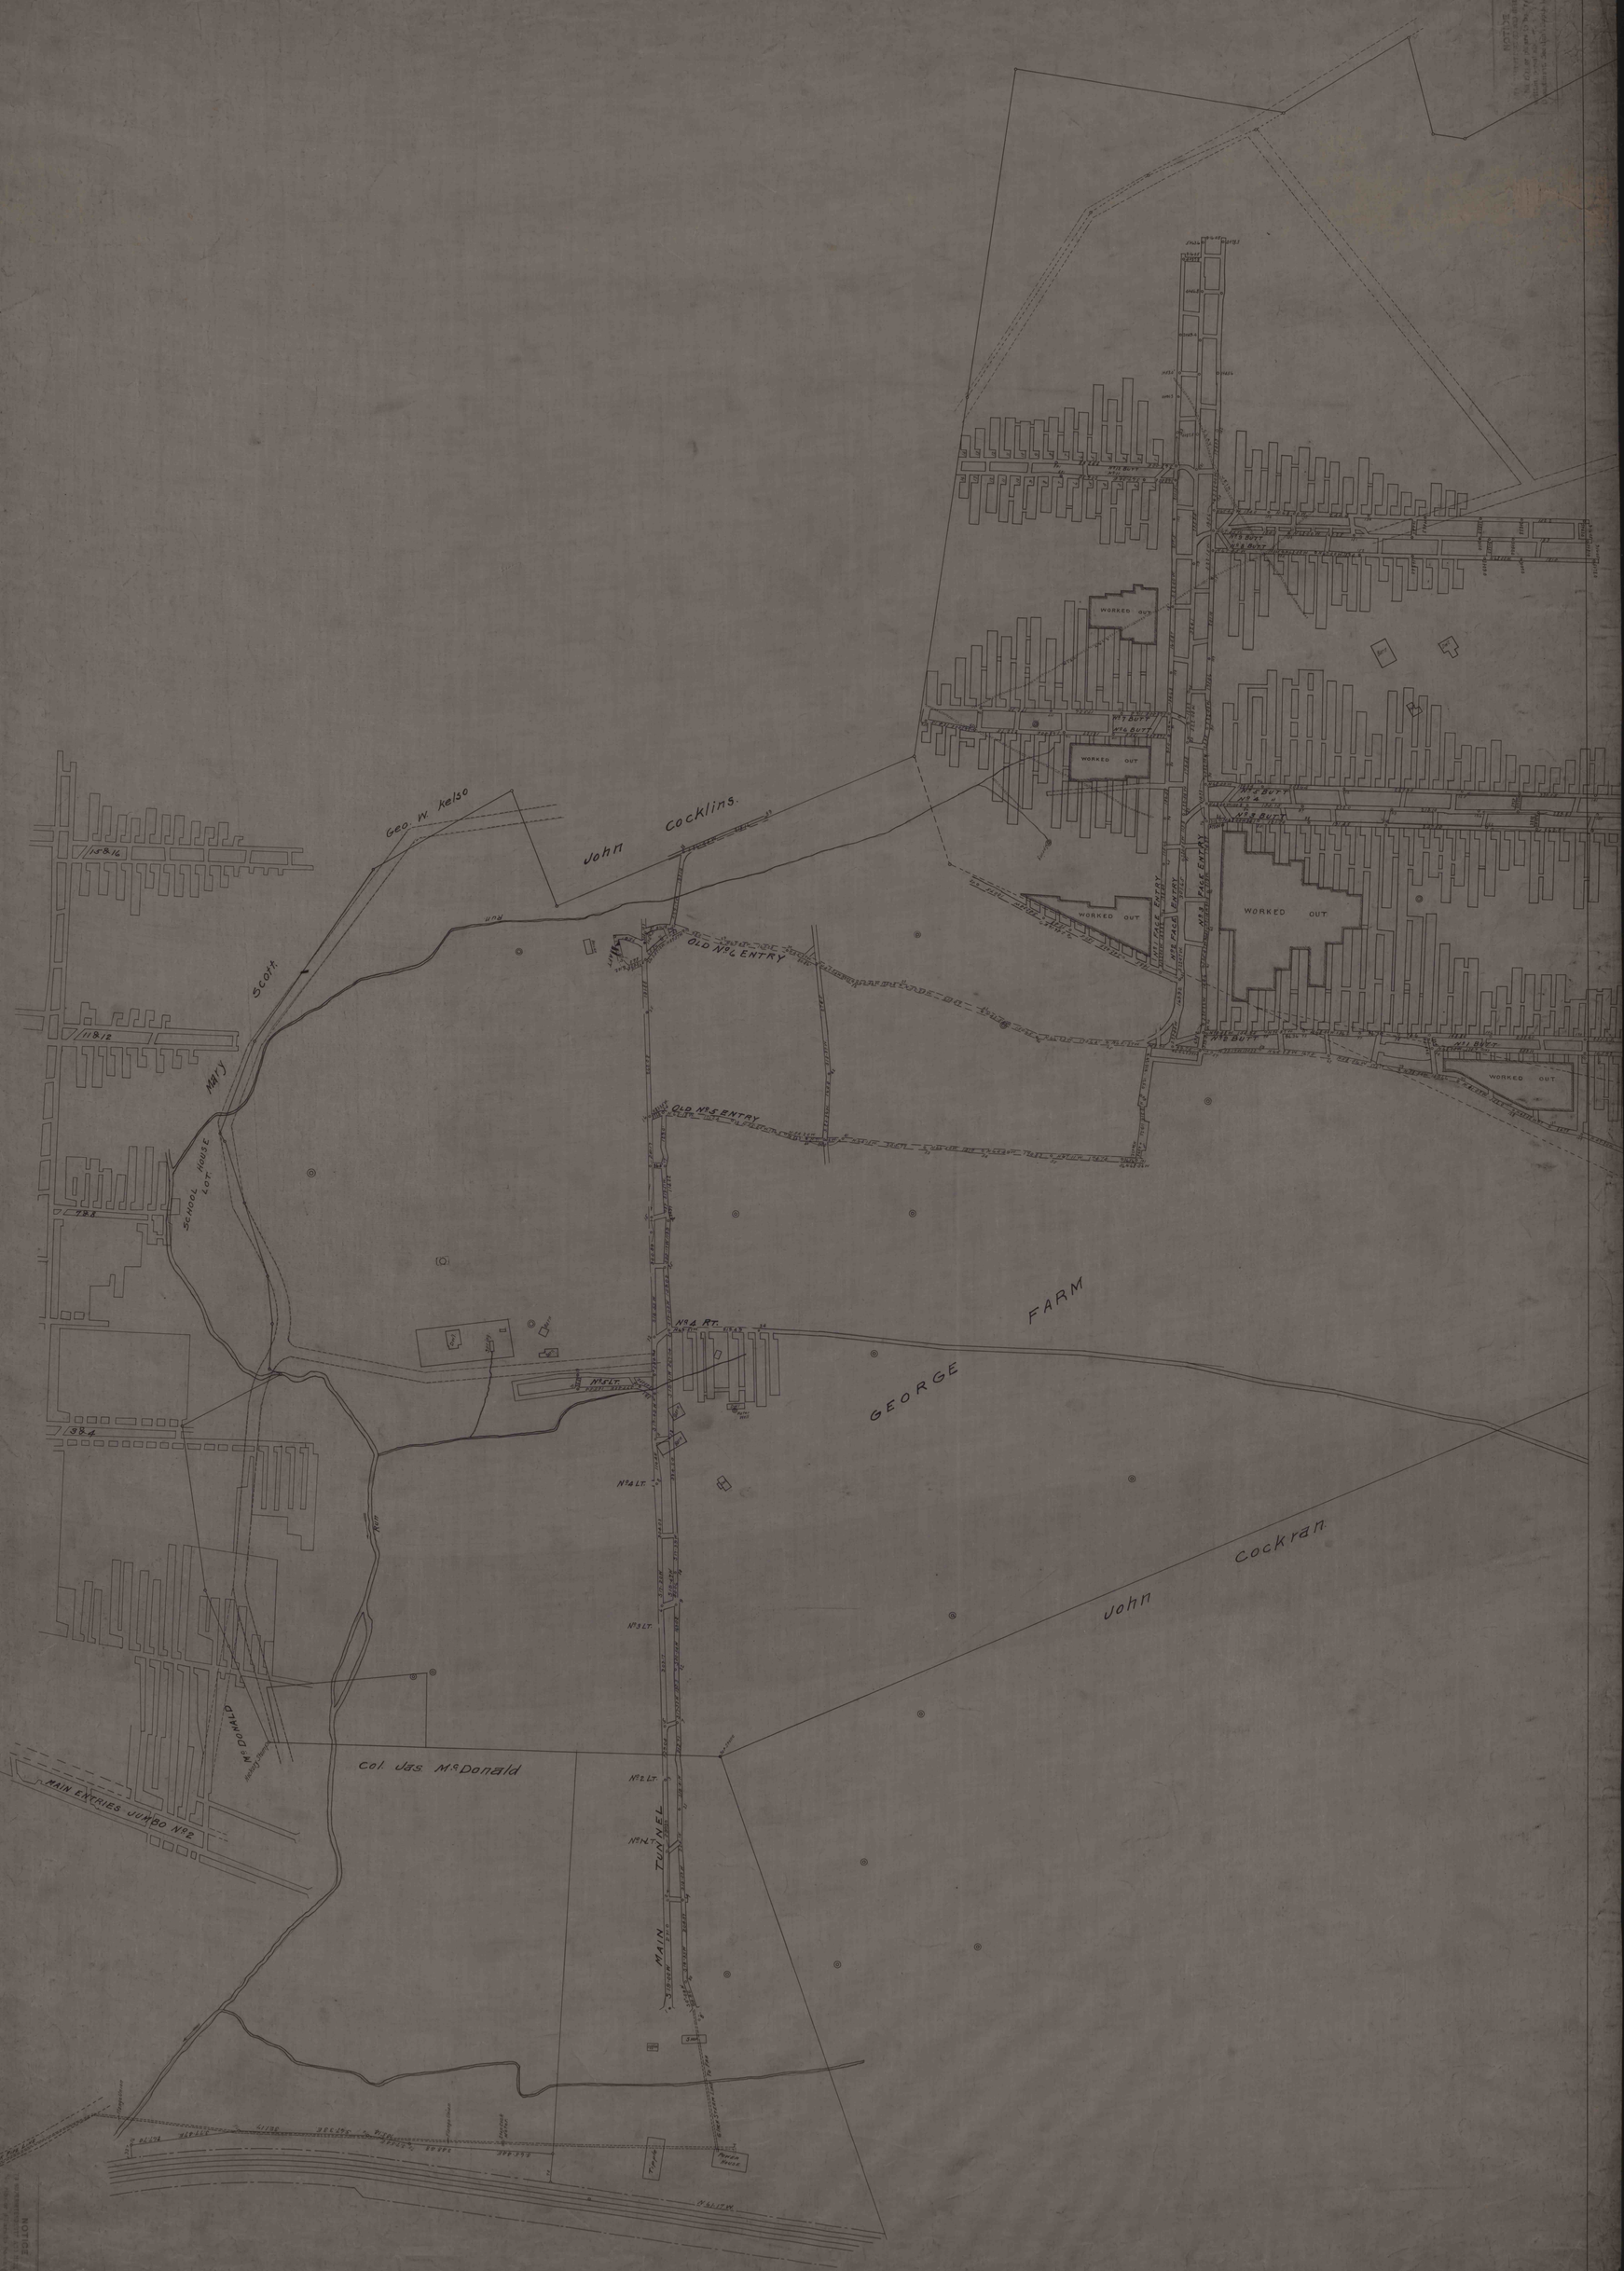
Geo. W. Kelso
John Cocklins.
Scott
Mary
SCHOOL HOUSE LOT
OLD No 6 ENTRY
OLD No 5 ENTRY
WORKED OUT
No 5 BUTT
No 4 BUTT
No 3 BUTT
No 2 BUTT
No 1 BUTT
No 4 PASS ENTRY
No 3 PASS ENTRY
No 2 PASS ENTRY
No 1 PASS ENTRY
No 4 RT.
No 4 LT.
No 3 LT.
No 2 LT.
No 1 LT.
MAIN TUNNEL
GEORGE FARM
John Cockran
Col Jas McDonald
McDONALD
MAIN ENTRIES JUMBO No 2
NOTICE