


574

U.S. GOVERNMENT PRINTING OFFICE
1964 O - 348-101-1
5010-101-1

FIT TO H 6234

NOTICE

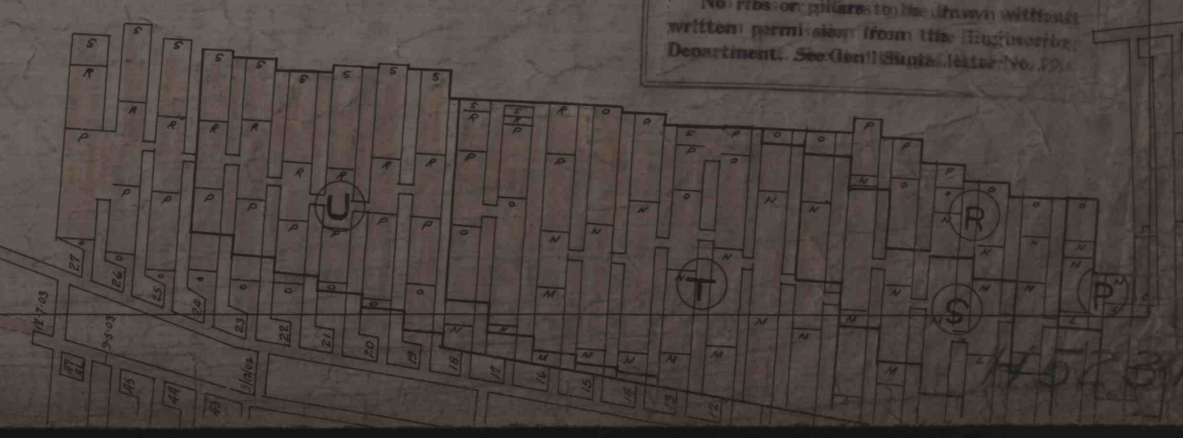

FIT TO H 5233