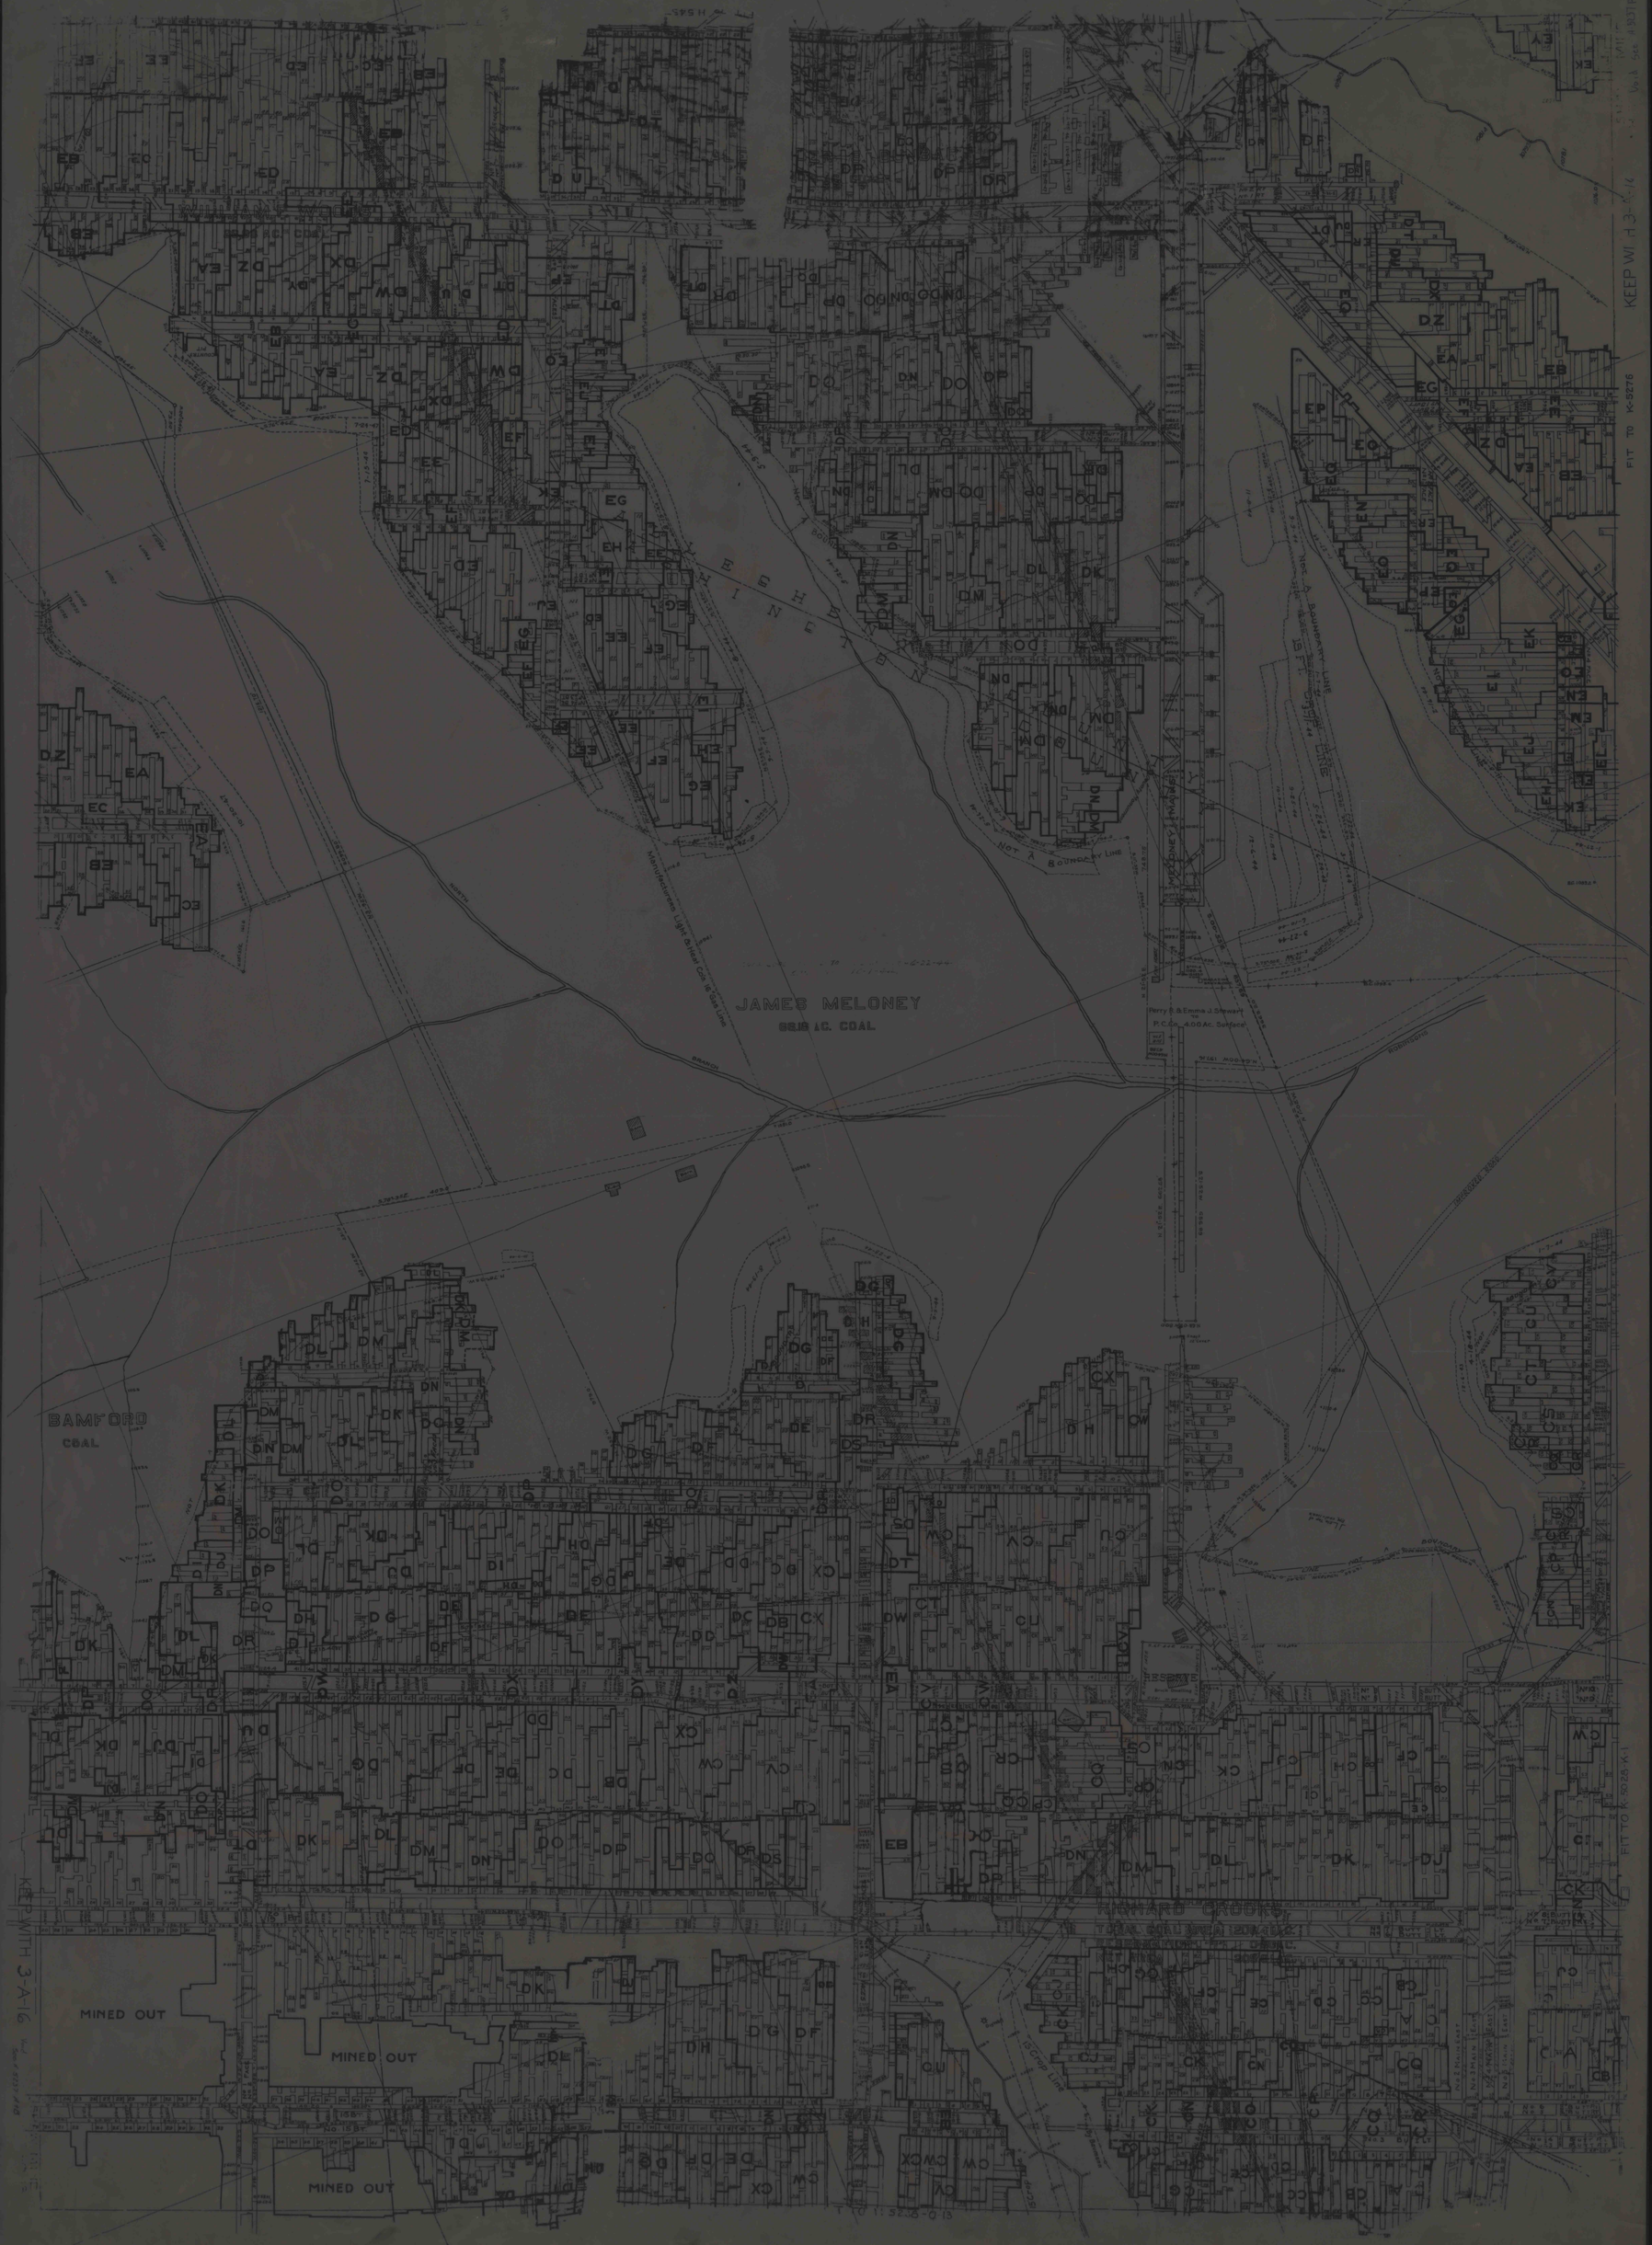
JAMES MELONEY
SEAM COAL
BAMFORD
COAL
MINED OUT
MINED OUT
MINED OUT
RICHARD BROOKS
Manufacturers Light & Heat Co. & Gas Line
Perry R. & Emma J. Stewart
P.C.Co. 4.00 Ac. Surface
KEEP WITH 3-A-16
FIT TO K-9276