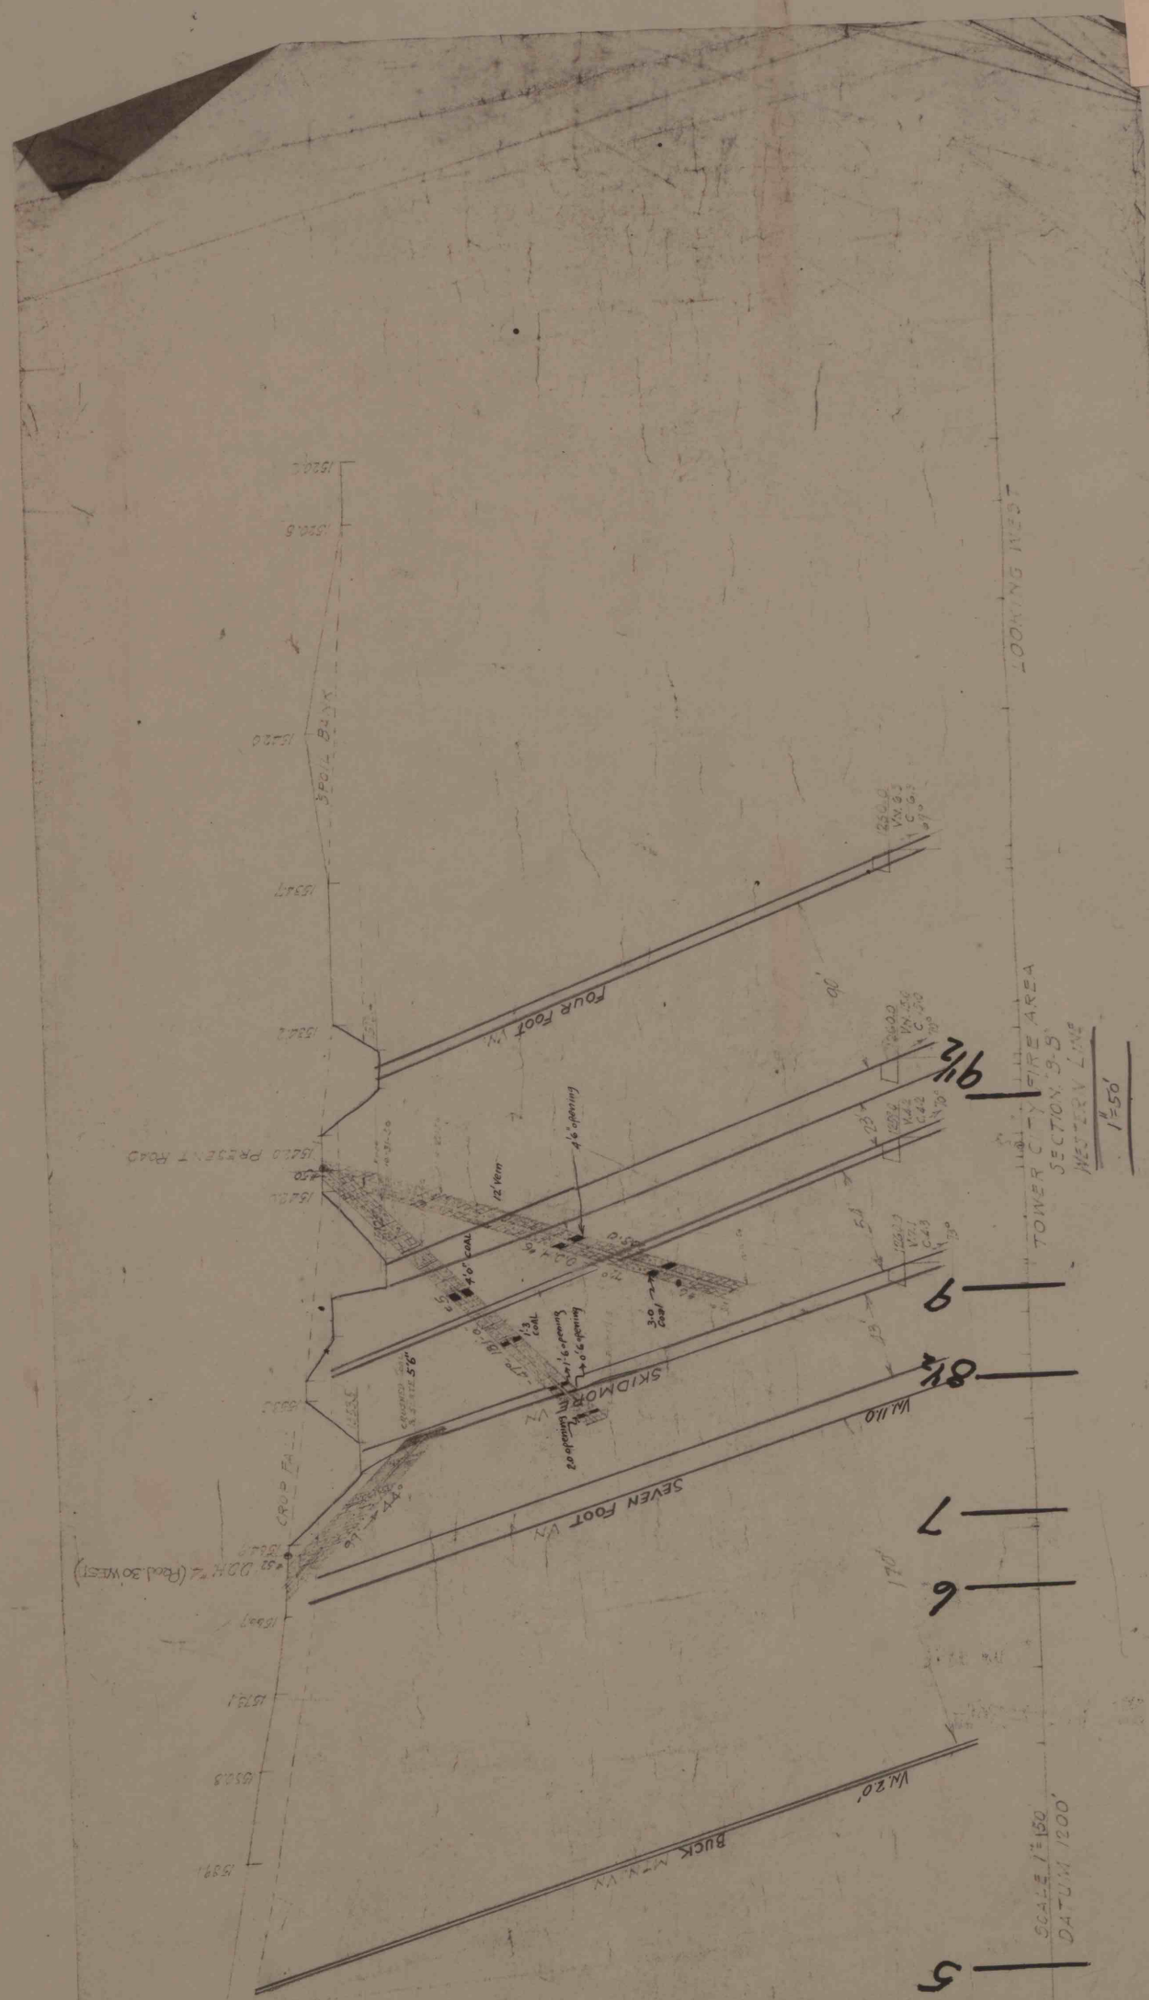
Tower City Colly
Section 'B'
Anthracite Southern
Field
Pottsville Tun - Sec. G
Scale: 1" = 50'
U3
1" = 50'
5
6
7
8½
9
9½
Buck Mtn. Vn
Vn 20'
Seven Foot Vn
Vn 10
Skidmore
Four Foot Vn
Tower City Fire Area
Section 3-5
1" = 50'
Scale 1" = 50
Datum 1200'
Looking West
Crown Fa.
Road 30 West