
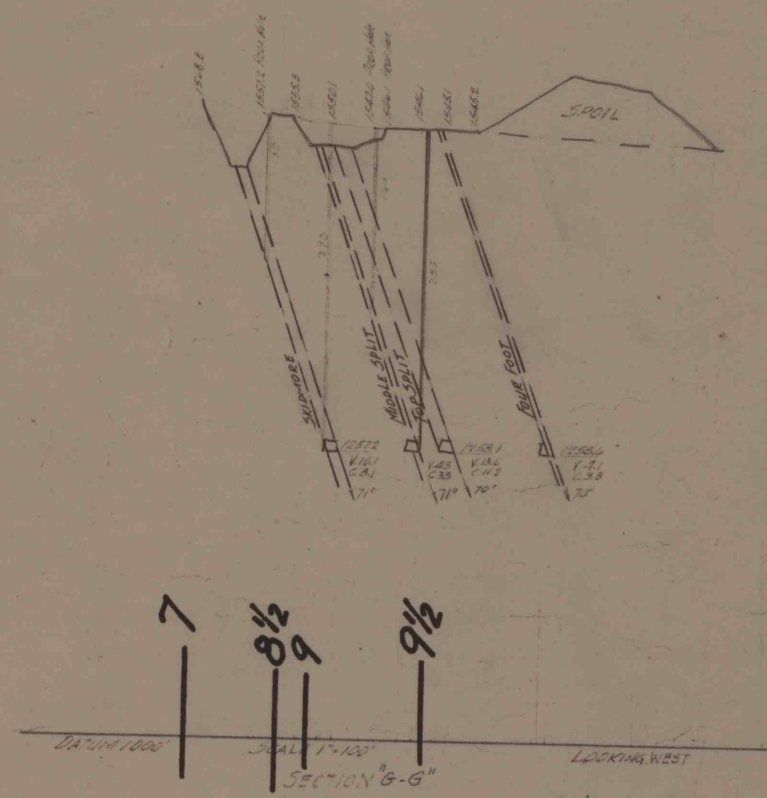


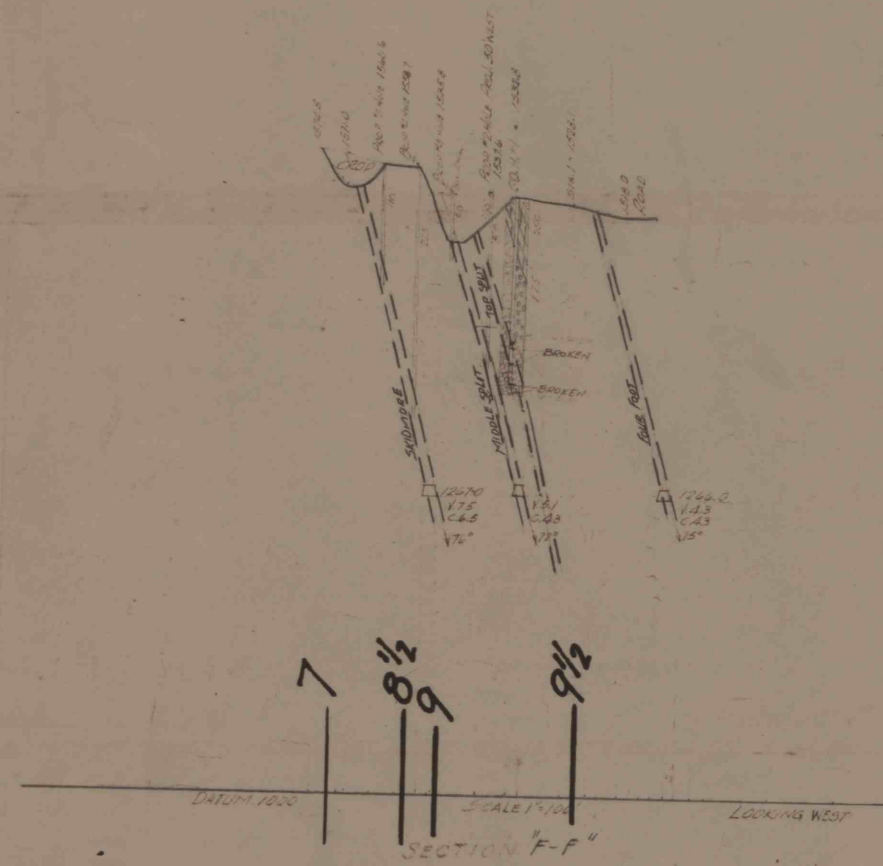

PORTER TUNNEL
#73

PORTER TUNNEL
SECTION #73
AUGUST 1916
FIELD
PORTER TUNNEL - S. 44 G
Scale: 1" = 100'