


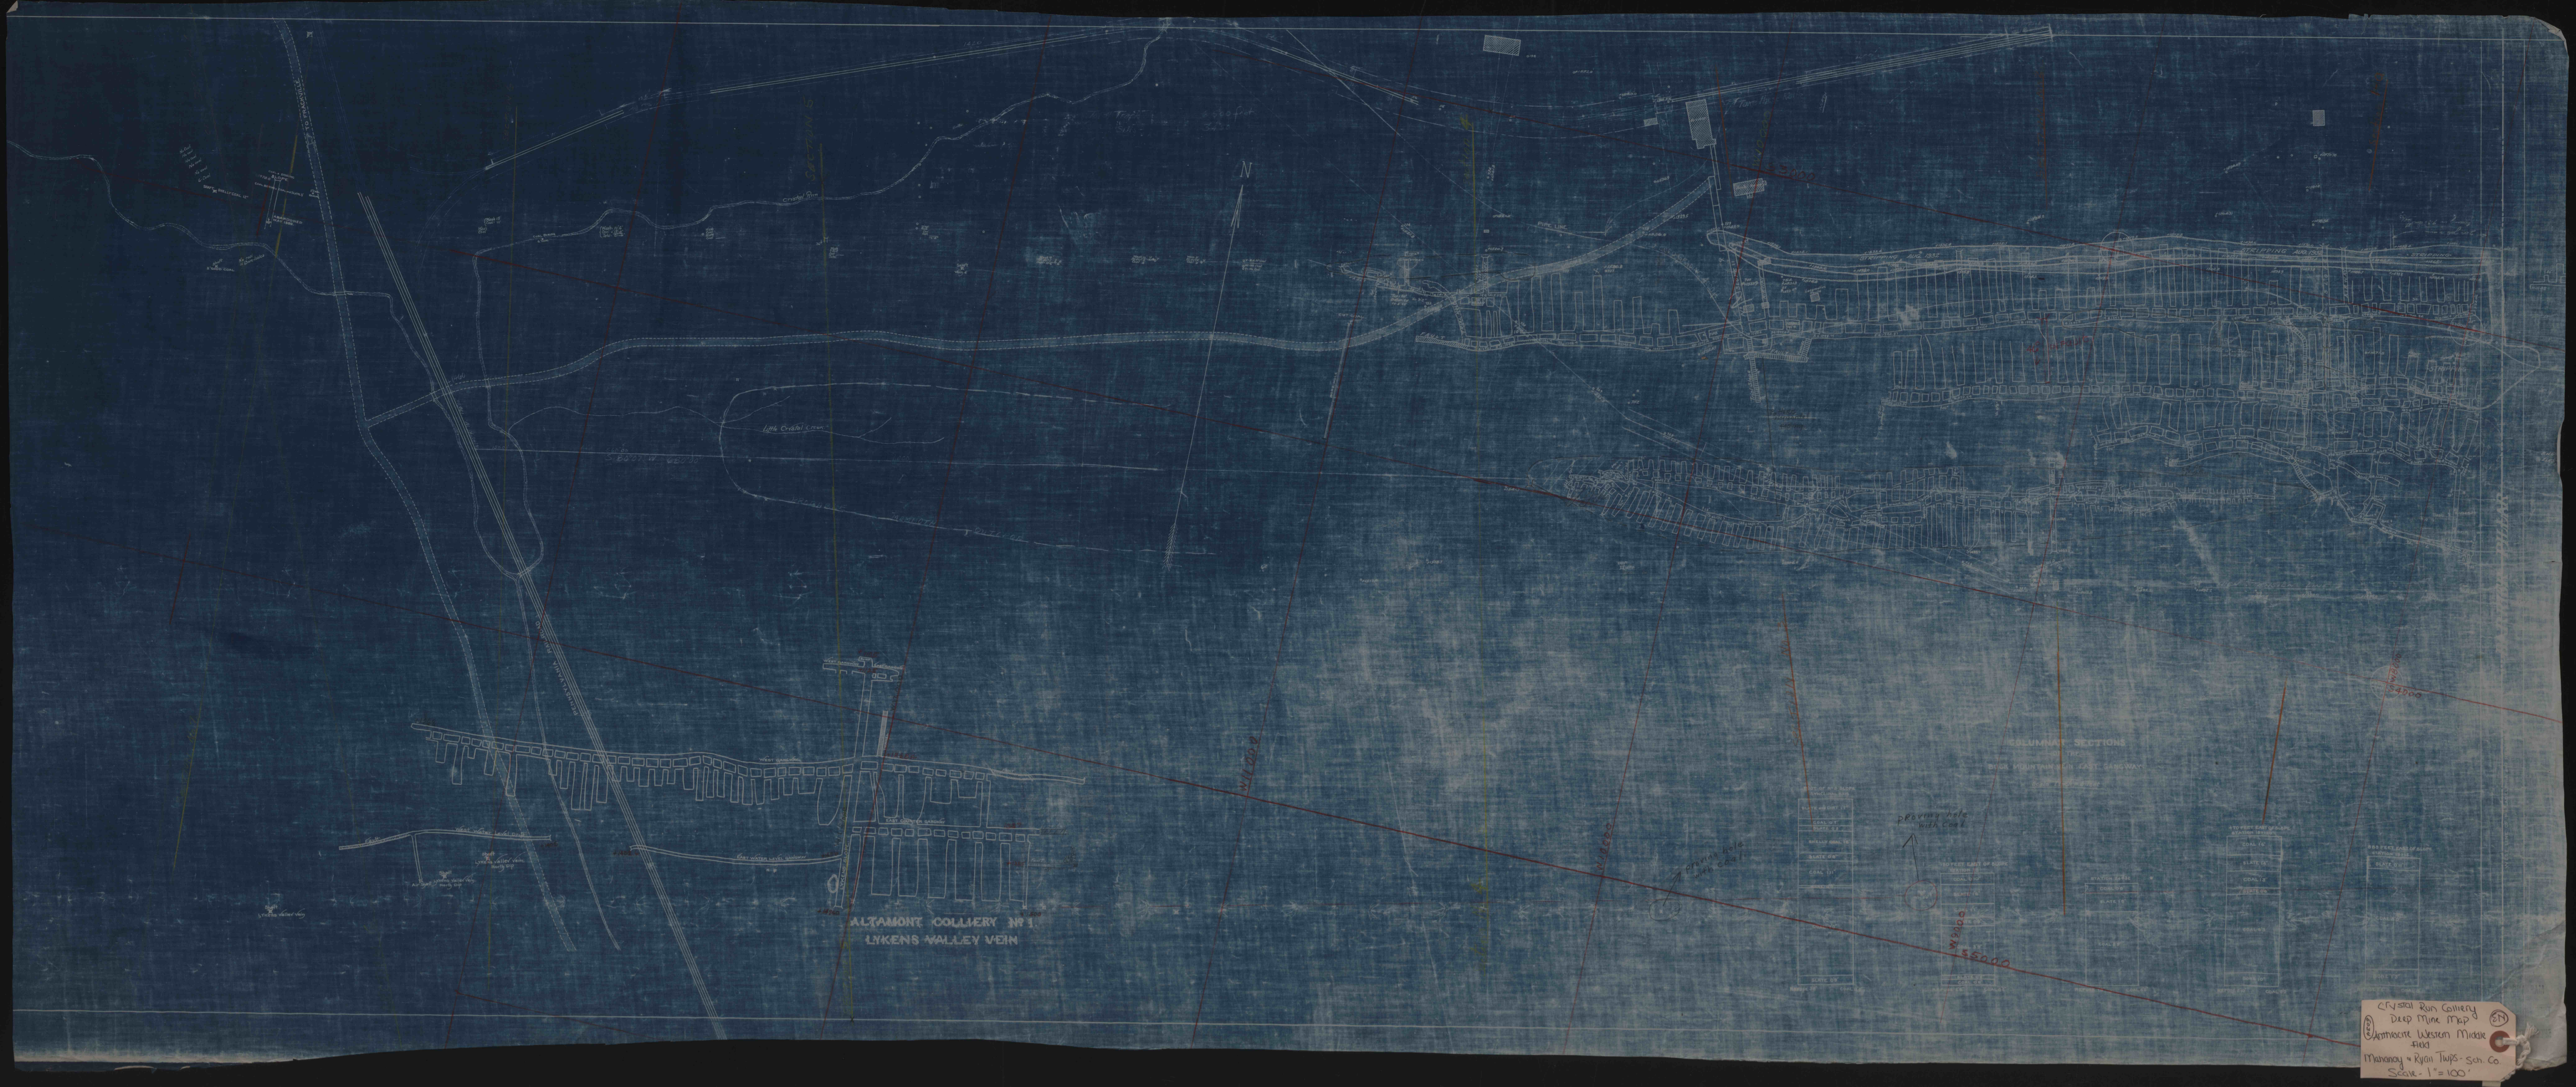

ALTAMONT COLLIERY NO. 1
LYKENS VALLEY VEIN

COLUMNAR SECTIONS
OF THE






CRYSTAL RUN COLLIERY
DEEP MINE MAP
FIELD
MAHANAH & RYAN TWP. - SCH. CO.
SCALE - 1" = 100'