


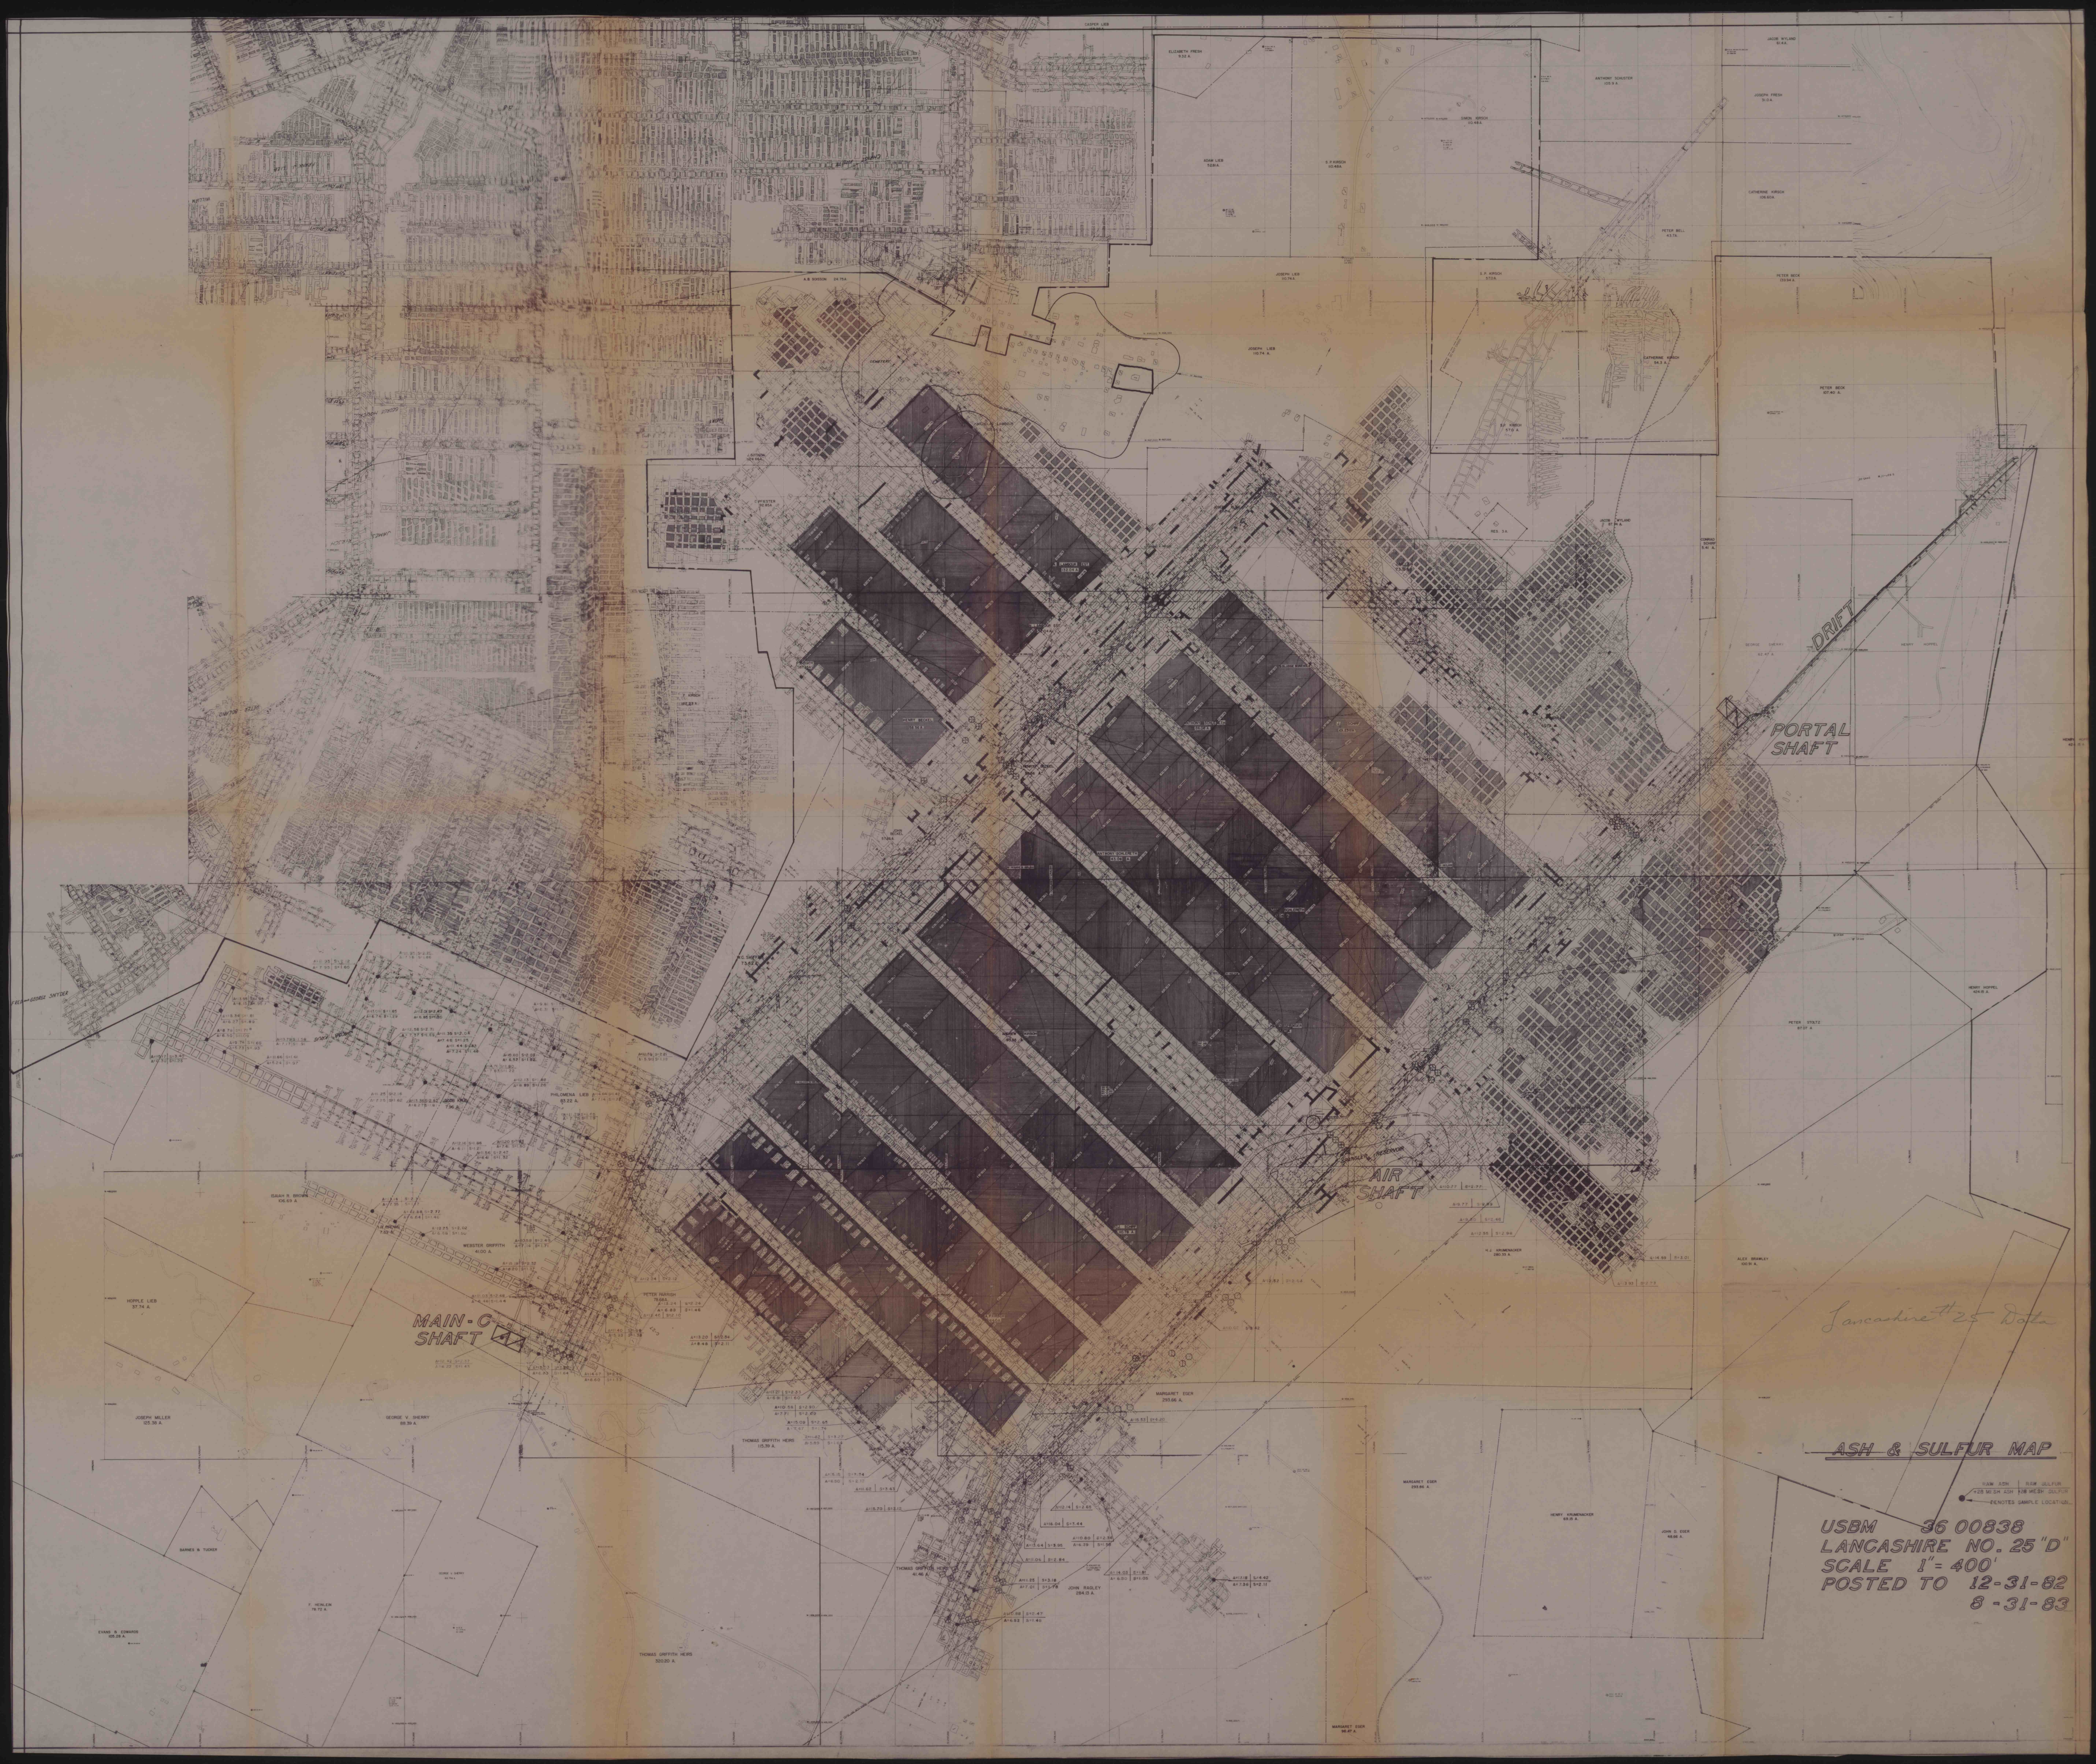

PORTAL
SHAFT

AIR
SHAFT

MAIN-C
SHAFT

Lancashire No. 25 Data

ASH & SULFUR MAP

USBM 36 00838
LANCASHIRE NO. 25 "D"
SCALE 1" = 400'
POSTED TO 12-31-82
8-31-83