

ELLA CRESSWELL ESTATE - surf.
MANOR - coal

JOHN GARRETT - surf.
MANOR - coal

CHARLES VEHOVIC - surf.
MANOR - coal

A.F. CARNO - surf.
MANOR - coal

WATER SEAL (Inaccessible)

WATER SEAL (Inaccessible)

WATER SEAL (Inaccessible)

WATER SEAL (Inaccessible)

WATER SEAL (Inaccessible)

WATER SEAL (Inaccessible)

WATER SEAL (Inaccessible)


WATER SEAL (Inaccessible)

WATER SEAL (Inaccessible)

WATER SEAL (Inaccessible)

WATER SEAL (Inaccessible)

WATER SEAL (Inaccessible)

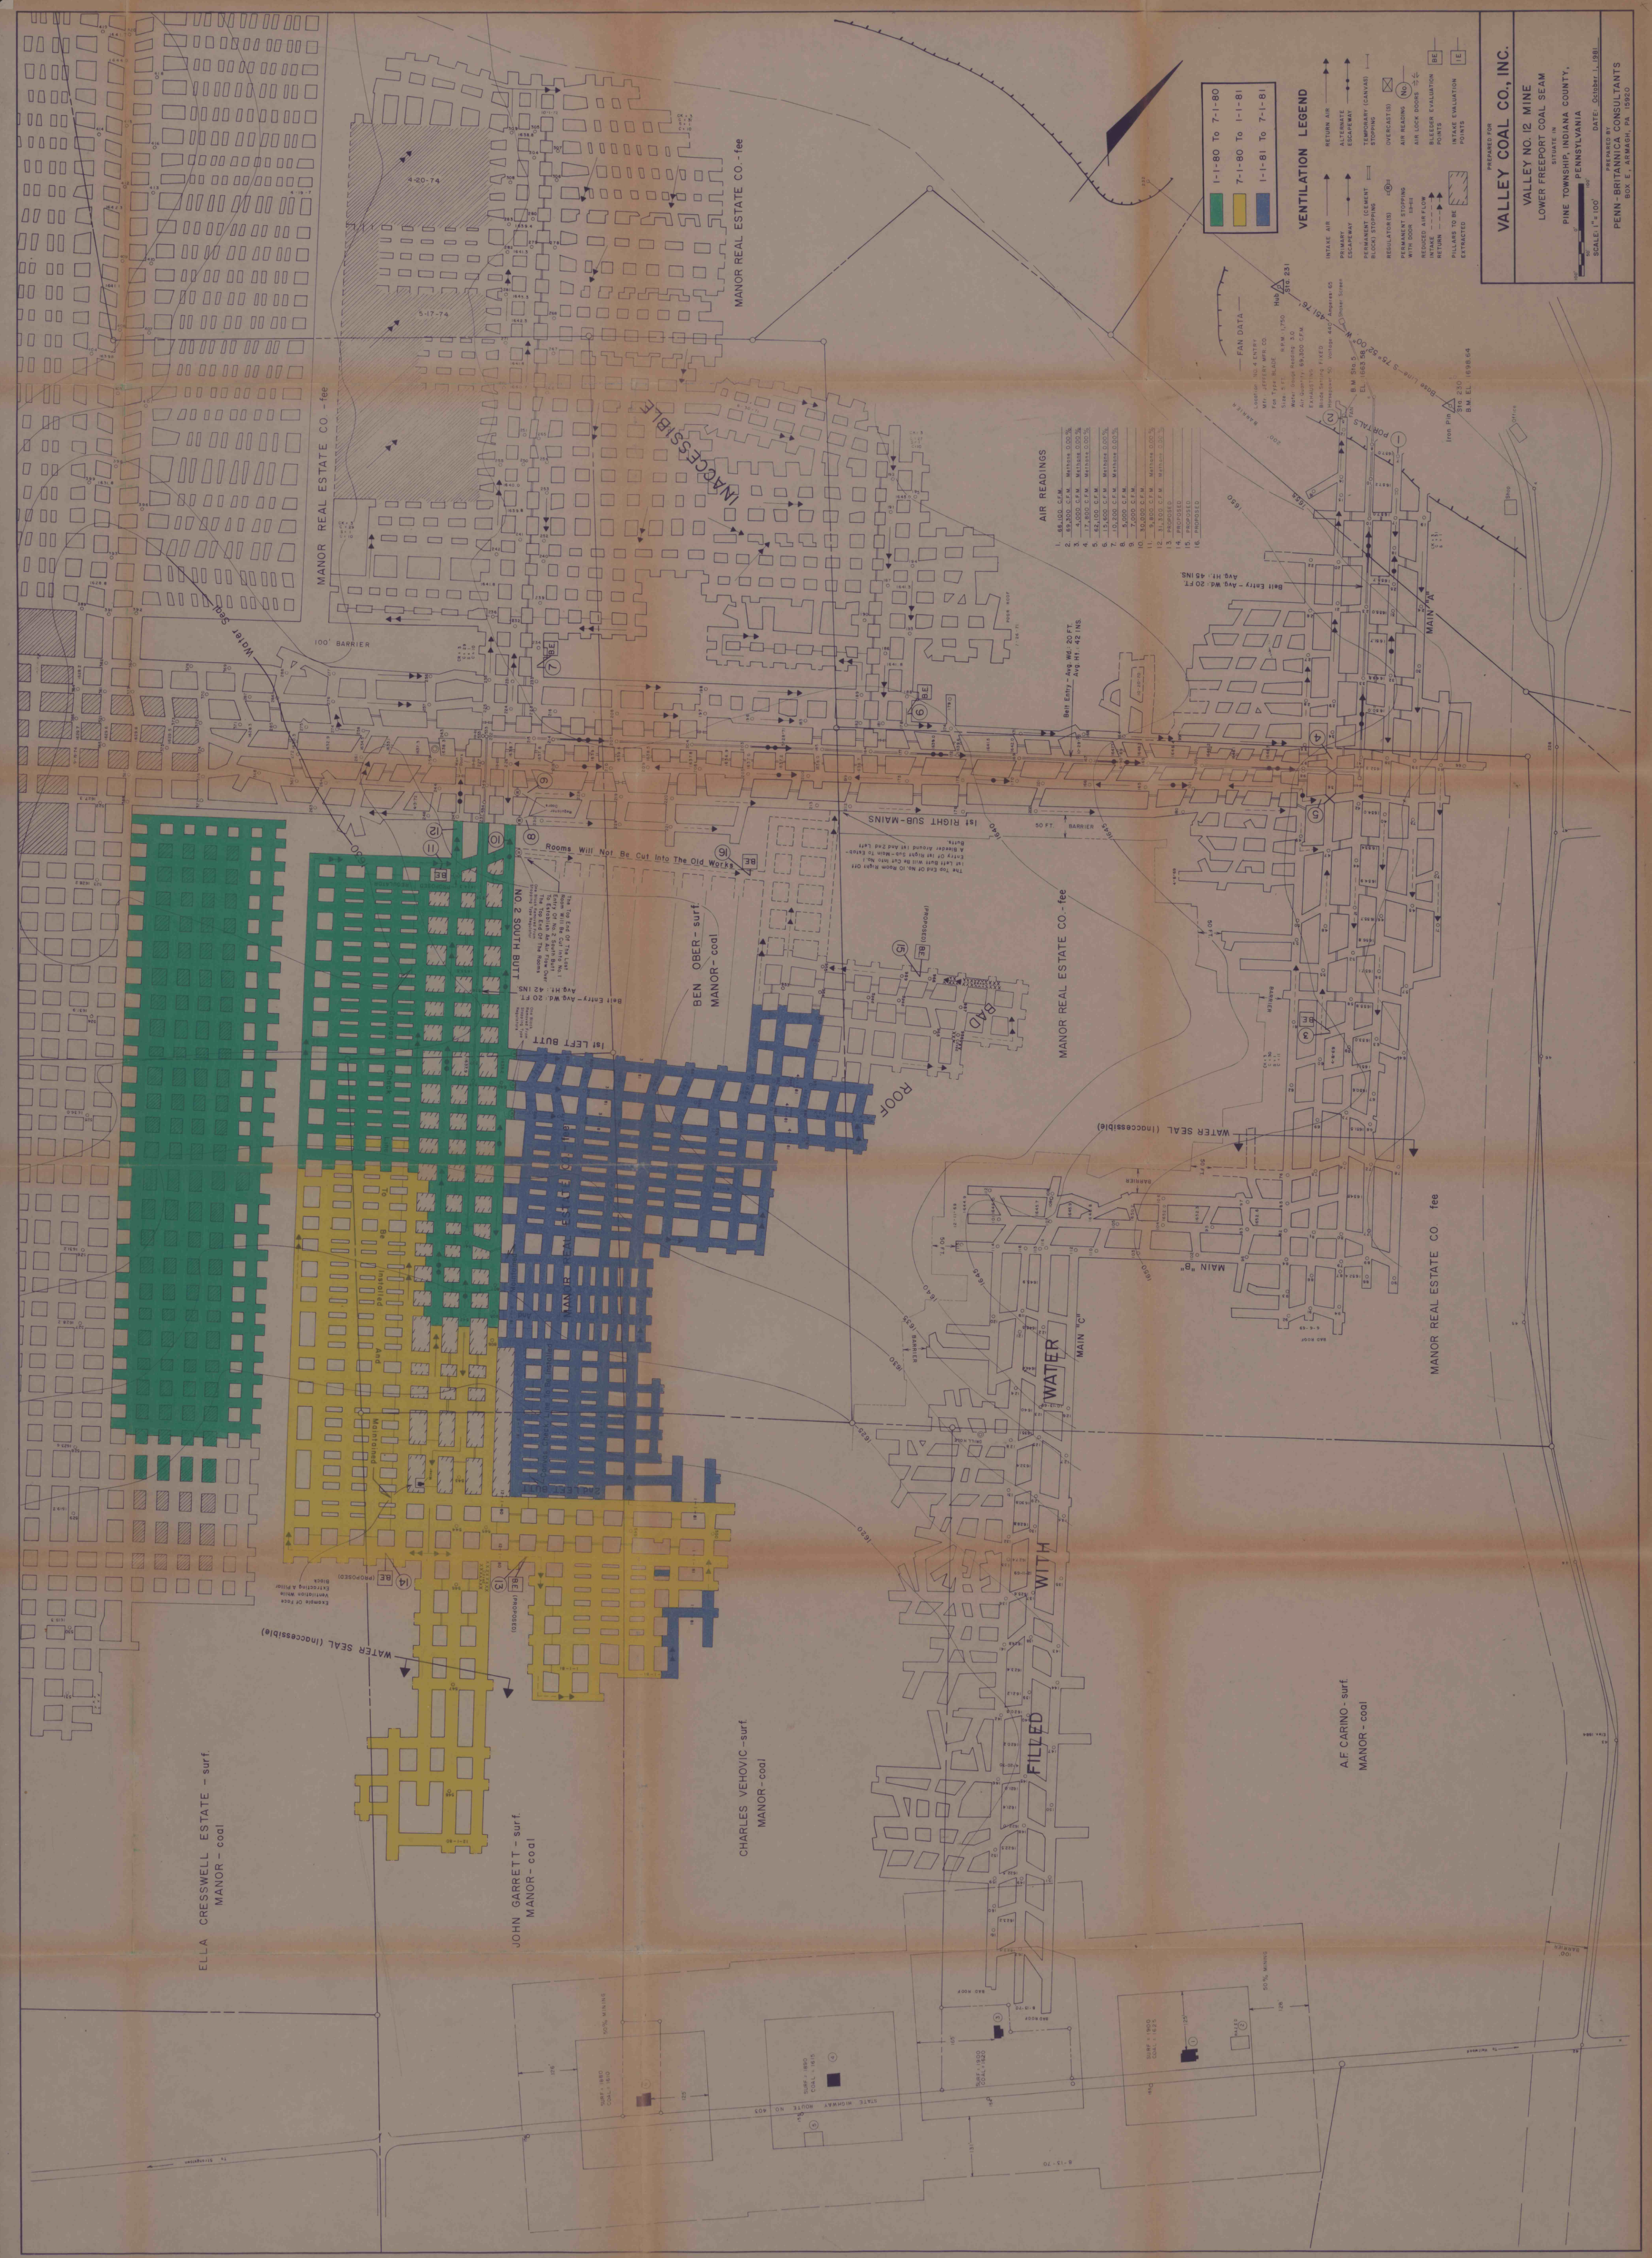


AIR READINGS

1.	8,000 C.F.M.	MANOR 0.05%
2.	4,000 C.F.M.	MANOR 0.05%
3.	17,800 C.F.M.	MANOR 0.05%
4.	15,000 C.F.M.	MANOR 0.05%
5.	15,000 C.F.M.	MANOR 0.05%
6.	15,000 C.F.M.	MANOR 0.05%
7.	10,000 C.F.M.	MANOR 0.05%
8.	8,000 C.F.M.	MANOR 0.05%
9.	8,000 C.F.M.	MANOR 0.05%
10.	30,000 C.F.M.	MANOR 0.05%
11.	8,000 C.F.M.	MANOR 0.05%
12.	8,000 C.F.M.	MANOR 0.05%
13.	8,000 C.F.M.	MANOR 0.05%
14.	PROPOSED	
15.	PROPOSED	
16.	PROPOSED	

VENTILATION LEGEND

1-1-80 To 7-1-80	7-1-80 To 1-1-81	1-1-81 To 7-1-81
[Green Box]	[Yellow Box]	[Blue Box]

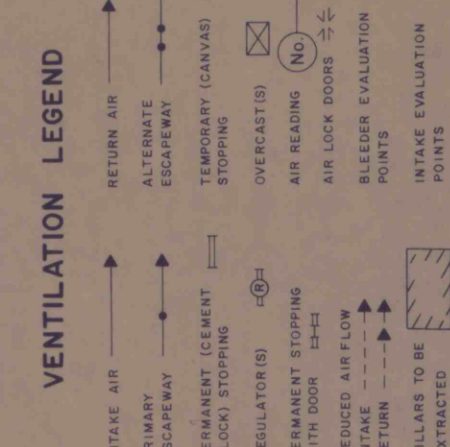

PREPARED FOR
VALLEY COAL CO., INC.
VALLEY NO. 12 MINE
LOWER FREEPORT COAL SEAM
PINE TOWNSHIP, INDIANA COUNTY,
PENNSYLVANIA
PENN. - BRITANNICA CONSULTANTS
BOX E, ARMASH, PA. 15820