


MATCH TO SHEET 5

VENTILATION LEGEND

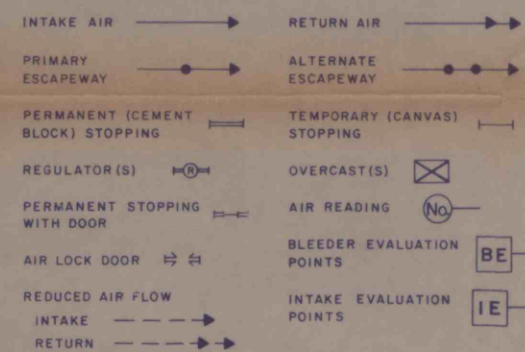


AIR READINGS—

1. 50,460 C.F.M. Methane 0.00 %

2. 49,500 C.F.M.

SUBSIDENCE LEGEND

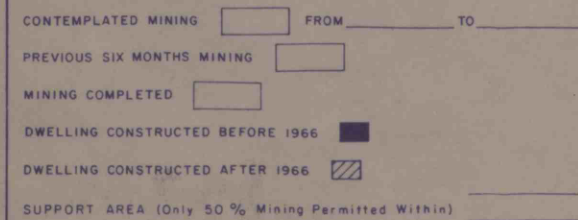

APPROVAL LEGEND

Valley Coal Company
COMPANY

Mardis Run No. 2 Mine
NAME OF MINE

Mine Seal Design and Location
SUBJECT OF APPROVAL

David C. Coker 12/17/84
COMPANY REPRESENTATIVE DATE

John S. Burtch 12/18/84
ENGINEER DATE

COMMISSIONER, OFFICE OF DEEP MINE SAFETY
DEPARTMENT OF ENVIRONMENTAL RESOURCES DATE

DIRECTOR, BITUMINOUS DEEP MINE SAFETY
DEPARTMENT OF ENVIRONMENTAL RESOURCES DATE

DISTRICT MINE INSPECTOR
DEPARTMENT OF ENVIRONMENTAL RESOURCES DATE

SURFACE:
EDWIN M. CLARK, JR. and
ALAN HOLSINGER
MINERAL:
MANOR REAL ESTATE & COAL CO.

SURFACE:
EMILY JOHNSON
MINERAL:
PENN CENTRAL CORP.

SURFACE:
La CARTE ENTERPRISES, INC.
MINERAL:
PENN CENTRAL CORP.

SURFACE:
La CARTE ENTERPRISES, INC.
MINERAL:
MANOR REAL ESTATE & COAL CO.

SURFACE:
HARRY C. and MAUDE M. GRAHAM
MINERAL:
MANOR REAL ESTATE & COAL CO.

NOTE: PIT TO BE COMPACTED WITH IMPERVIOUS CLAY, BACK-FILLED AND PLANTED AFTER SEALS HAVE BEEN INSTALLED. FAN, HOUSING AND CANDYPS TO BE REMOVED BEFORE BACKFILLING.

Main (Primary) Fan

Proposed Mine Seal Locations

Sta. 16
Bench Mark Elev.: 1785.95

Sta. 15
Bench Mark Elev.: 1821.77

Bathhouse

Office

Sub-station

FACILITIES

TO MINE

ELECTRIC LINE

TO MINE

























MATCH TO SHEET 1

7	8
5	6
3	4
1	2

SHEET INDEX

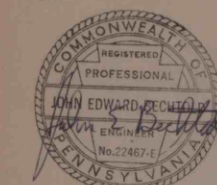

—FINAL MAP—
EXHIBIT "B"

PREPARED FOR
VALLEY COAL COMPANY

MARDIS RUN NO. 2 MINE
LOWER FREEPORT COAL SEAM

SITUATE
BUFFINGTON TWP., INDIANA CO.,
PENNSYLVANIA

ALL MINING COMPLETED -
SEPTEMBER 14, 1984

SCALE: 1" = 100'

DECEMBER 6, 1984

PREPARED BY
PENN-BRITANNICA CONSULTANTS
BOX "E", ARMAGH, PA. 15920

SHEET 3 OF 8

MATCH TO SHEET 4