



MATCH TO SHEET 5

VENTILATION LEGEND

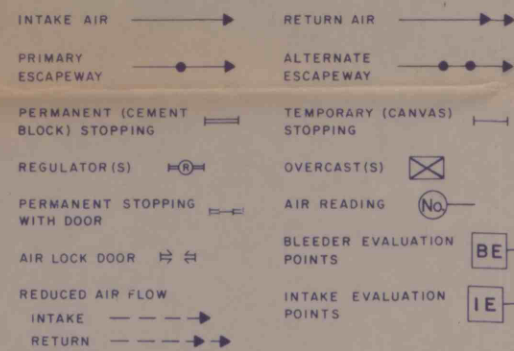

—AIR READINGS—
 1. 50,460 C.F.M. Methane 0.00 %
 2. 49,500 C.F.M.

SUBSIDENCE LEGEND

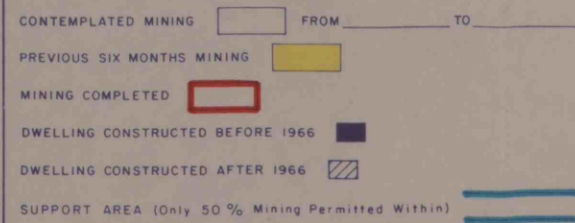

SURFACE:
 EDWIN M. CLARK, JR. and
 ALAN HOLSINGER
 MINERAL:
 MANOR REAL ESTATE & COAL CO.

SURFACE:
 EMILY JOHNSON
 MINERAL:
 PENN CENTRAL CORP.

SURFACE:
 La CARTE ENTERPRISES, INC.
 MINERAL:
 PENN CENTRAL CORP.

SURFACE:
 La CARTE ENTERPRISES, INC.
 MINERAL:
 MANOR REAL ESTATE & COAL CO.

SURFACE:
 HARRY C. and MAUDE M. GRAHAM
 MINERAL:
 MANOR REAL ESTATE & COAL CO.

7	8
5	6
3	4
1	2

SHEET INDEX

—FINAL MAP—
 EXHIBIT "B"

PREPARED FOR
VALLEY COAL COMPANY

MARDIS RUN NO. 2 MINE
 LOWER FREEPORT COAL SEAM
 SITUATE
 BUFFINGTON TWP., INDIANA CO.,
 PENNSYLVANIA

SCALE: 1" = 100'
 100' 50' 0' 50' 100'

OCT. 1 0 1984

PREPARED BY
 PENN-BRITANNICA CONSULTANTS
 BOX "E", ARMAGH, PA. 15920

SHEET 3 OF 8

MATCH TO SHEET 1

MATCH TO SHEET 4