


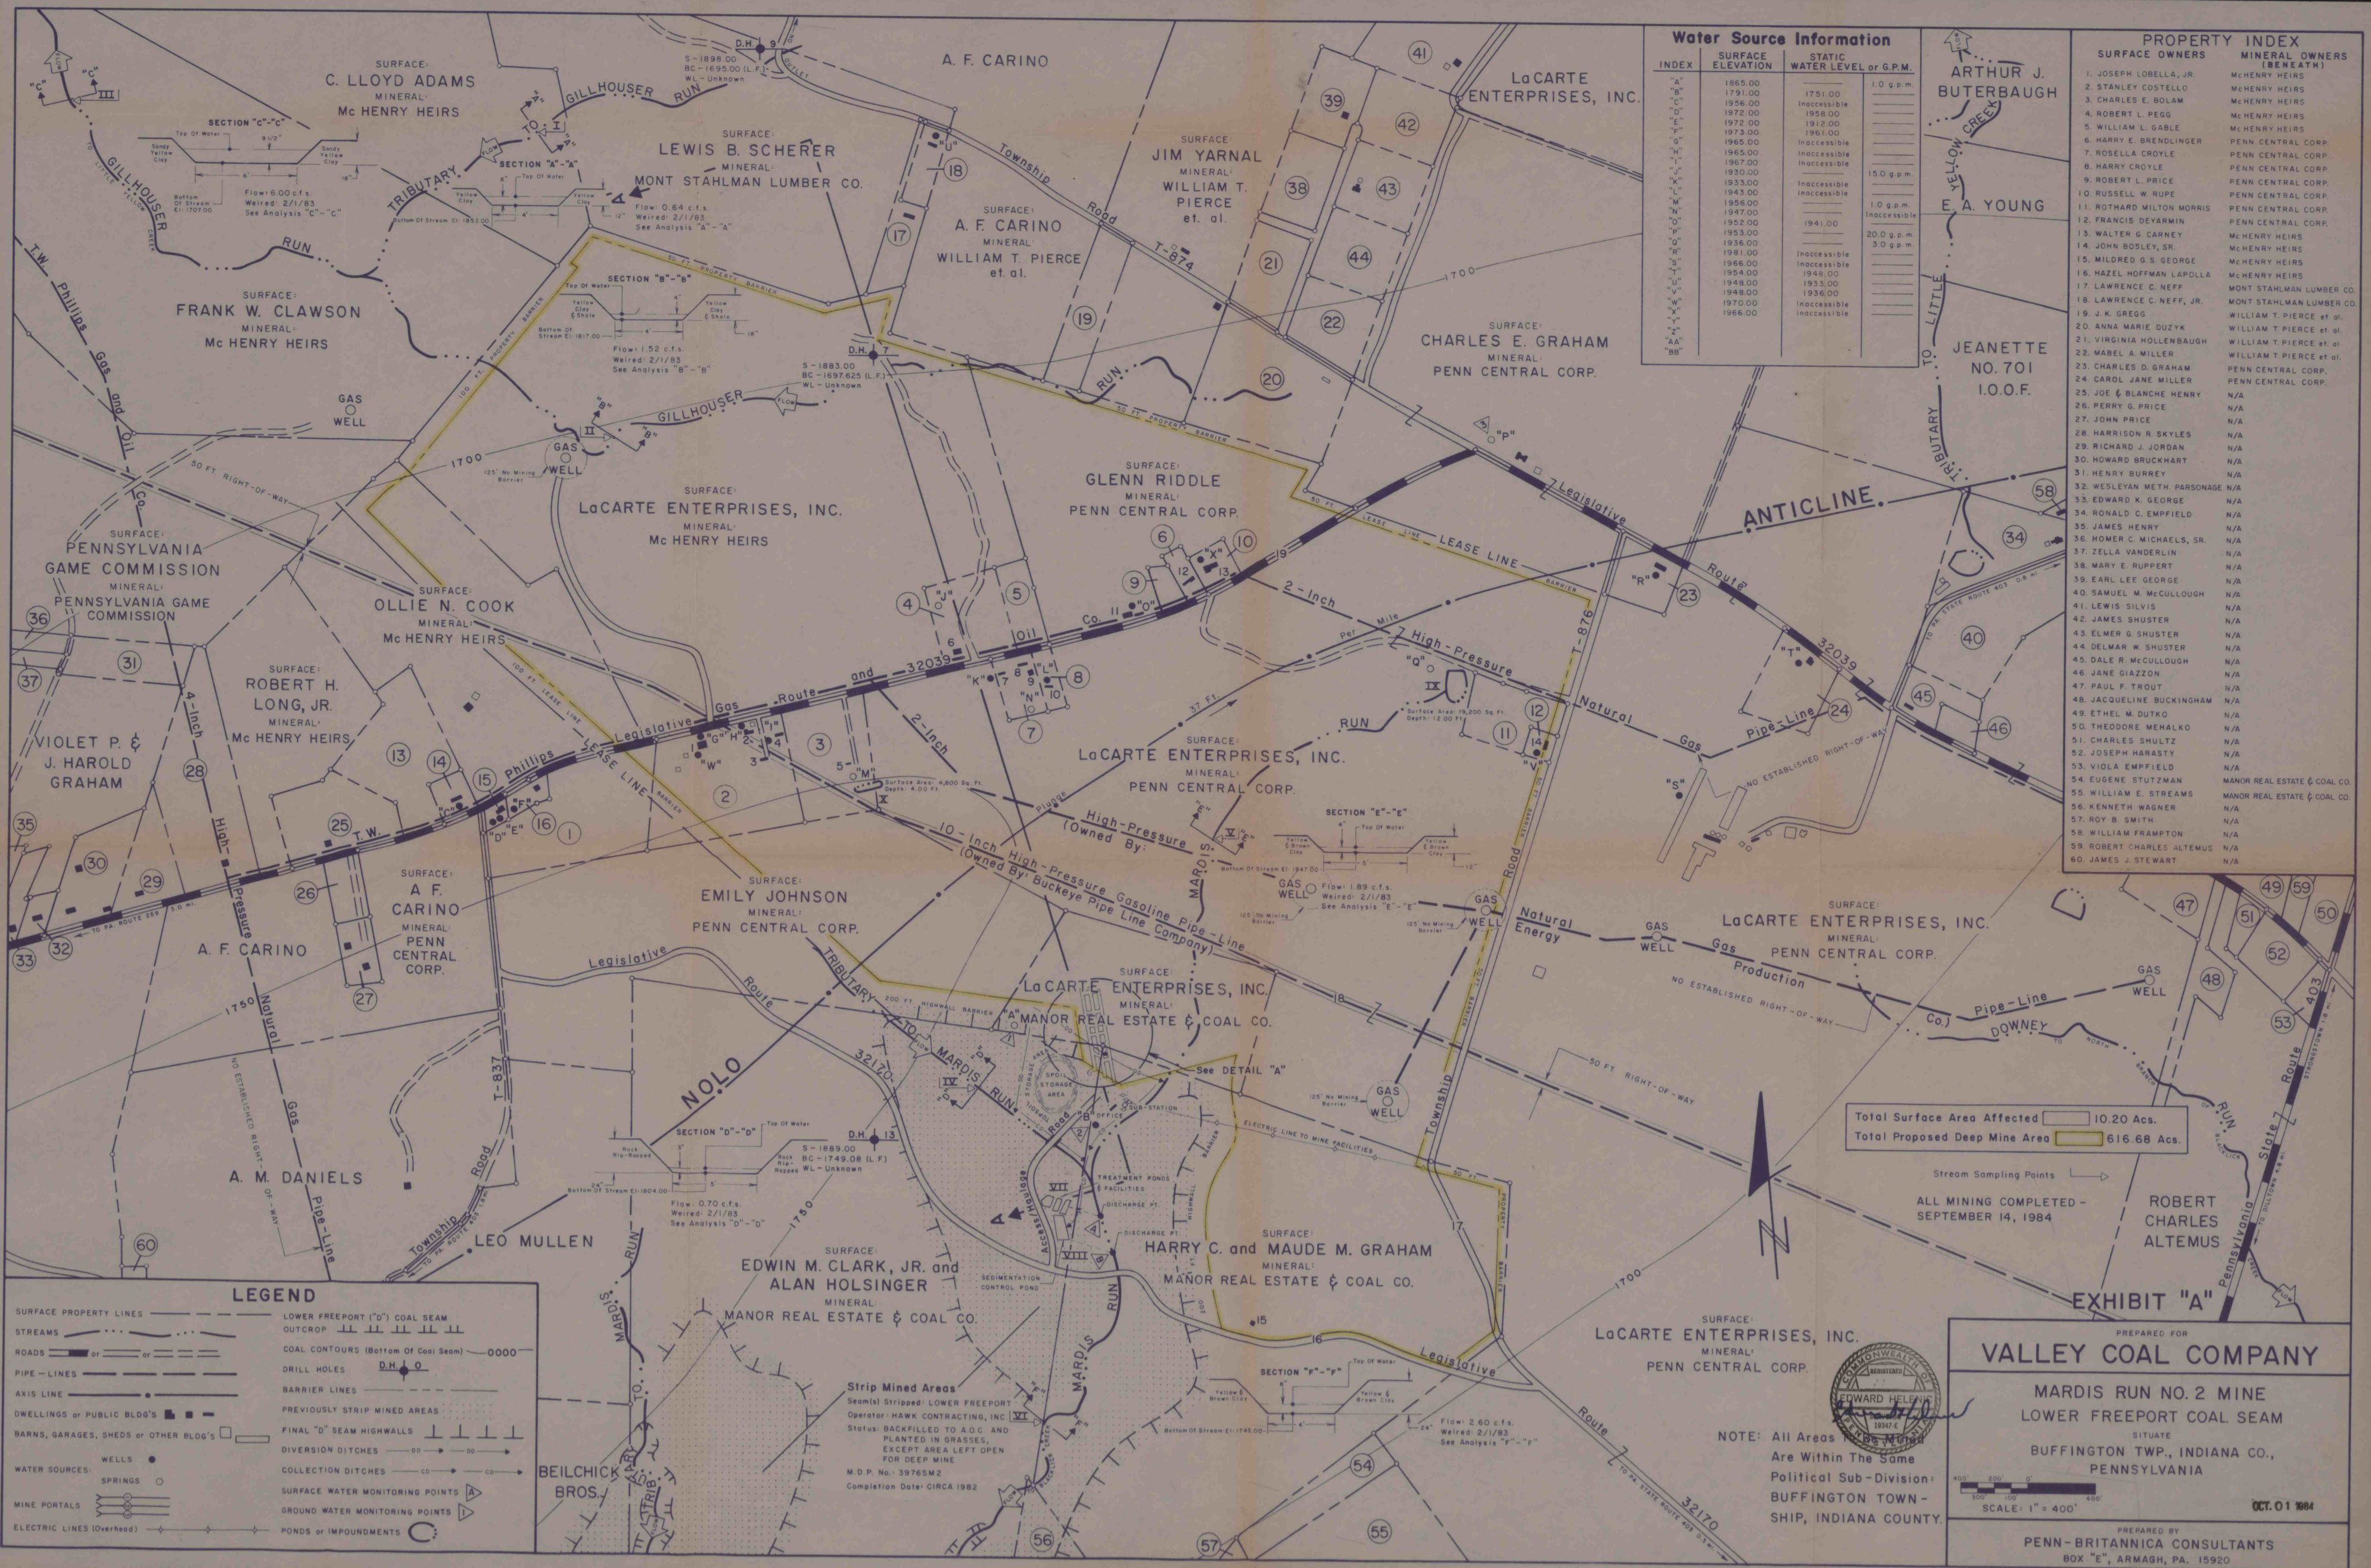

Water Source Information			
INDEX	SURFACE ELEVATION	STATIC WATER LEVEL or G.P.M.	
"A"	1865.00	1751.00	10 g.p.m.
"B"	1791.00	Inaccessible	
"C"	1956.00	1958.00	
"D"	1972.00	1912.00	
"E"	1972.00	1961.00	
"F"	1973.00	Inaccessible	
"G"	1965.00	Inaccessible	150 g.p.m.
"H"	1965.00	Inaccessible	
"I"	1967.00	Inaccessible	
"J"	1930.00	Inaccessible	
"K"	1943.00	Inaccessible	
"L"	1956.00	Inaccessible	1.0 g.p.m.
"M"	1947.00	Inaccessible	
"N"	1952.00	1941.00	
"O"	1953.00		20.0 g.p.m.
"P"	1936.00		3.0 g.p.m.
"Q"	1981.00	Inaccessible	
"R"	1966.00	Inaccessible	
"S"	1953.00	1948.00	
"T"	1948.00	1936.00	
"U"	1948.00	1936.00	
"V"	1970.00	Inaccessible	
"W"	1966.00	Inaccessible	
"X"			
"Y"			
"Z"			
"AA"			
"BB"			

PROPERTY INDEX	
SURFACE OWNERS	MINERAL OWNERS (BENEATH)
1. JOSEPH LOBELLA, JR.	McHENRY HEIRS
2. STANLEY COSTELLO	McHENRY HEIRS
3. CHARLES E. BOLAM	McHENRY HEIRS
4. ROBERT L. PEGG	McHENRY HEIRS
5. WILLIAM L. GABLE	McHENRY HEIRS
6. HARRY E. BRENDLINGER	PENN CENTRAL CORP.
7. ROSELLA CROYLE	PENN CENTRAL CORP.
8. HARRY CROYLE	PENN CENTRAL CORP.
9. ROBERT L. PRICE	PENN CENTRAL CORP.
10. RUSSELL W. RUPE	PENN CENTRAL CORP.
11. ROTHARD MILTON MORRIS	PENN CENTRAL CORP.
12. FRANCIS DEYARMIN	PENN CENTRAL CORP.
13. WALTER G. CARNEY	McHENRY HEIRS
14. JOHN BOSLEY, SR.	McHENRY HEIRS
15. MILDRED G. S. GEORGE	McHENRY HEIRS
16. HAZEL HOFFMAN LAPOLLA	McHENRY HEIRS
17. LAWRENCE C. NEFF	MONT STAHLMAN LUMBER CO.
18. LAWRENCE C. NEFF, JR.	MONT STAHLMAN LUMBER CO.
19. J. K. GREGG	WILLIAM T. PIERCE et al.
20. ANNA MARIE DUZYK	WILLIAM T. PIERCE et al.
21. VIRGINIA HOLLENBAUGH	WILLIAM T. PIERCE et al.
22. MABEL A. MILLER	WILLIAM T. PIERCE et al.
23. CHARLES D. GRAHAM	PENN CENTRAL CORP.
24. CAROL JANE MILLER	PENN CENTRAL CORP.
25. JOE & BLANCHE HENRY	N/A
26. PERRY G. PRICE	N/A
27. JOHN PRICE	N/A
28. HARRISON R. SKYLES	N/A
29. RICHARD J. JORDAN	N/A
30. HOWARD BRUCKHART	N/A
31. HENRY BURREY	N/A
32. WESLEYAN METH. PARSONAGE	N/A
33. EDWARD K. GEORGE	N/A
34. RONALD C. EMPFIELD	N/A
35. JAMES HENRY	N/A
36. HOMER C. MICHAELS, SR.	N/A
37. ZELLA VANDERLIN	N/A
38. MARY E. RUPPERT	N/A
39. EARL LEE GEORGE	N/A
40. SAMUEL M. McCULLOUGH	N/A
41. LEWIS SILVIS	N/A
42. JAMES SHUSTER	N/A
43. ELMER G. SHUSTER	N/A
44. DELMAR W. SHUSTER	N/A
45. DALE R. McCULLOUGH	N/A
46. JANE GAZZON	N/A
47. PAUL F. TROUT	N/A
48. JACQUELINE BUCKINGHAM	N/A
49. ETHEL M. DUTKO	N/A
50. THEODORE MEHALKO	N/A
51. CHARLES SHULTZ	N/A
52. JOSEPH HARASTY	N/A
53. VIOLA EMPFIELD	N/A
54. EUGENE STUTZMAN	MANOR REAL ESTATE & COAL CO.
55. WILLIAM E. STREAMS	MANOR REAL ESTATE & COAL CO.
56. KENNETH WAGNER	N/A
57. ROY B. SMITH	N/A
58. WILLIAM FRAMPTON	N/A
59. ROBERT CHARLES ALTEMUS	N/A
60. JAMES J. STEWART	N/A

Total Surface Area Affected 10.20 Acs.
Total Proposed Deep Mine Area 616.68 Acs.

Stream Sampling Points
ALL MINING COMPLETED - SEPTEMBER 14, 1984

VALLEY COAL COMPANY

MARDIS RUN NO. 2 MINE
LOWER FREEPORT COAL SEAM

SITUATE
BUFFINGTON TWP., INDIANA CO.,
PENNSYLVANIA

PREPARED BY
PENN-BRITANNICA CONSULTANTS
BOX "E", ARMAGH, PA. 15920

-FINAL MAP-