


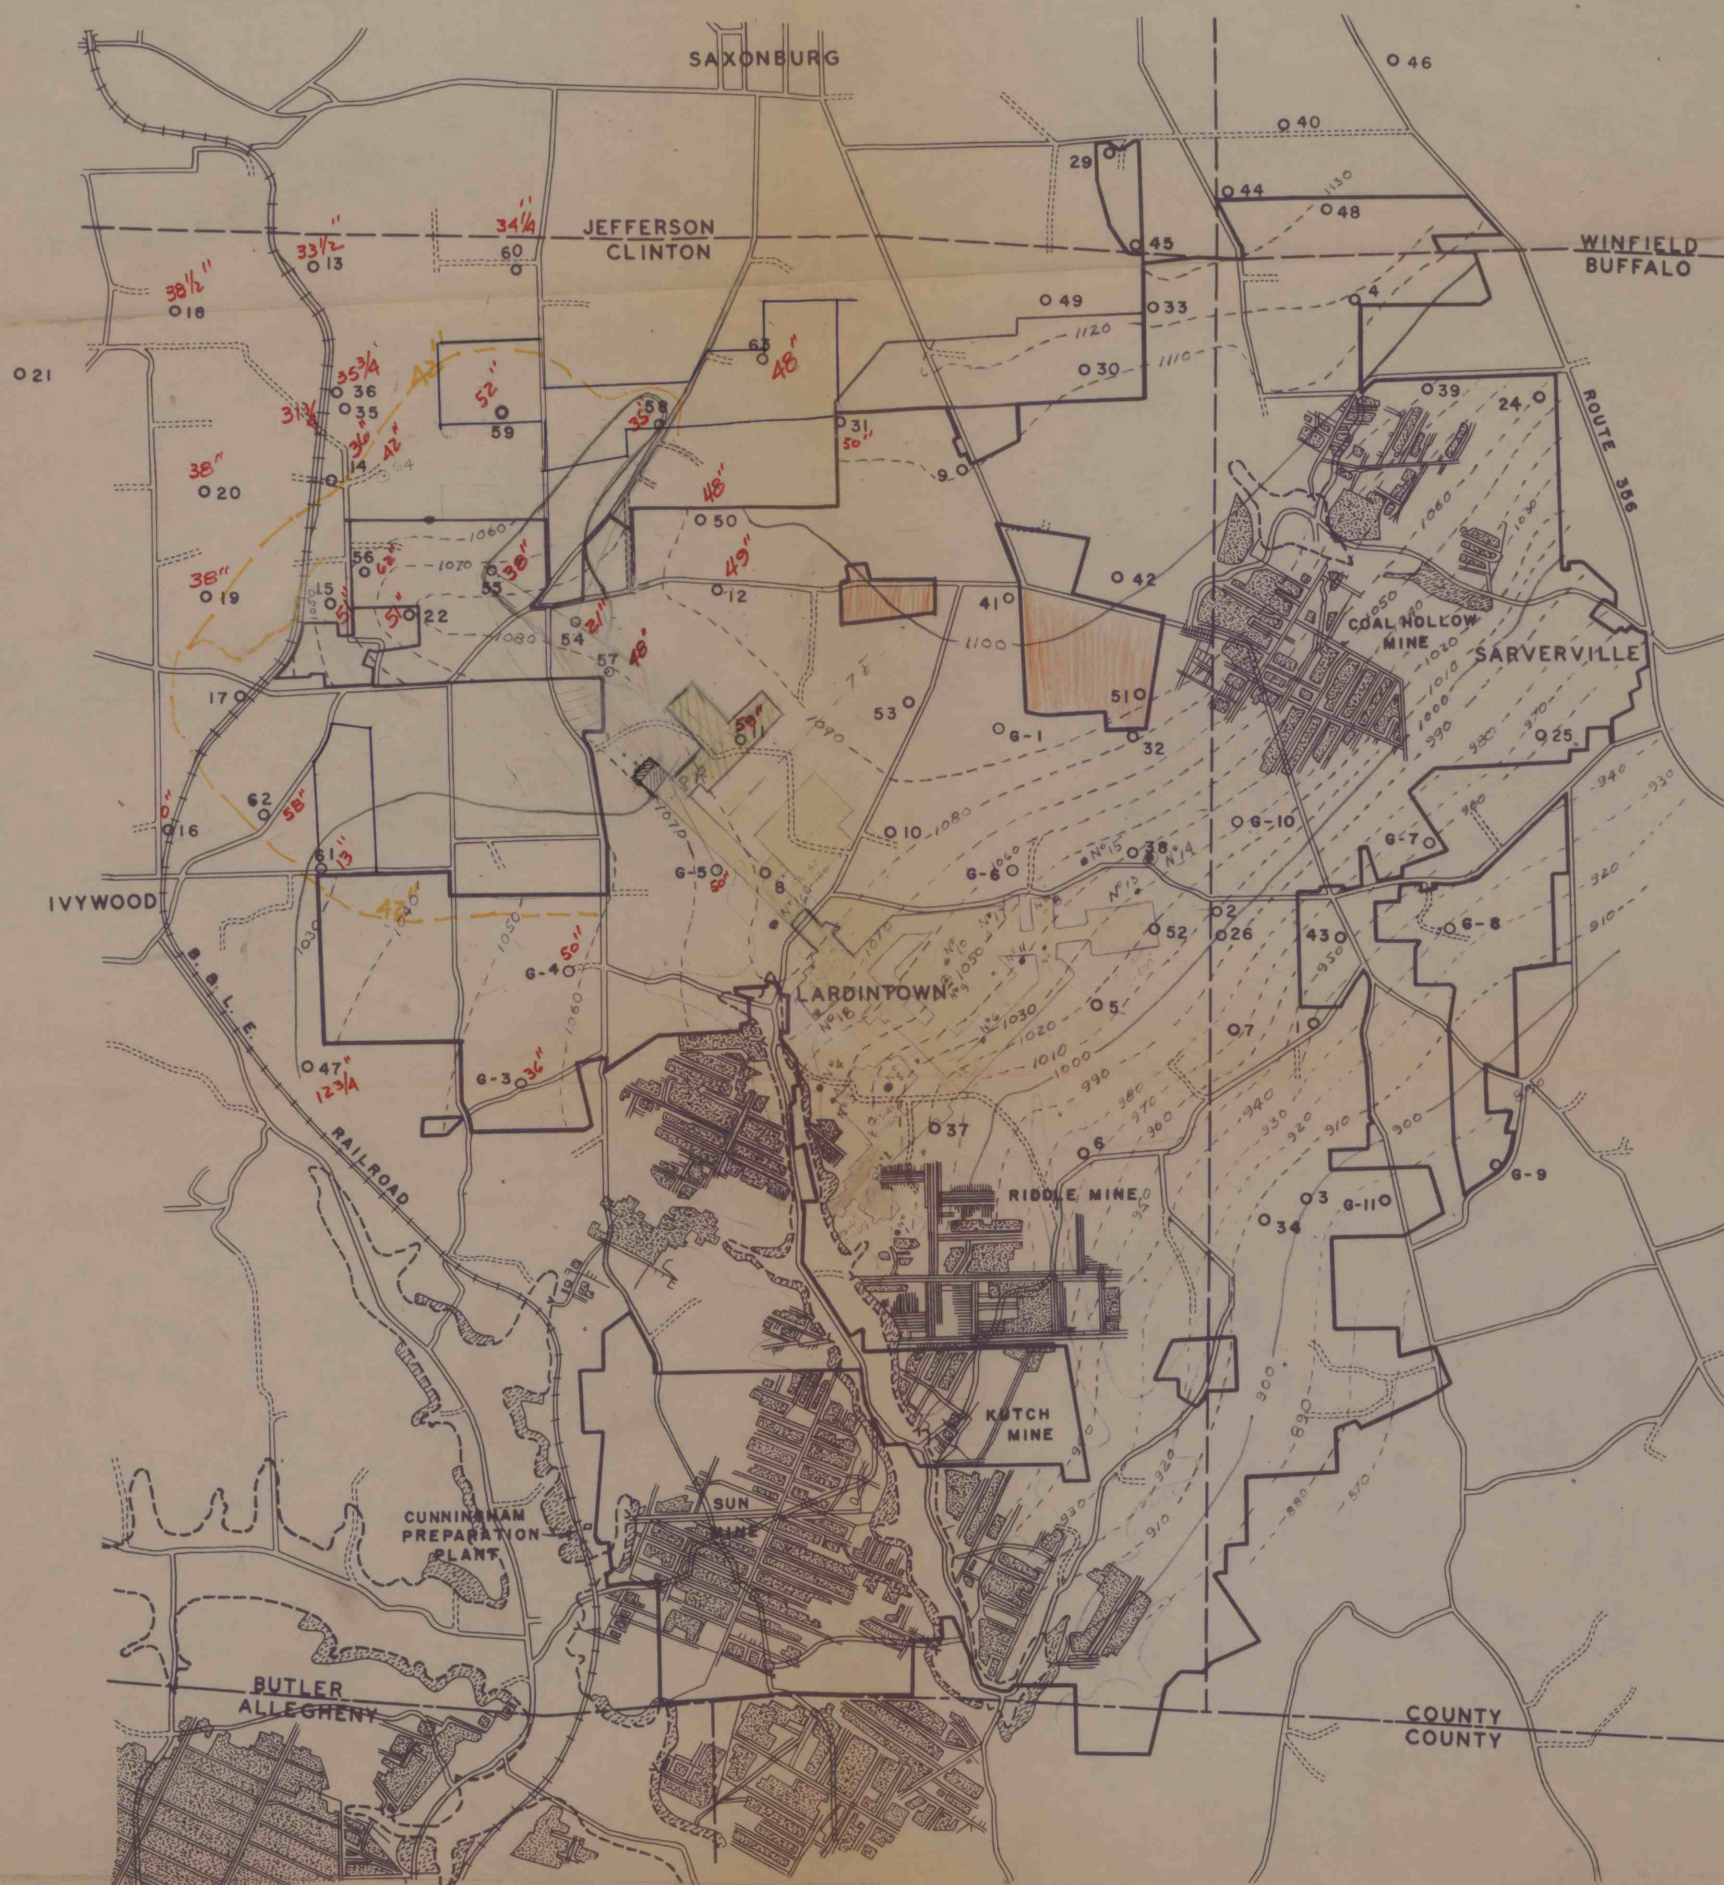

- CONNECTED RESERVES
- UPPER FREEPORT SEAM OUTCROP
- AREA MINED BY STRIPPING
- DIAMOND DRILL HOLES
- INDICATES WET AREA
- COAL SEAM
- COVER

CONNECTED RESERVES
UPPER FREEPORT COAL
CLINTON, BUFFALO, JEFFERSON, & WINFIELD TWPS.
BUTLER COUNTY, PENNSYLVANIA

1" = 2000'