


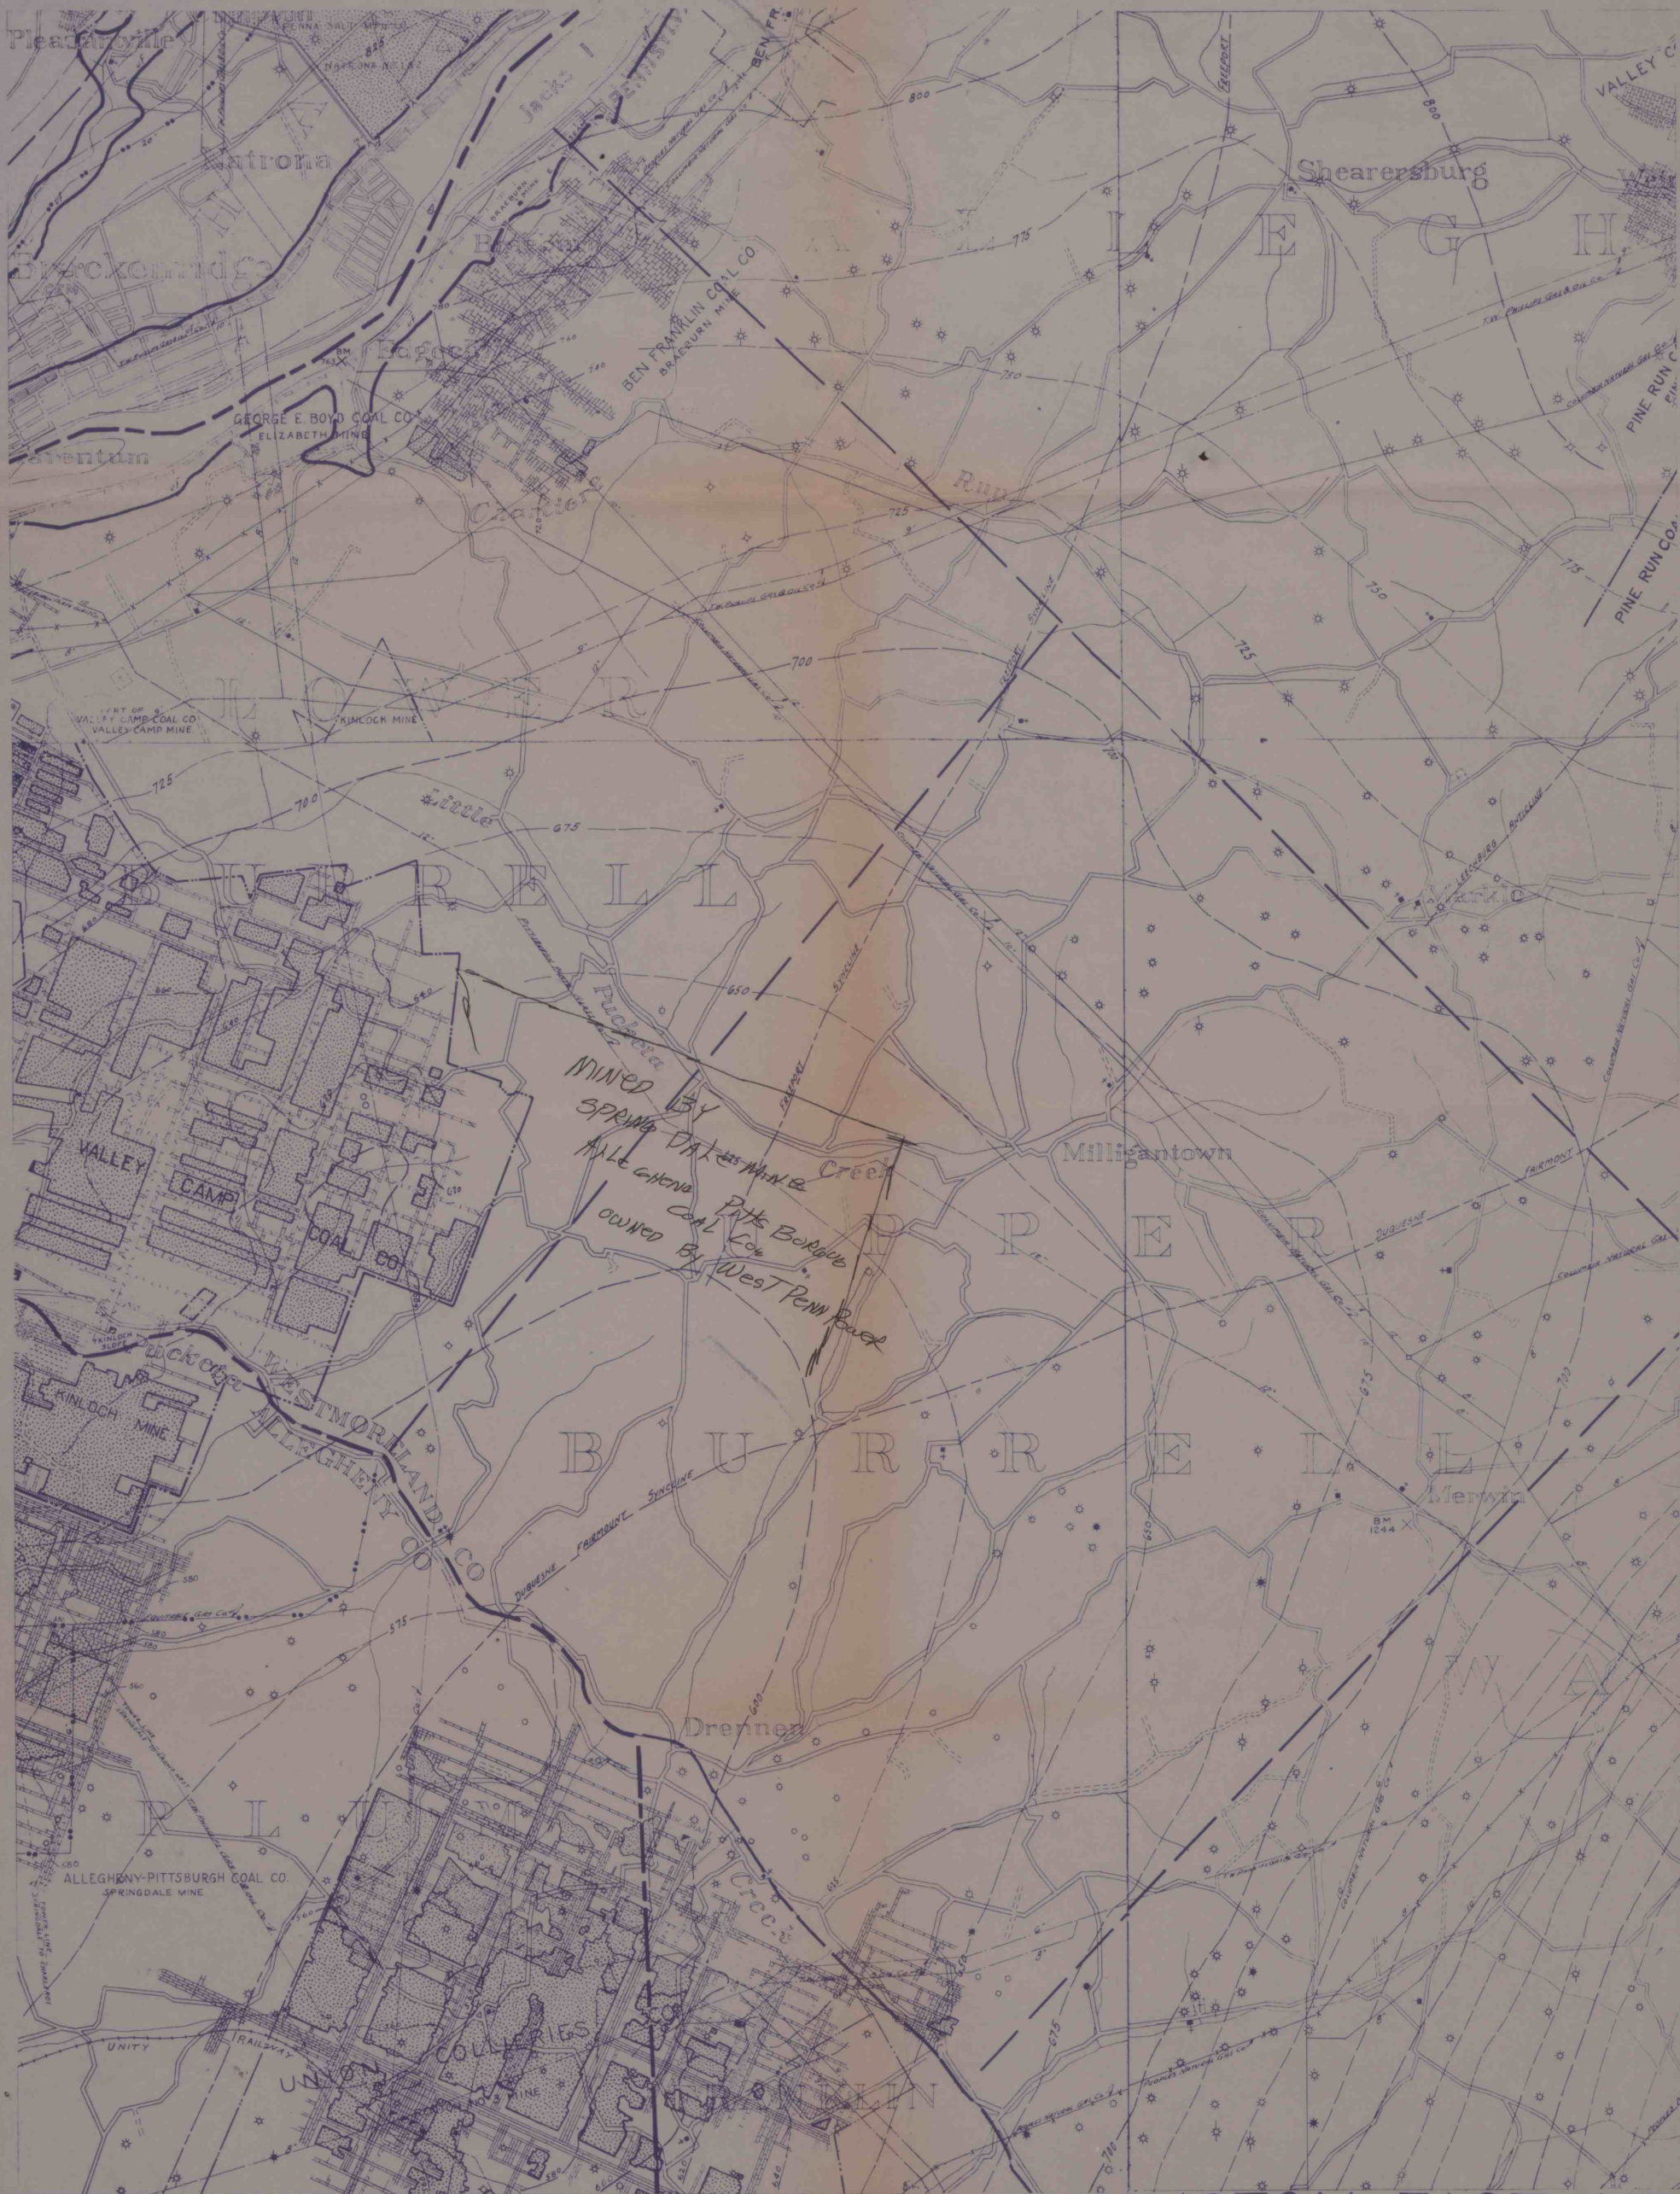

NEW KENSINGTON EAST-UF