D.H.	SURF. EL.	L.F. EL.	HT.
1			
2			
3			
4	1085	[illegible]	24"
5	1120	1060	48"
6	1150	1080	32"
7	1080	NO COAL	
8			
9	1100	1025	34"
10	1090	1066	24"
11	1130	1083	34"
12	1165	1092	36"
13	1140	1080	36"
14	1160	1085	36"
15	1105	1054	30"
16			

COLOR	PERMIT NO	ACREAGE	
	1137-3(C)	33.25	COMPLETION
	1137-3(C)A	15.0	DELETION
	1137-3(C)A2	15.0	TOPSOIL
	1137-3(C)A3	11.0	PREVIOUSLY AFFECTED
	To be Assigned		
	OPEN CUT		

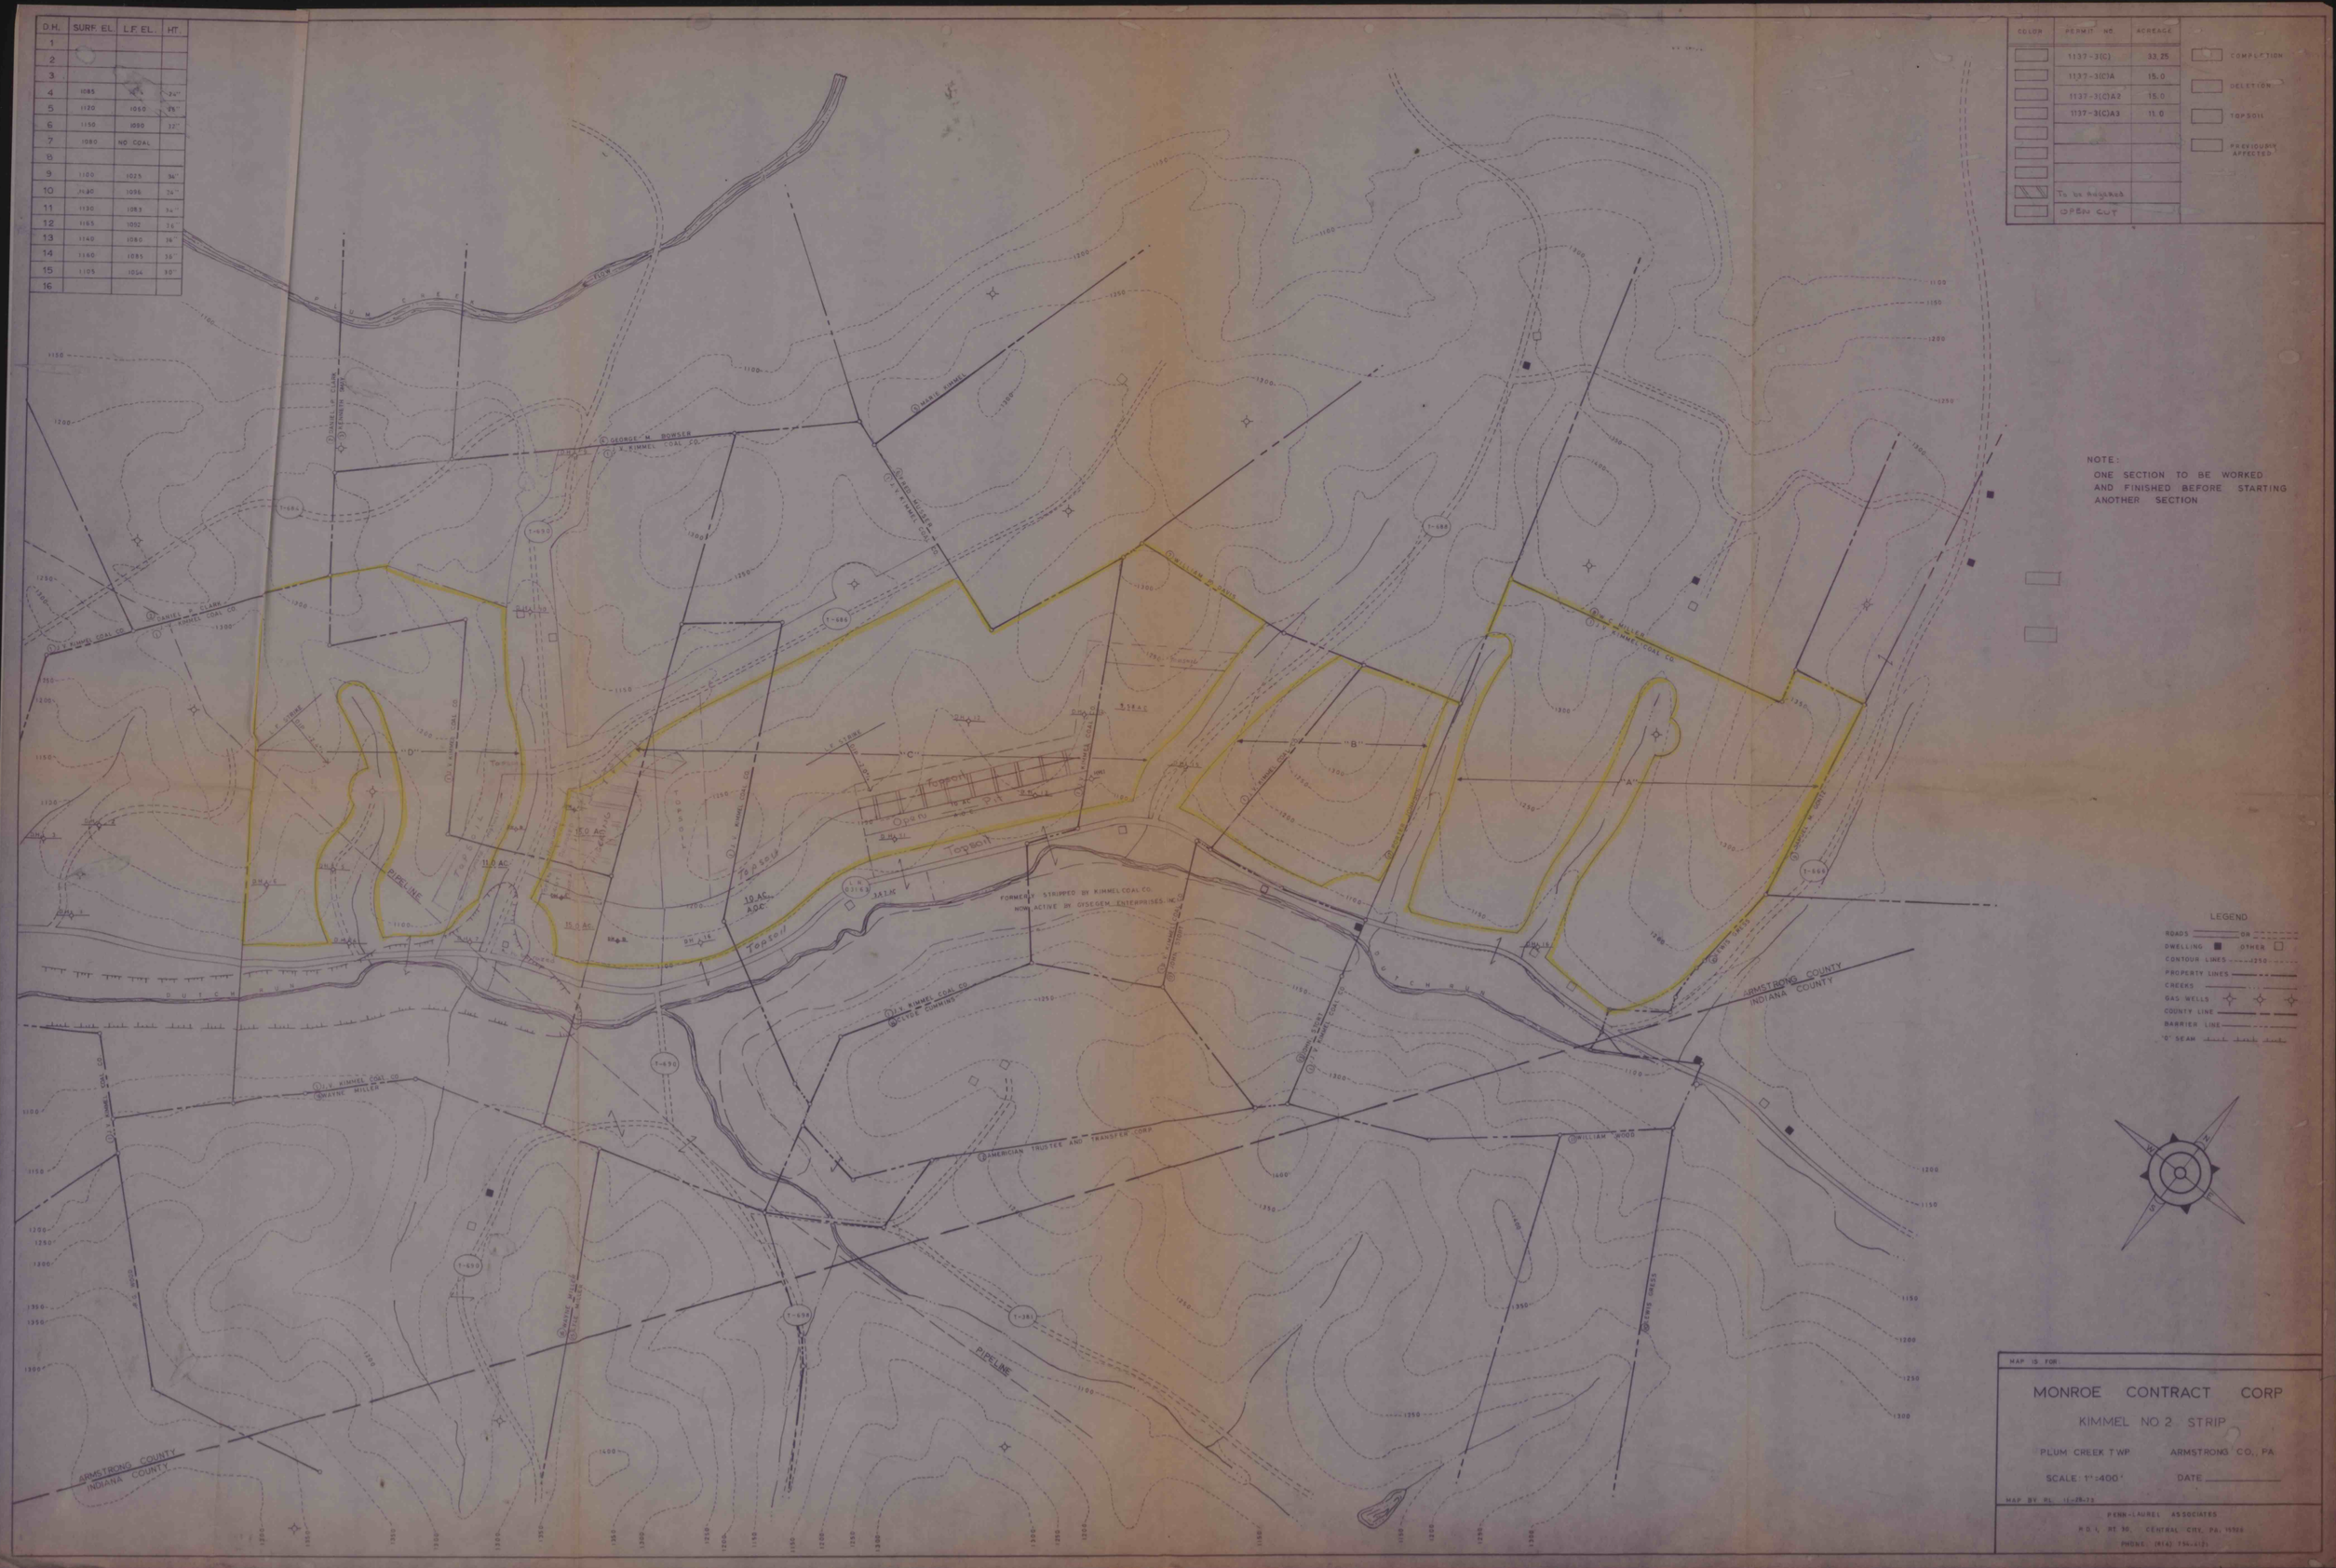

NOTE:
ONE SECTION TO BE WORKED AND FINISHED BEFORE STARTING ANOTHER SECTION

LEGEND
ROADS — DR
DWELLING — OTHER
CONTOUR LINES — 1250
PROPERTY LINES
CREEKS
GAS WELLS
COUNTY LINE
BARRIER LINE
"O" SEAM

MAP IS FOR:

MONROE CONTRACT CORP

KIMMEL NO 2 STRIP

PLUM CREEK TWP. ARMSTRONG CO., PA

SCALE: 1"=400' DATE _____

MAP BY RL 11-28-73

PENN-LAUREL ASSOCIATES
R.D.1, RT 30, CENTRAL CITY, PA. 15926
PHONE: (814) 754-6123