


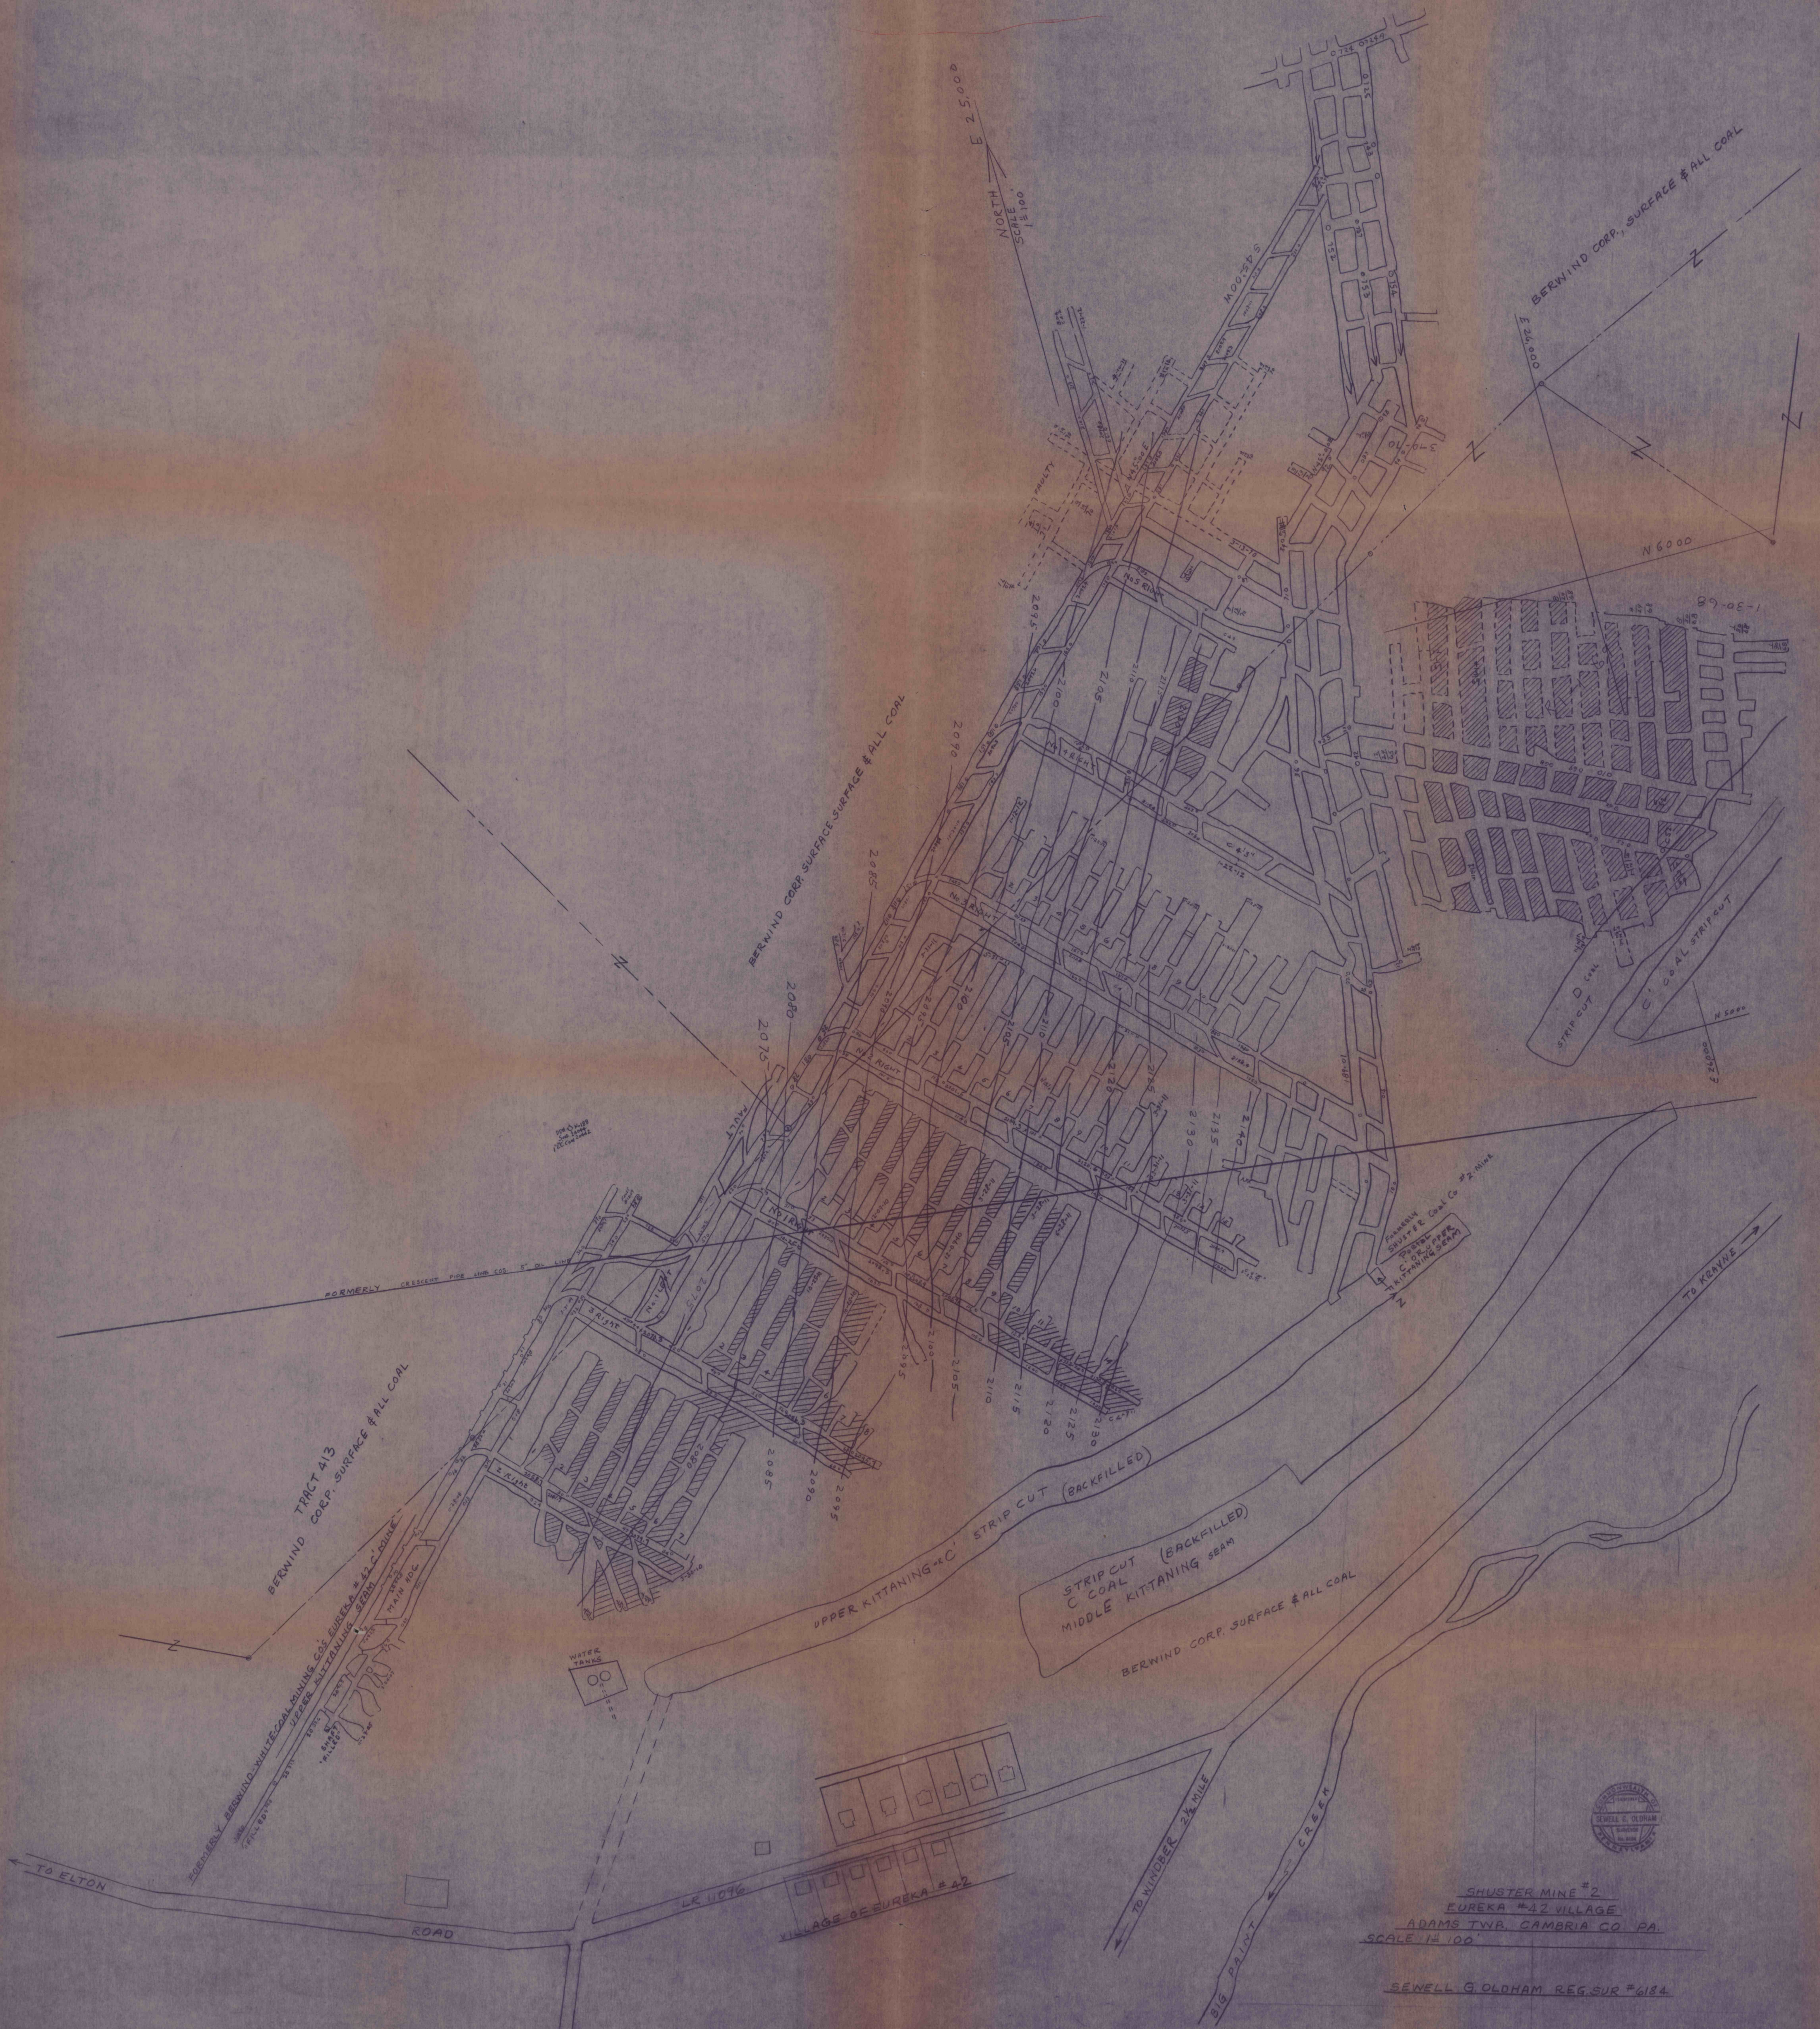

SHUSTER MINE #2
EUREKA #42 VILLAGE
ADAMS TWP. CAMBRIA CO. PA.
SCALE 1" = 100'

SEWELL G. OLDHAM REG. SUR #6184