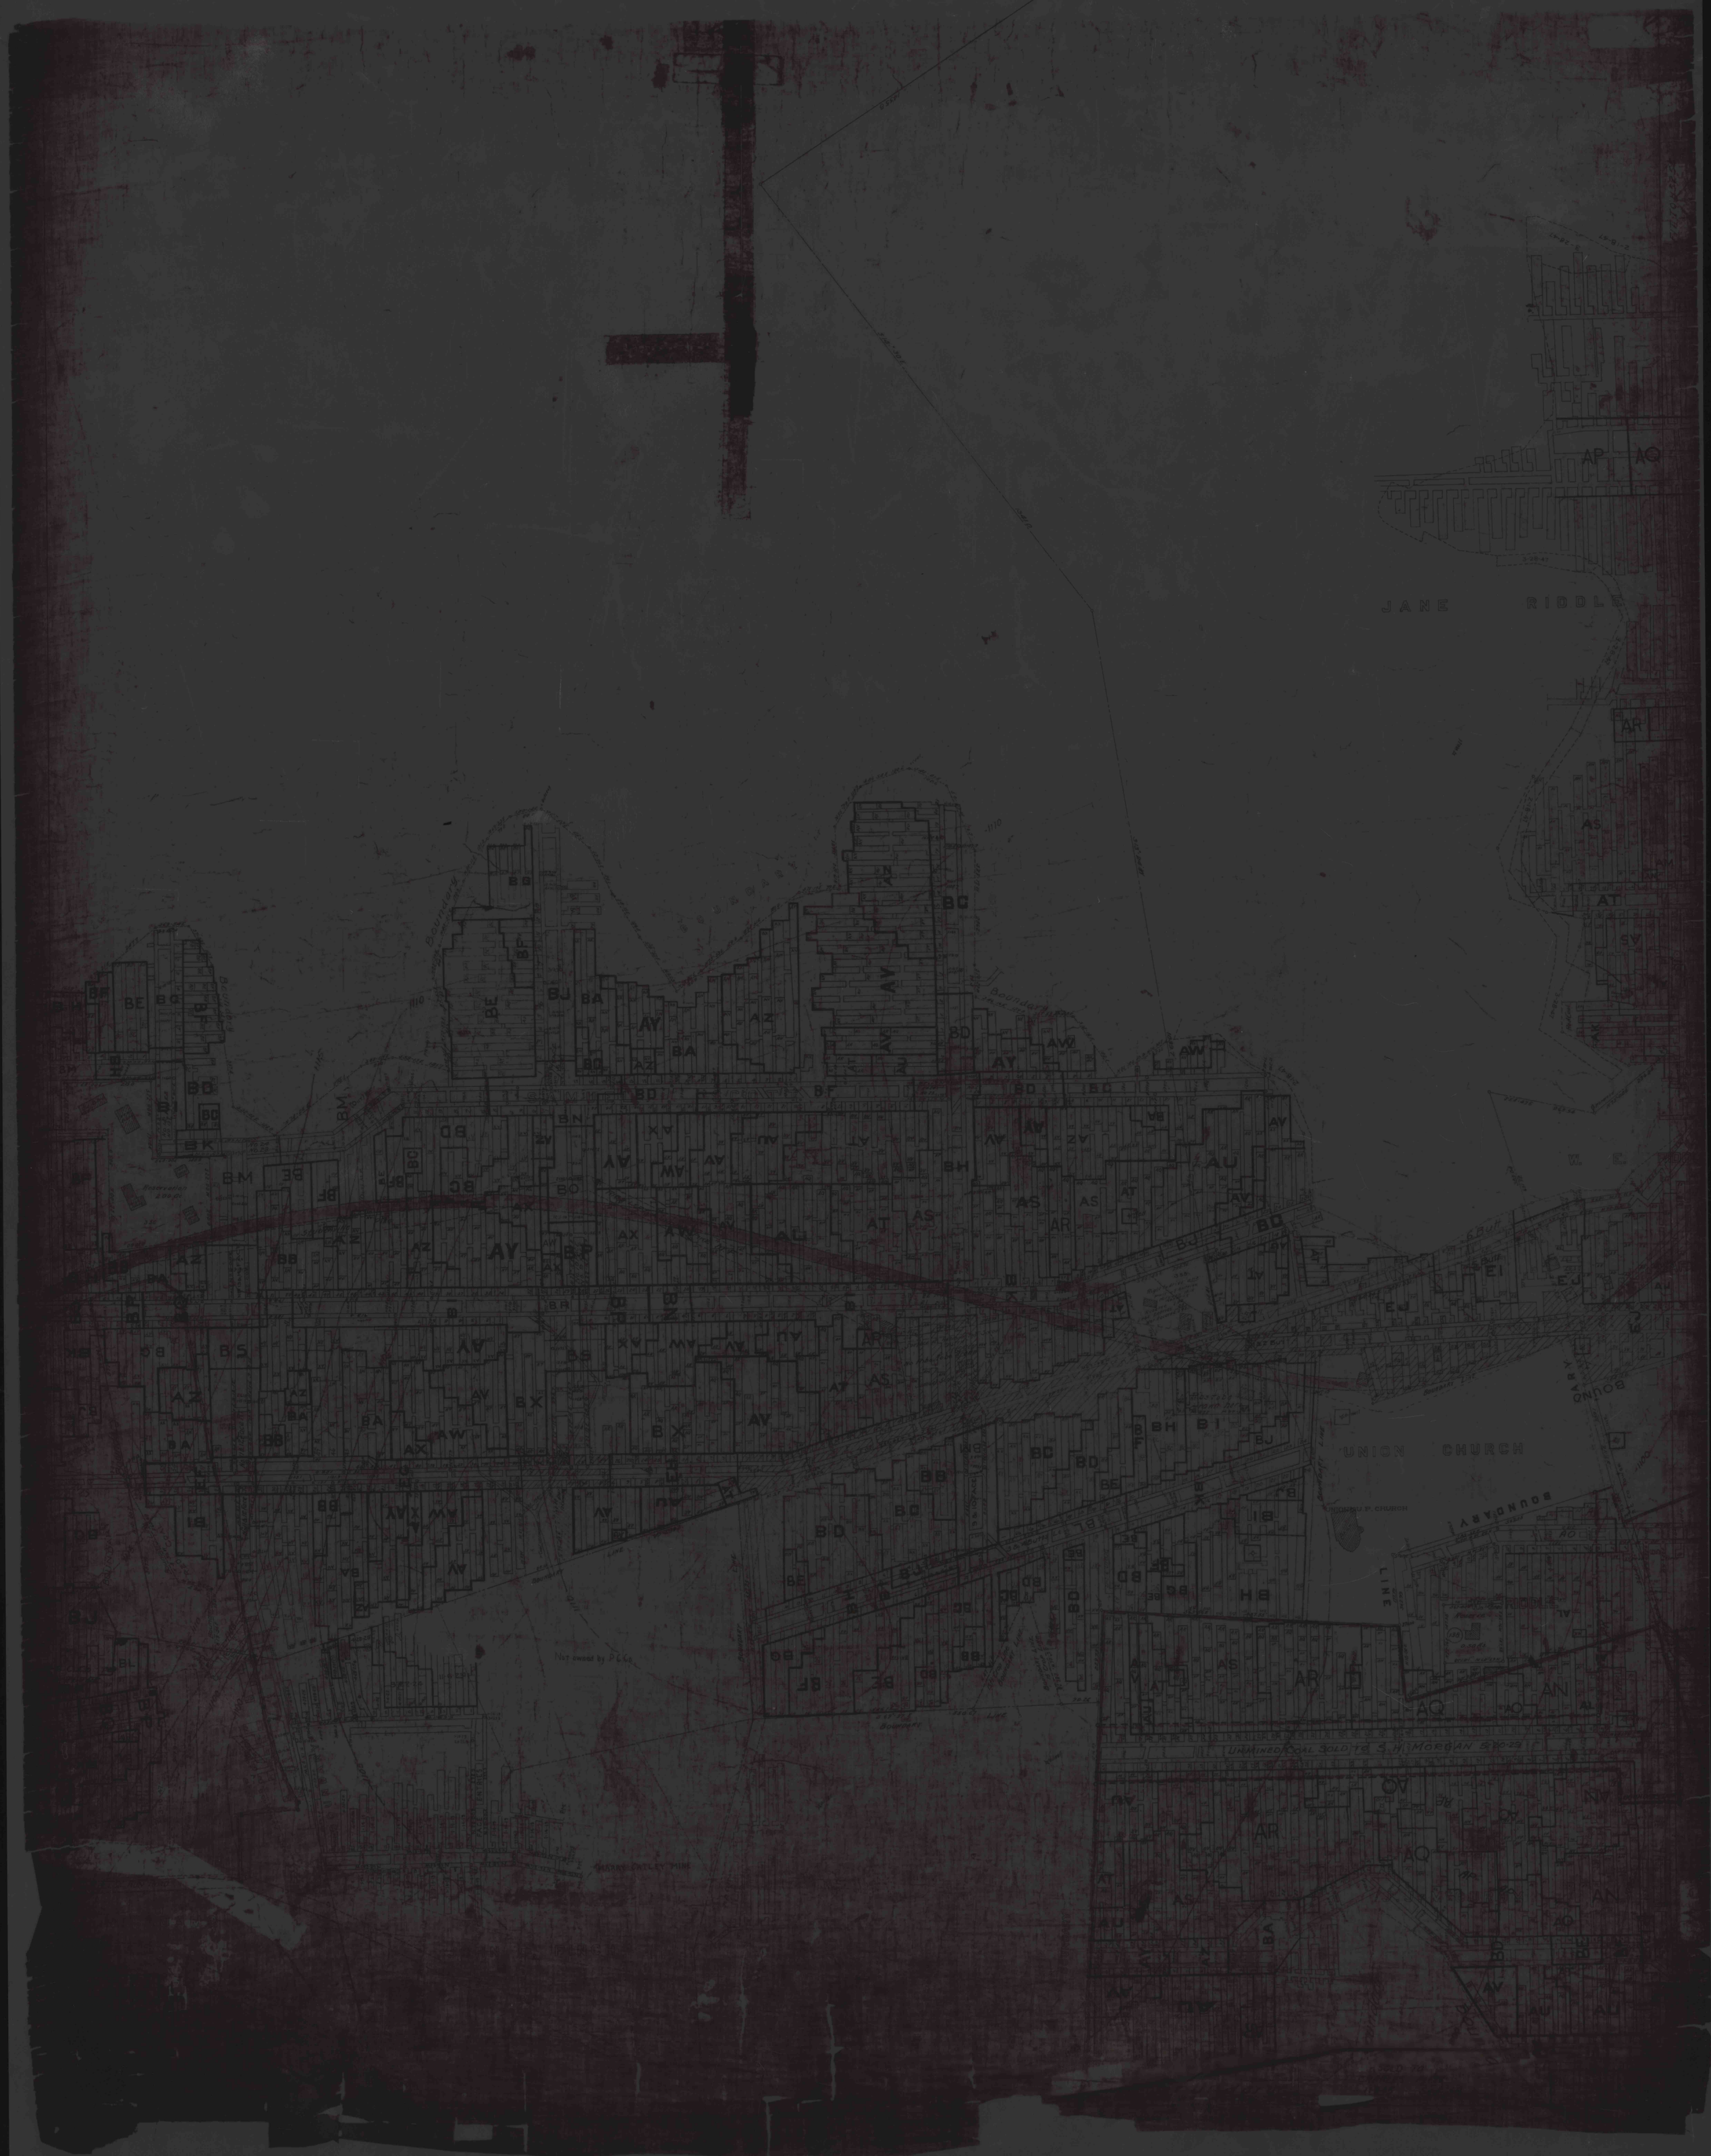
JANE
RIDDLE
UNION CHURCH
BOUNDARY
LINE
UNMINED COAL SOLD TO S. H. MORGAN 5-20-29
Not owned by P.C.Co.