


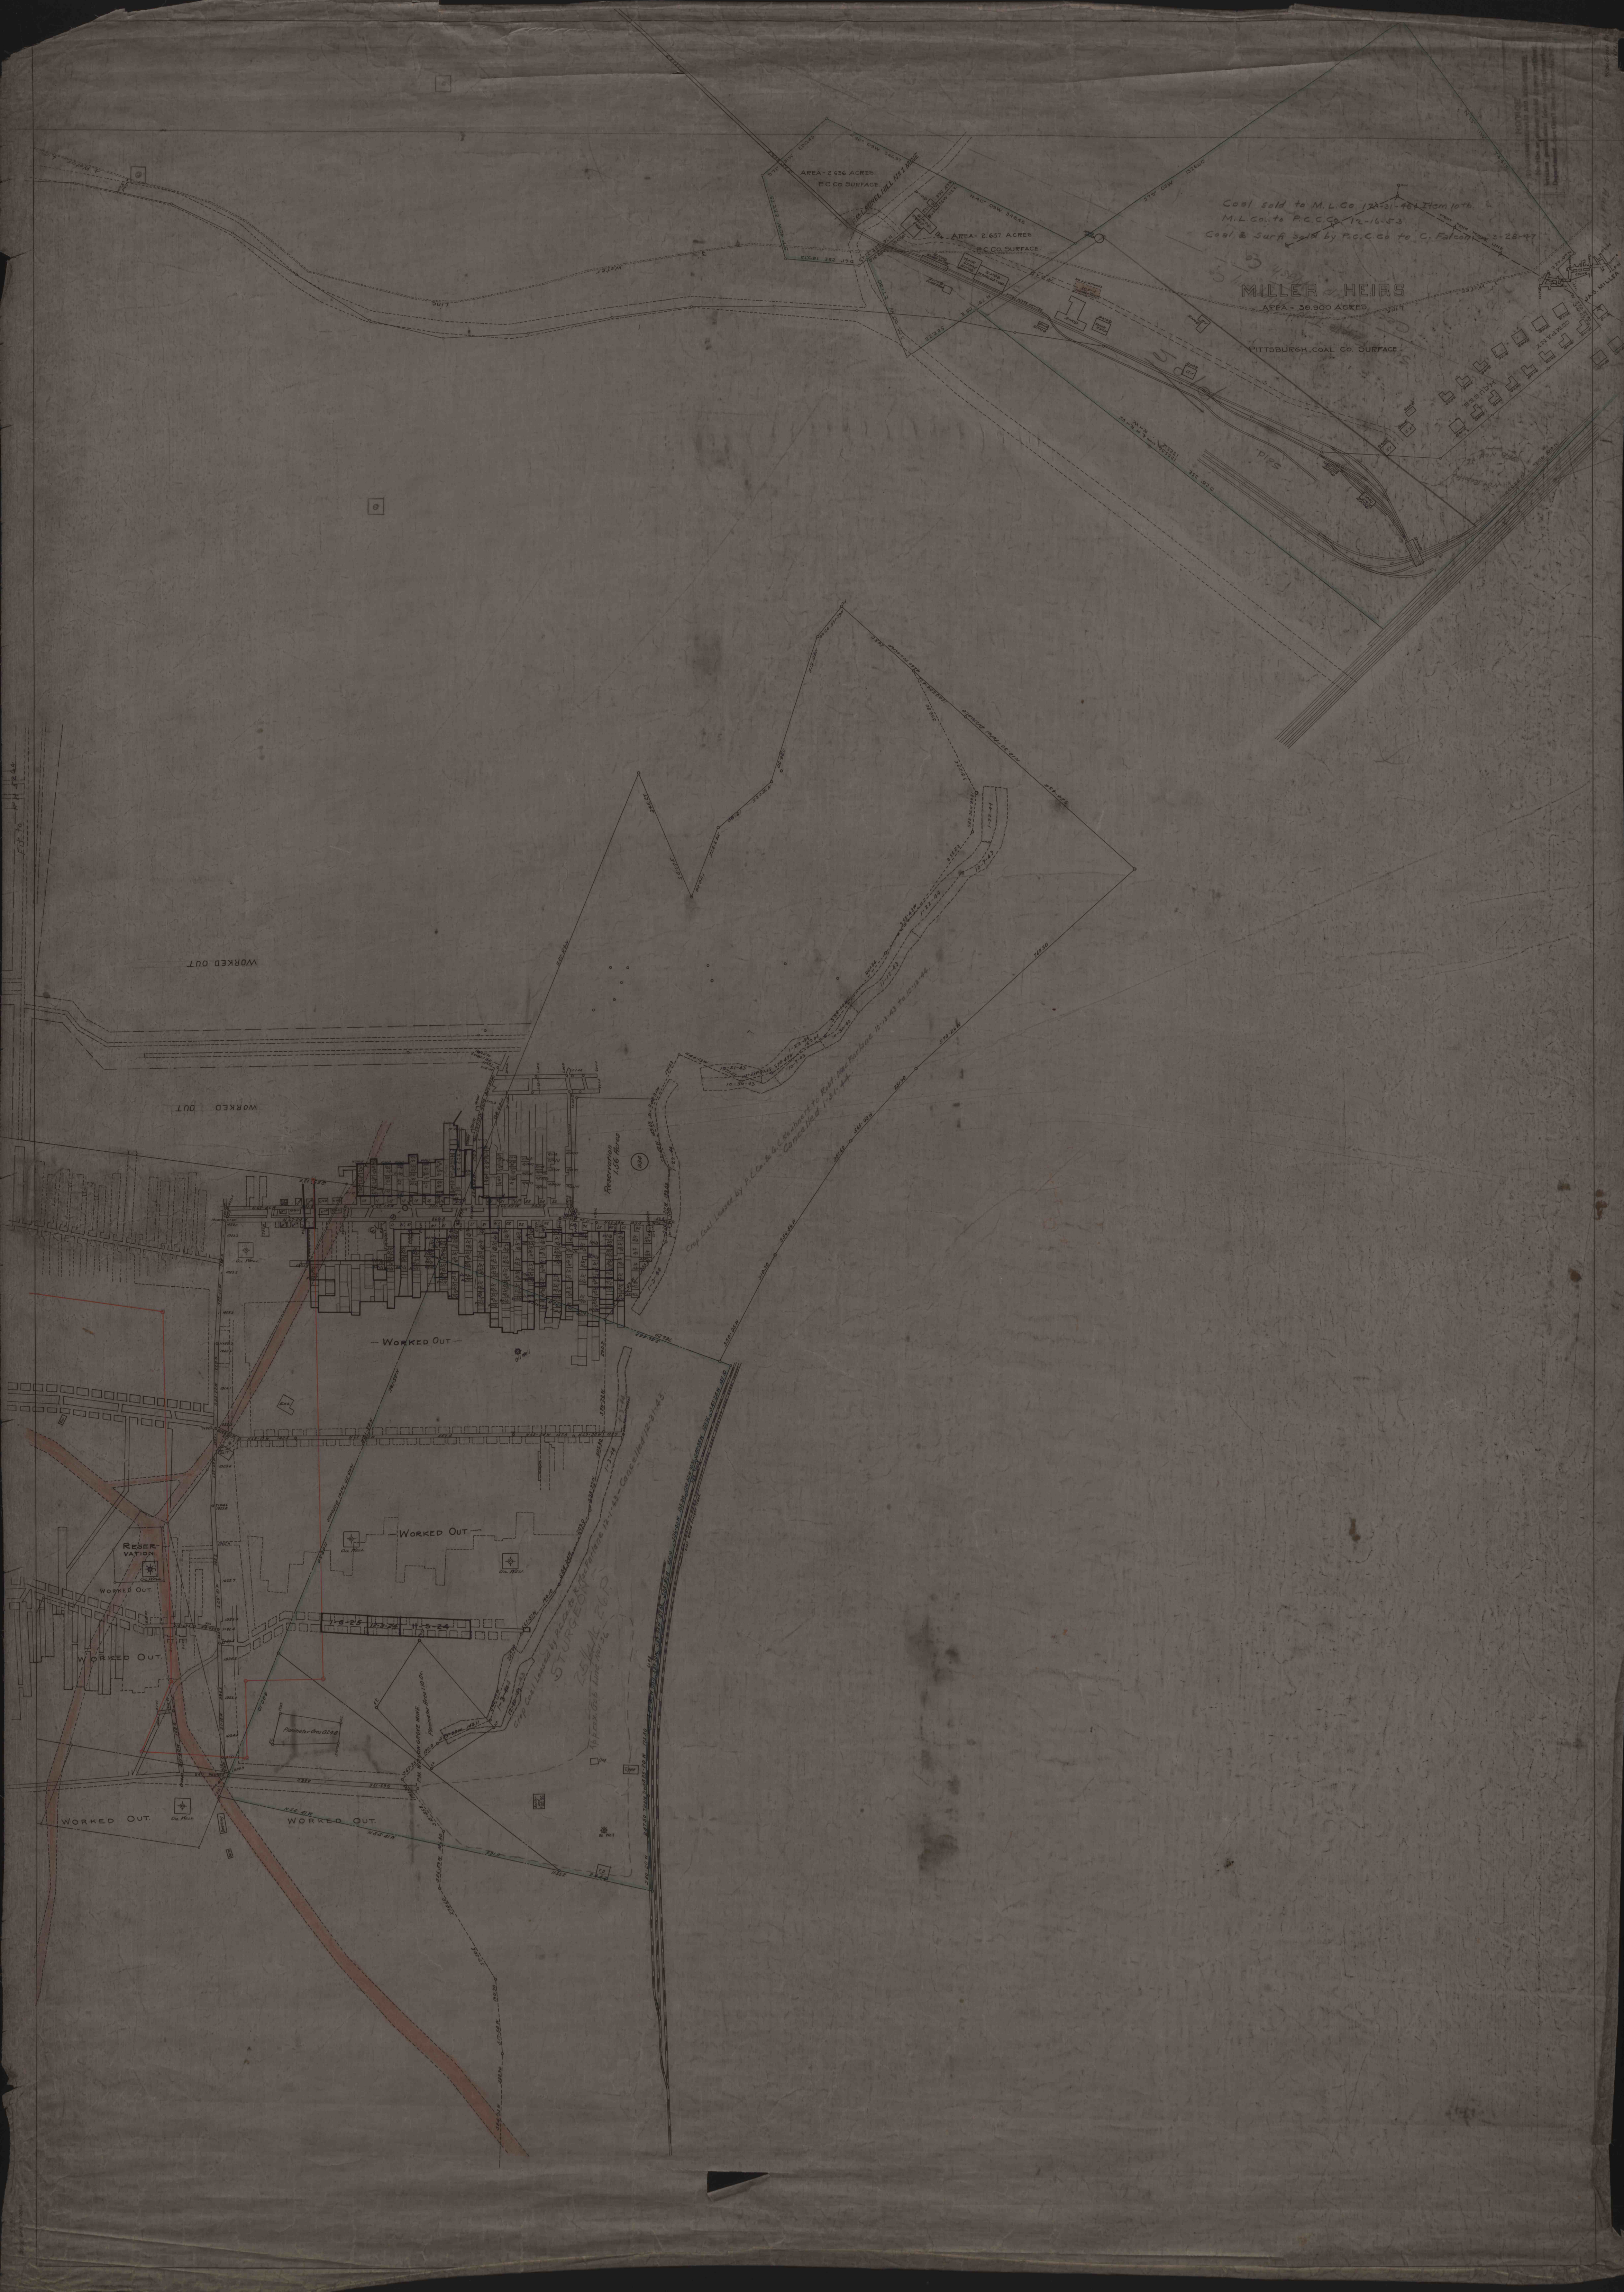

Coal sold to M.L.Co 12-15-1906  
M.L.Co. to P.C.C. 12-16-03  
Coal & Surf sold by P.C.C. to C. Falcon 2-28-07

MILLER HEIRS  
AREA - 36,900 ACRES

PITTSBURGH COAL CO. SURFACE

Reservation  
168 Acres

STURGEON  
25th & 4th  
P.P.