


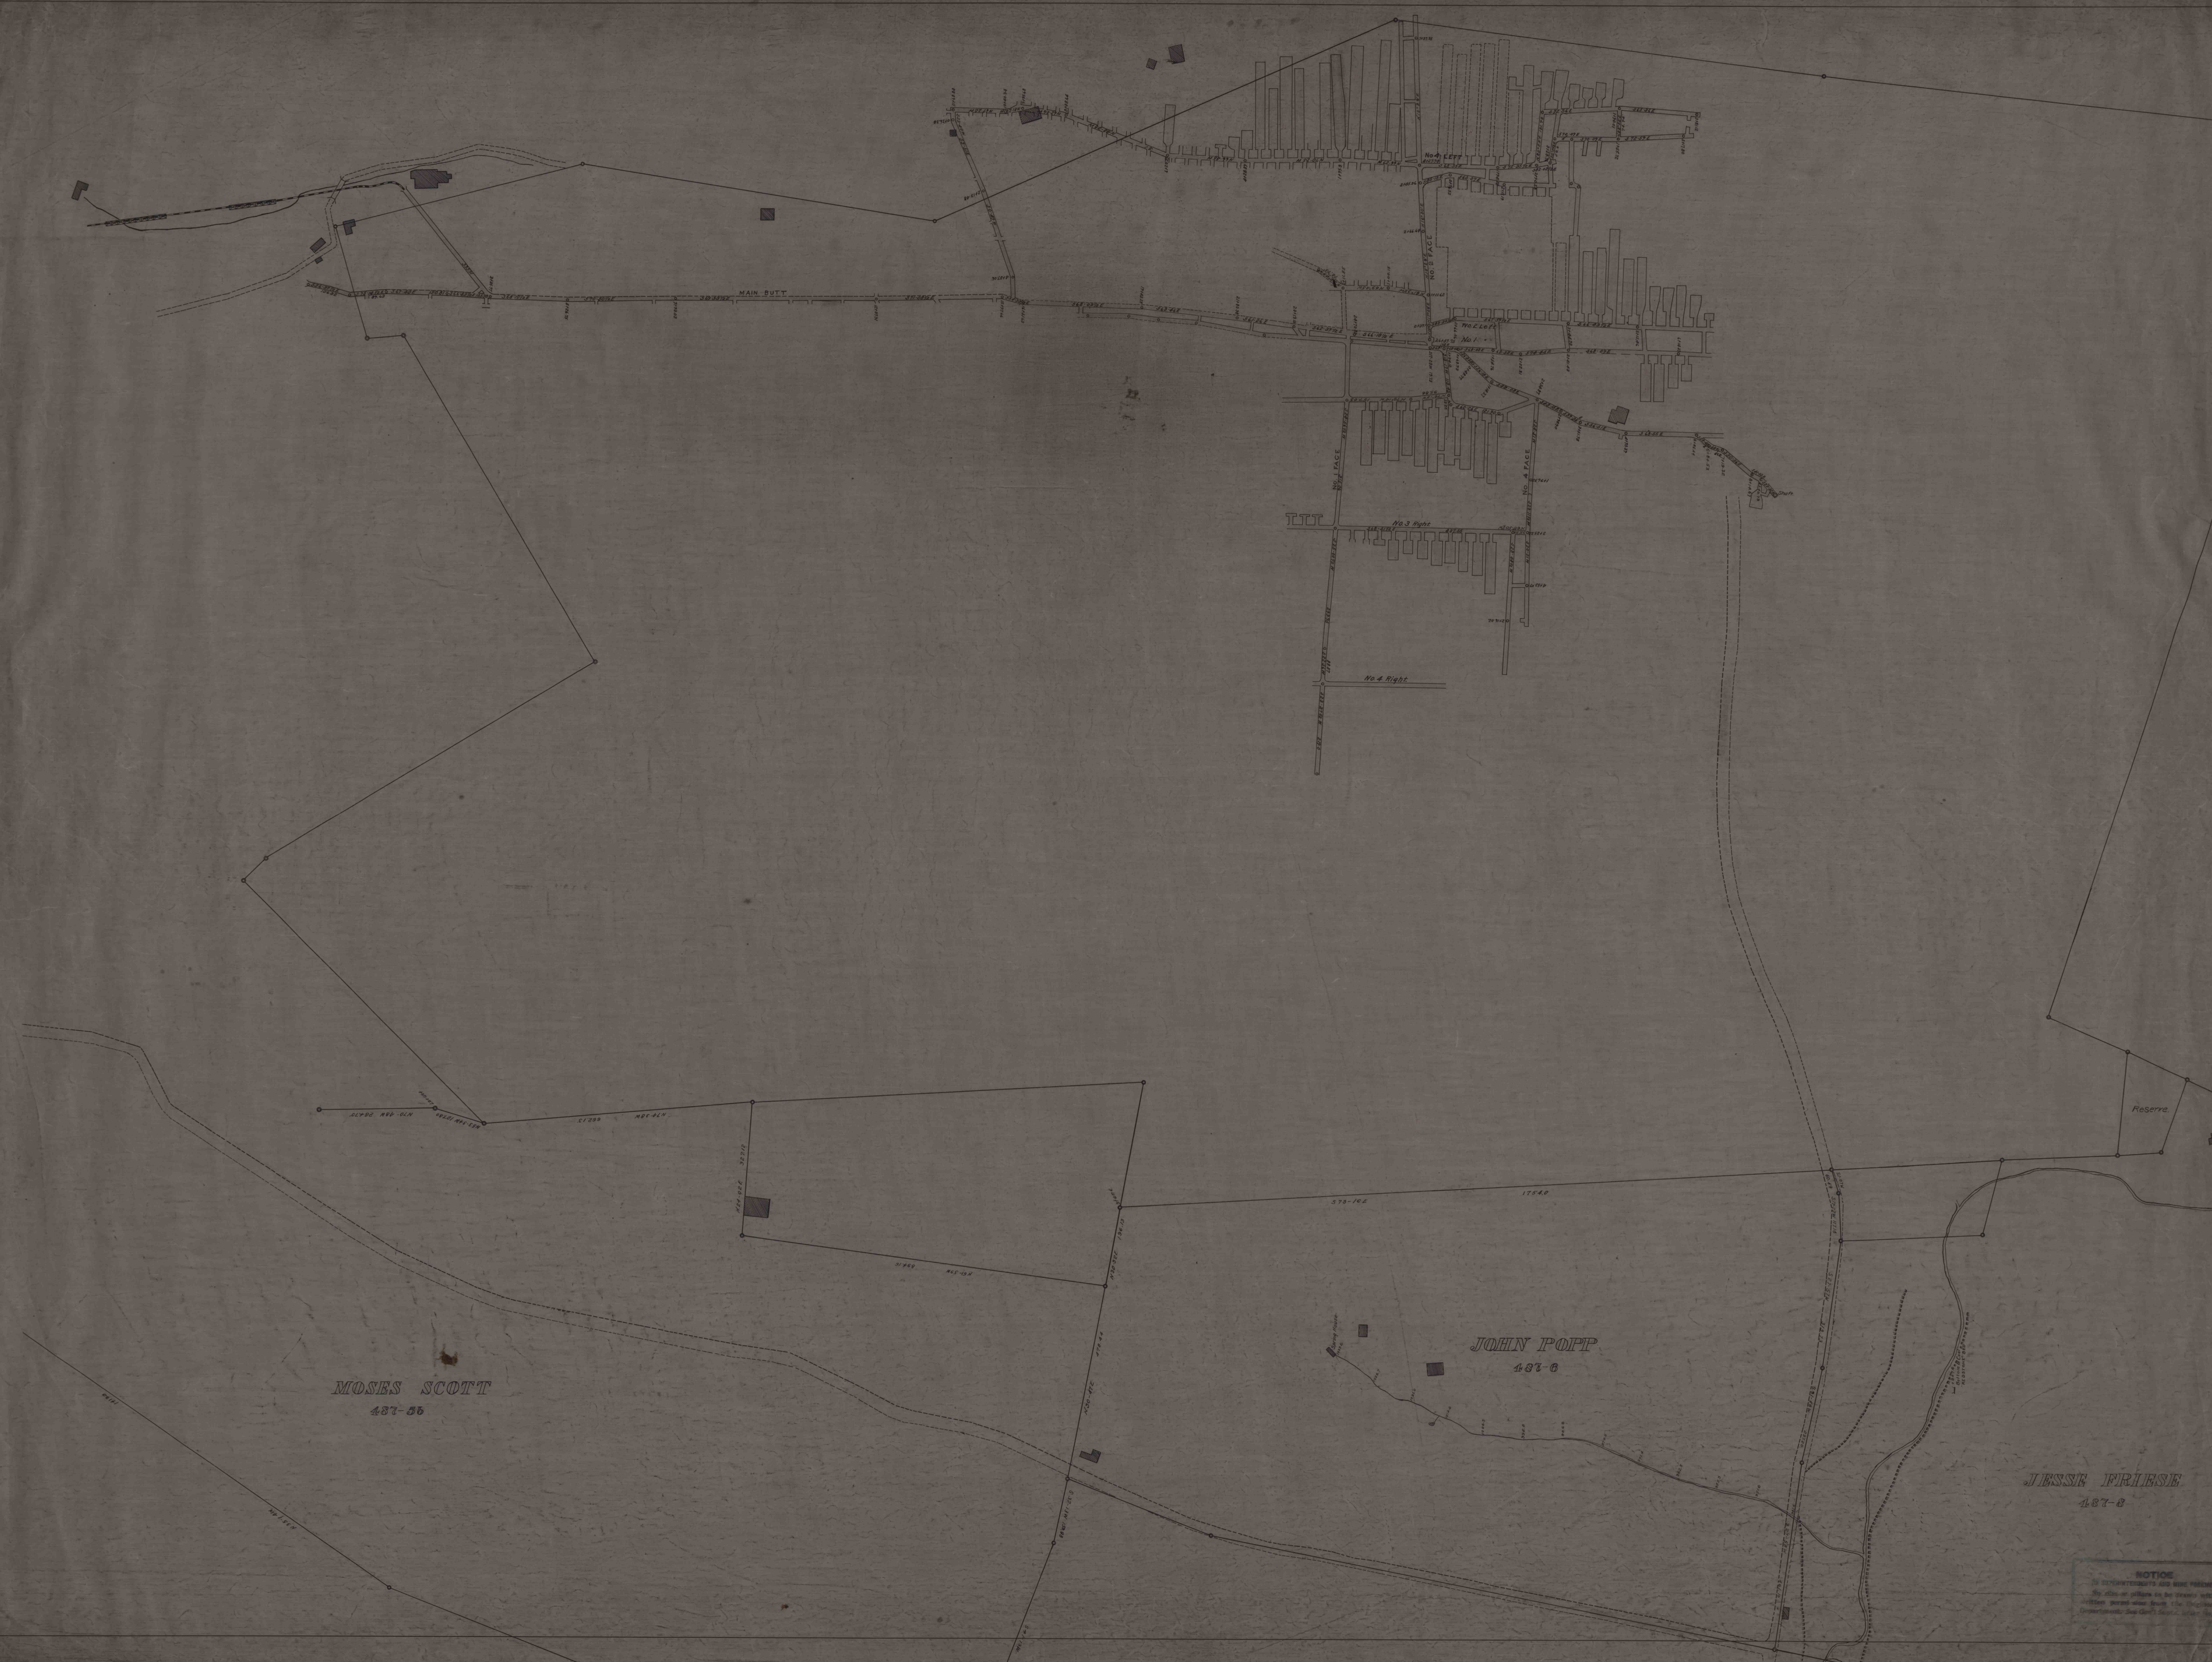

MOSES SCOTT
487-56

JOHN POPP
487-6

JESSE FRIESE
487-8

NOTICE
