


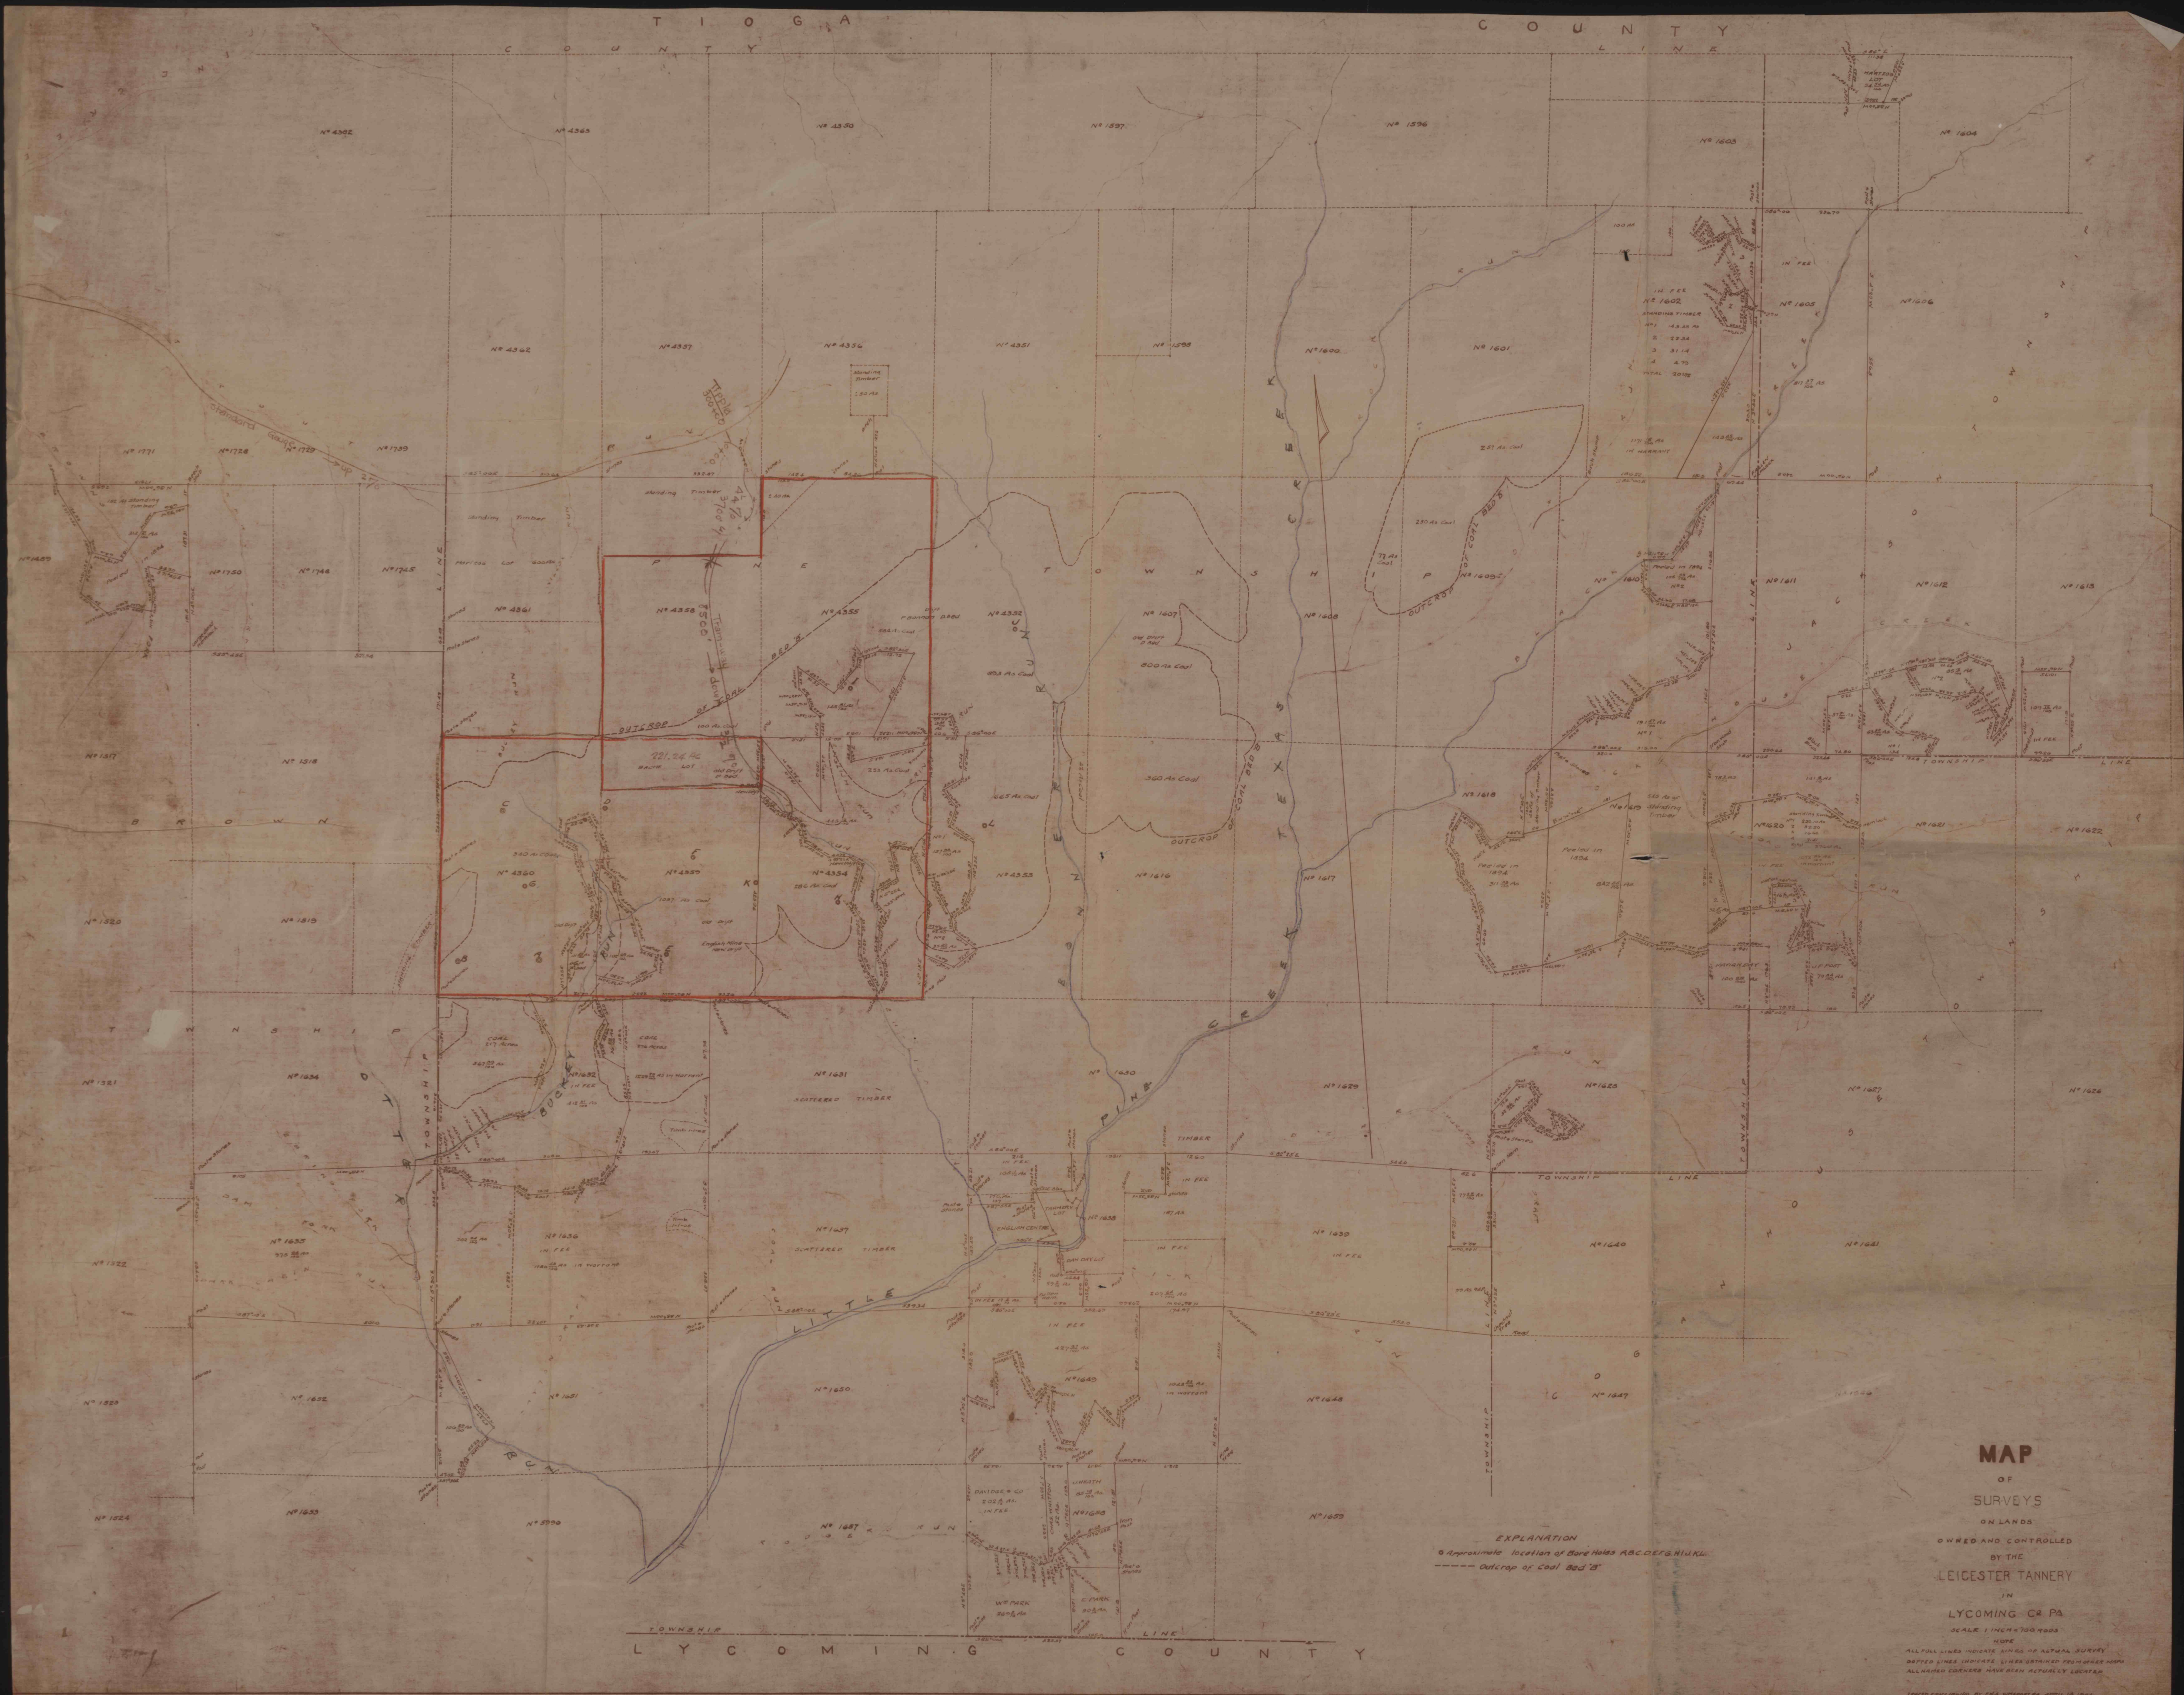

MAP
OF
SURVEYS

ON LANDS
OWNED AND CONTROLLED
BY THE
LEICESTER TANNERY
IN
LYCOMING & PA
SCALE 1 INCH = 700 FEET

EXPLANATION
- - - - - Outcrop of coal bed 'B'

ALL FULL LINES INDICATE LINES OF ACTUAL SURVEY
DOTTED LINES INDICATE LINES OBTAINED FROM OTHER SOURCES
ALL CORNERS HAVE BEEN ACTUALLY LOCATED
