


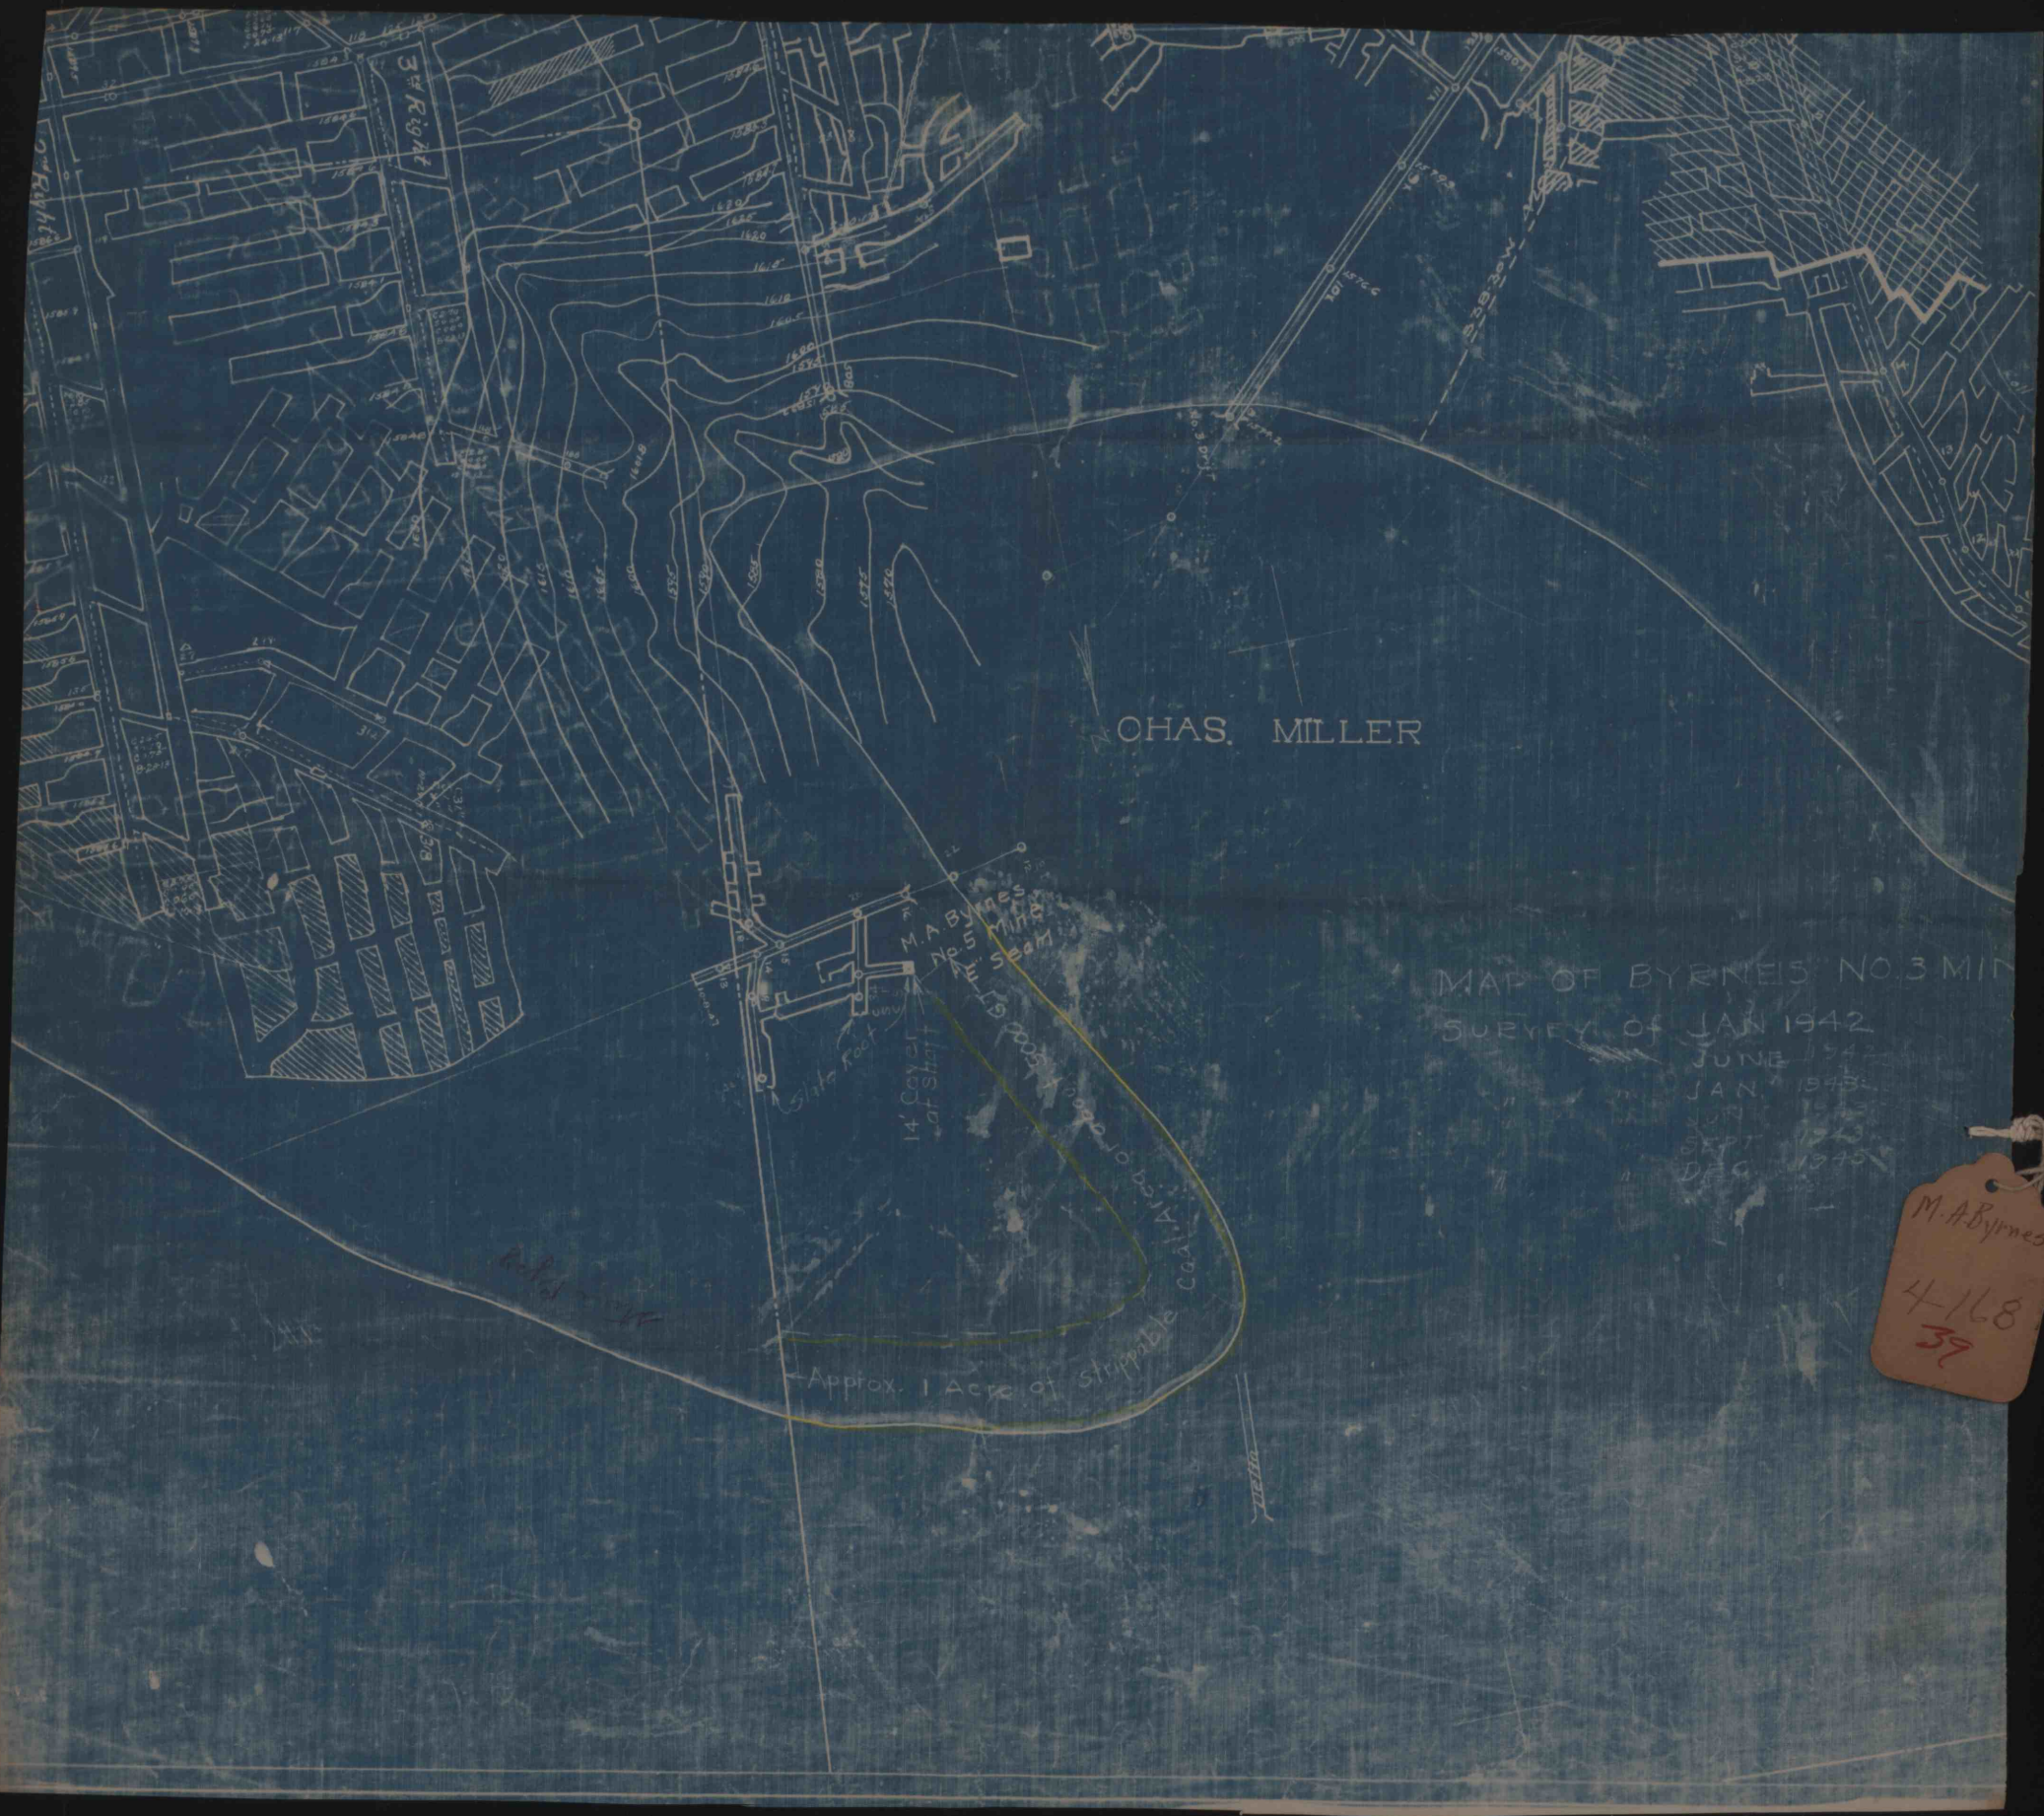

CHAS. MILLER

MAP OF BYRNEIS NO. 3 MIN

SURVEY OF JAN 1942

JUNE 1942

JAN 1943

JUN 1943

SEPT 1943

DEC 1943

M.A. Byrnes

4-168

39