


Compare result with map of 1926
with consent of C.R.C. Population, June 3, 1926

D.M. we
Anthony
Anna
0-1

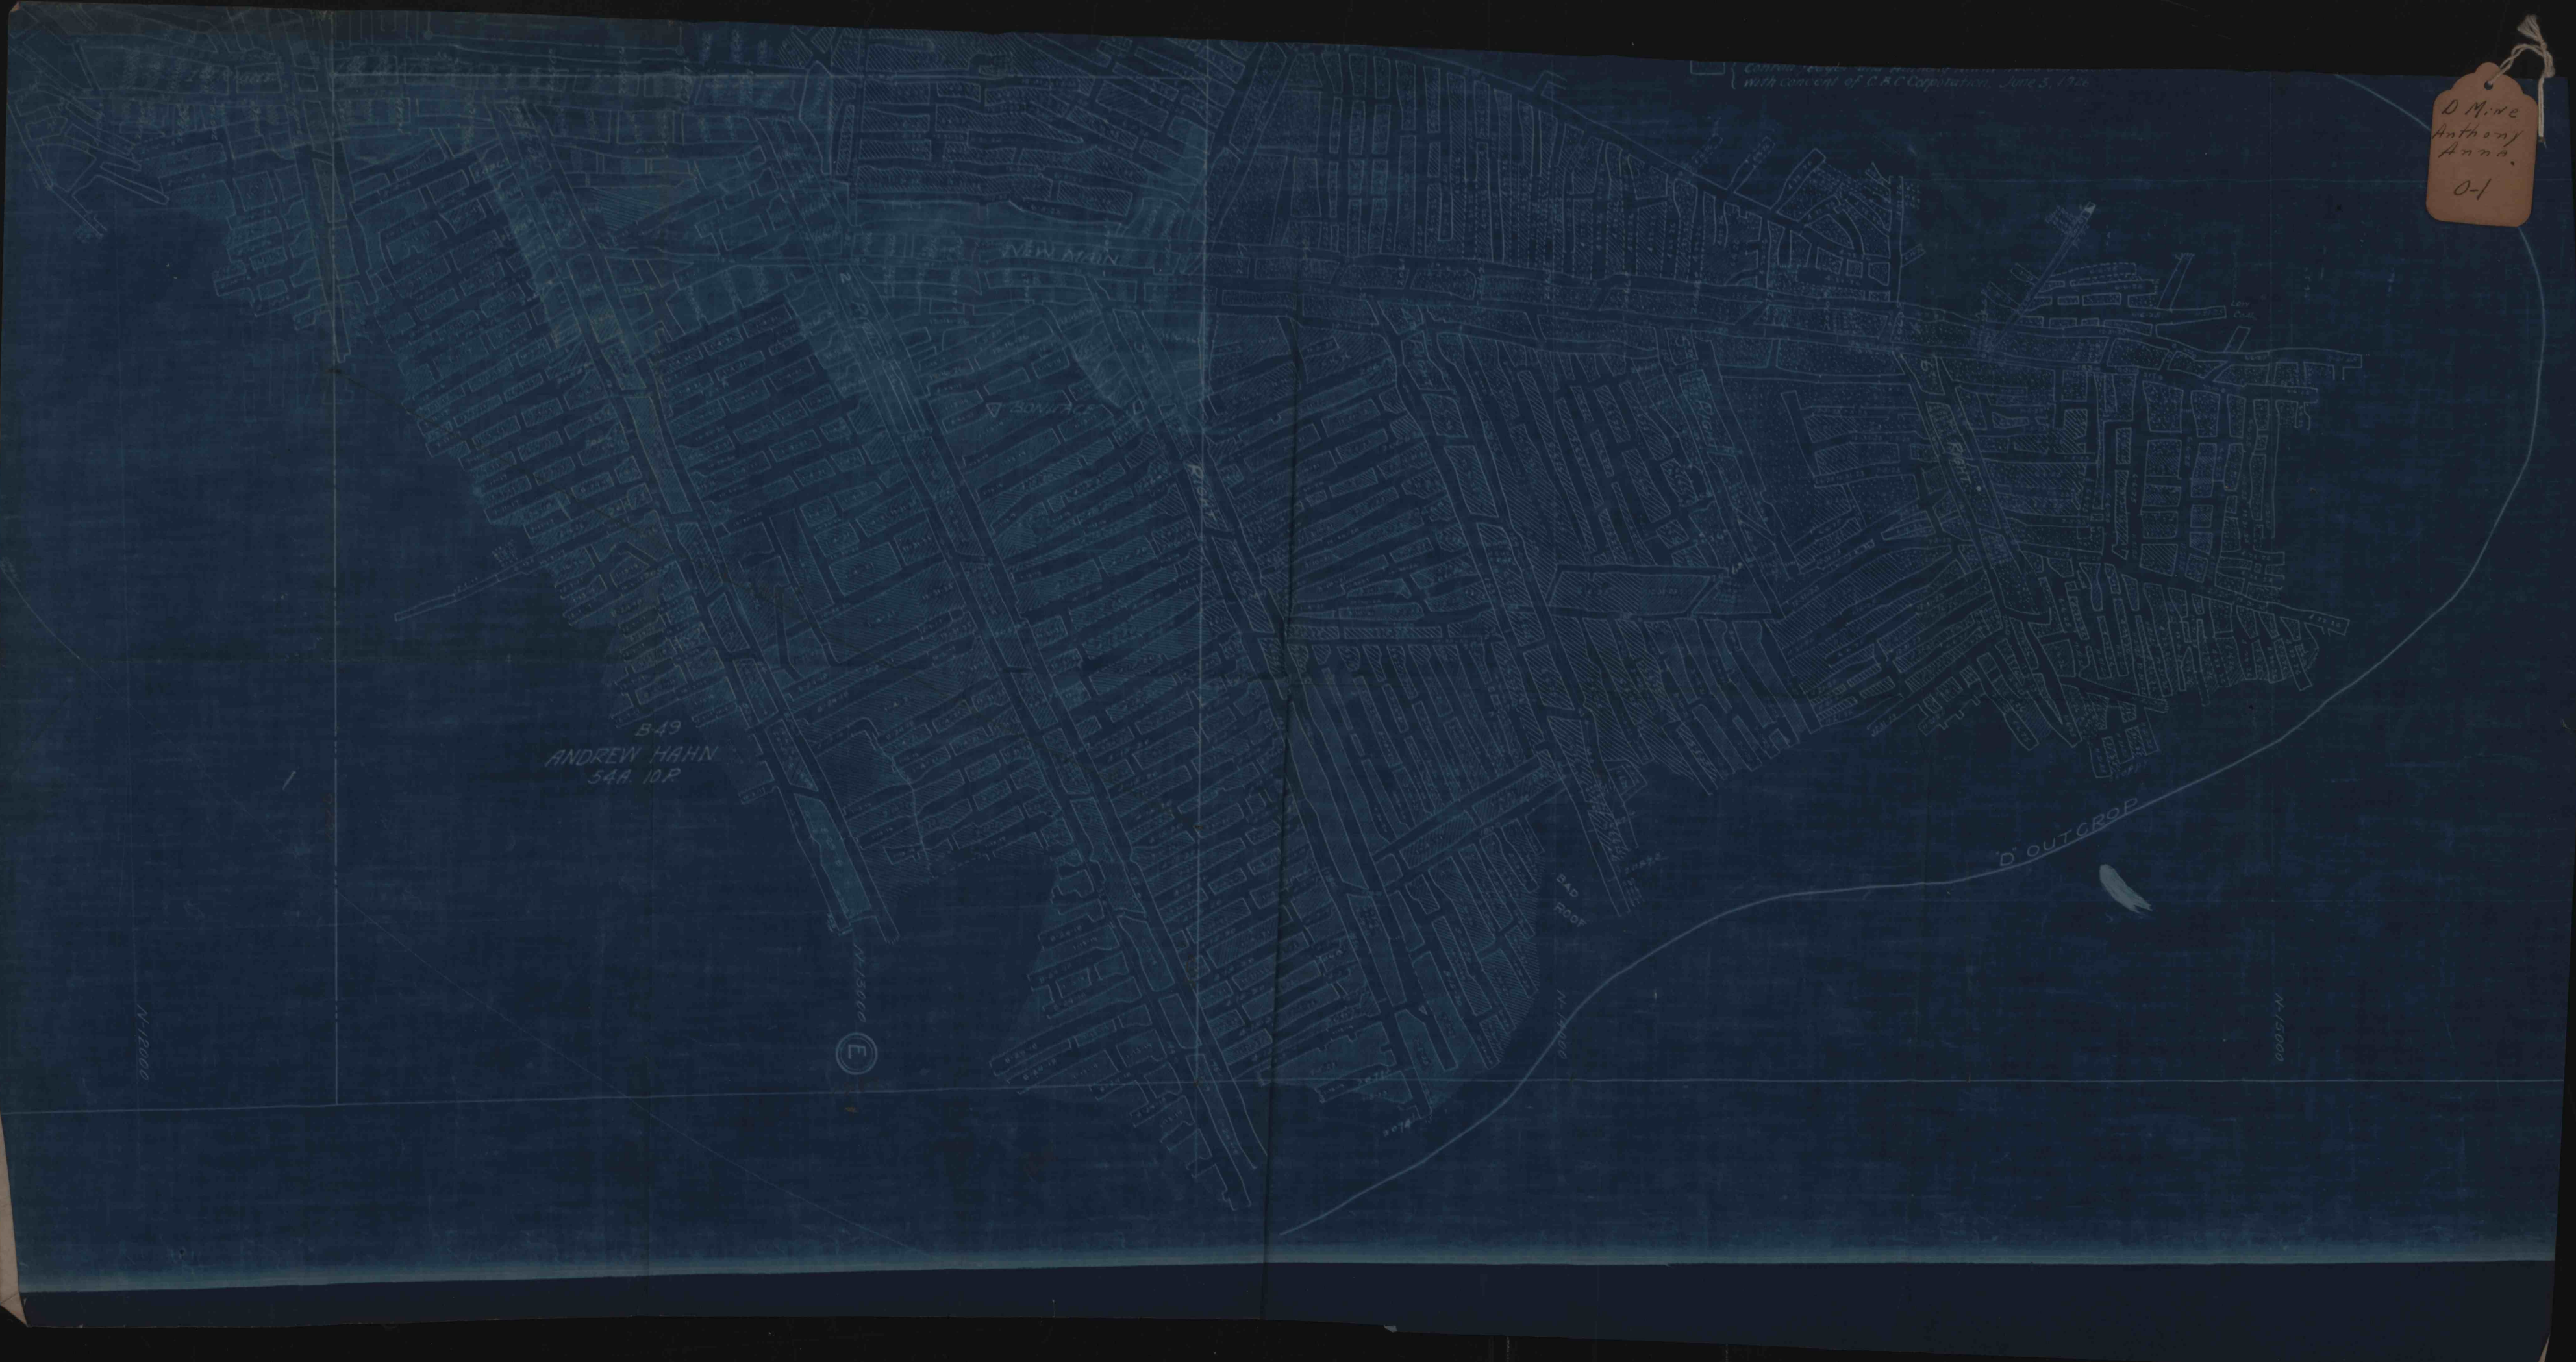

B-49
ANDREW HAHN
548. 10.P

D' OUTCROP

(E)