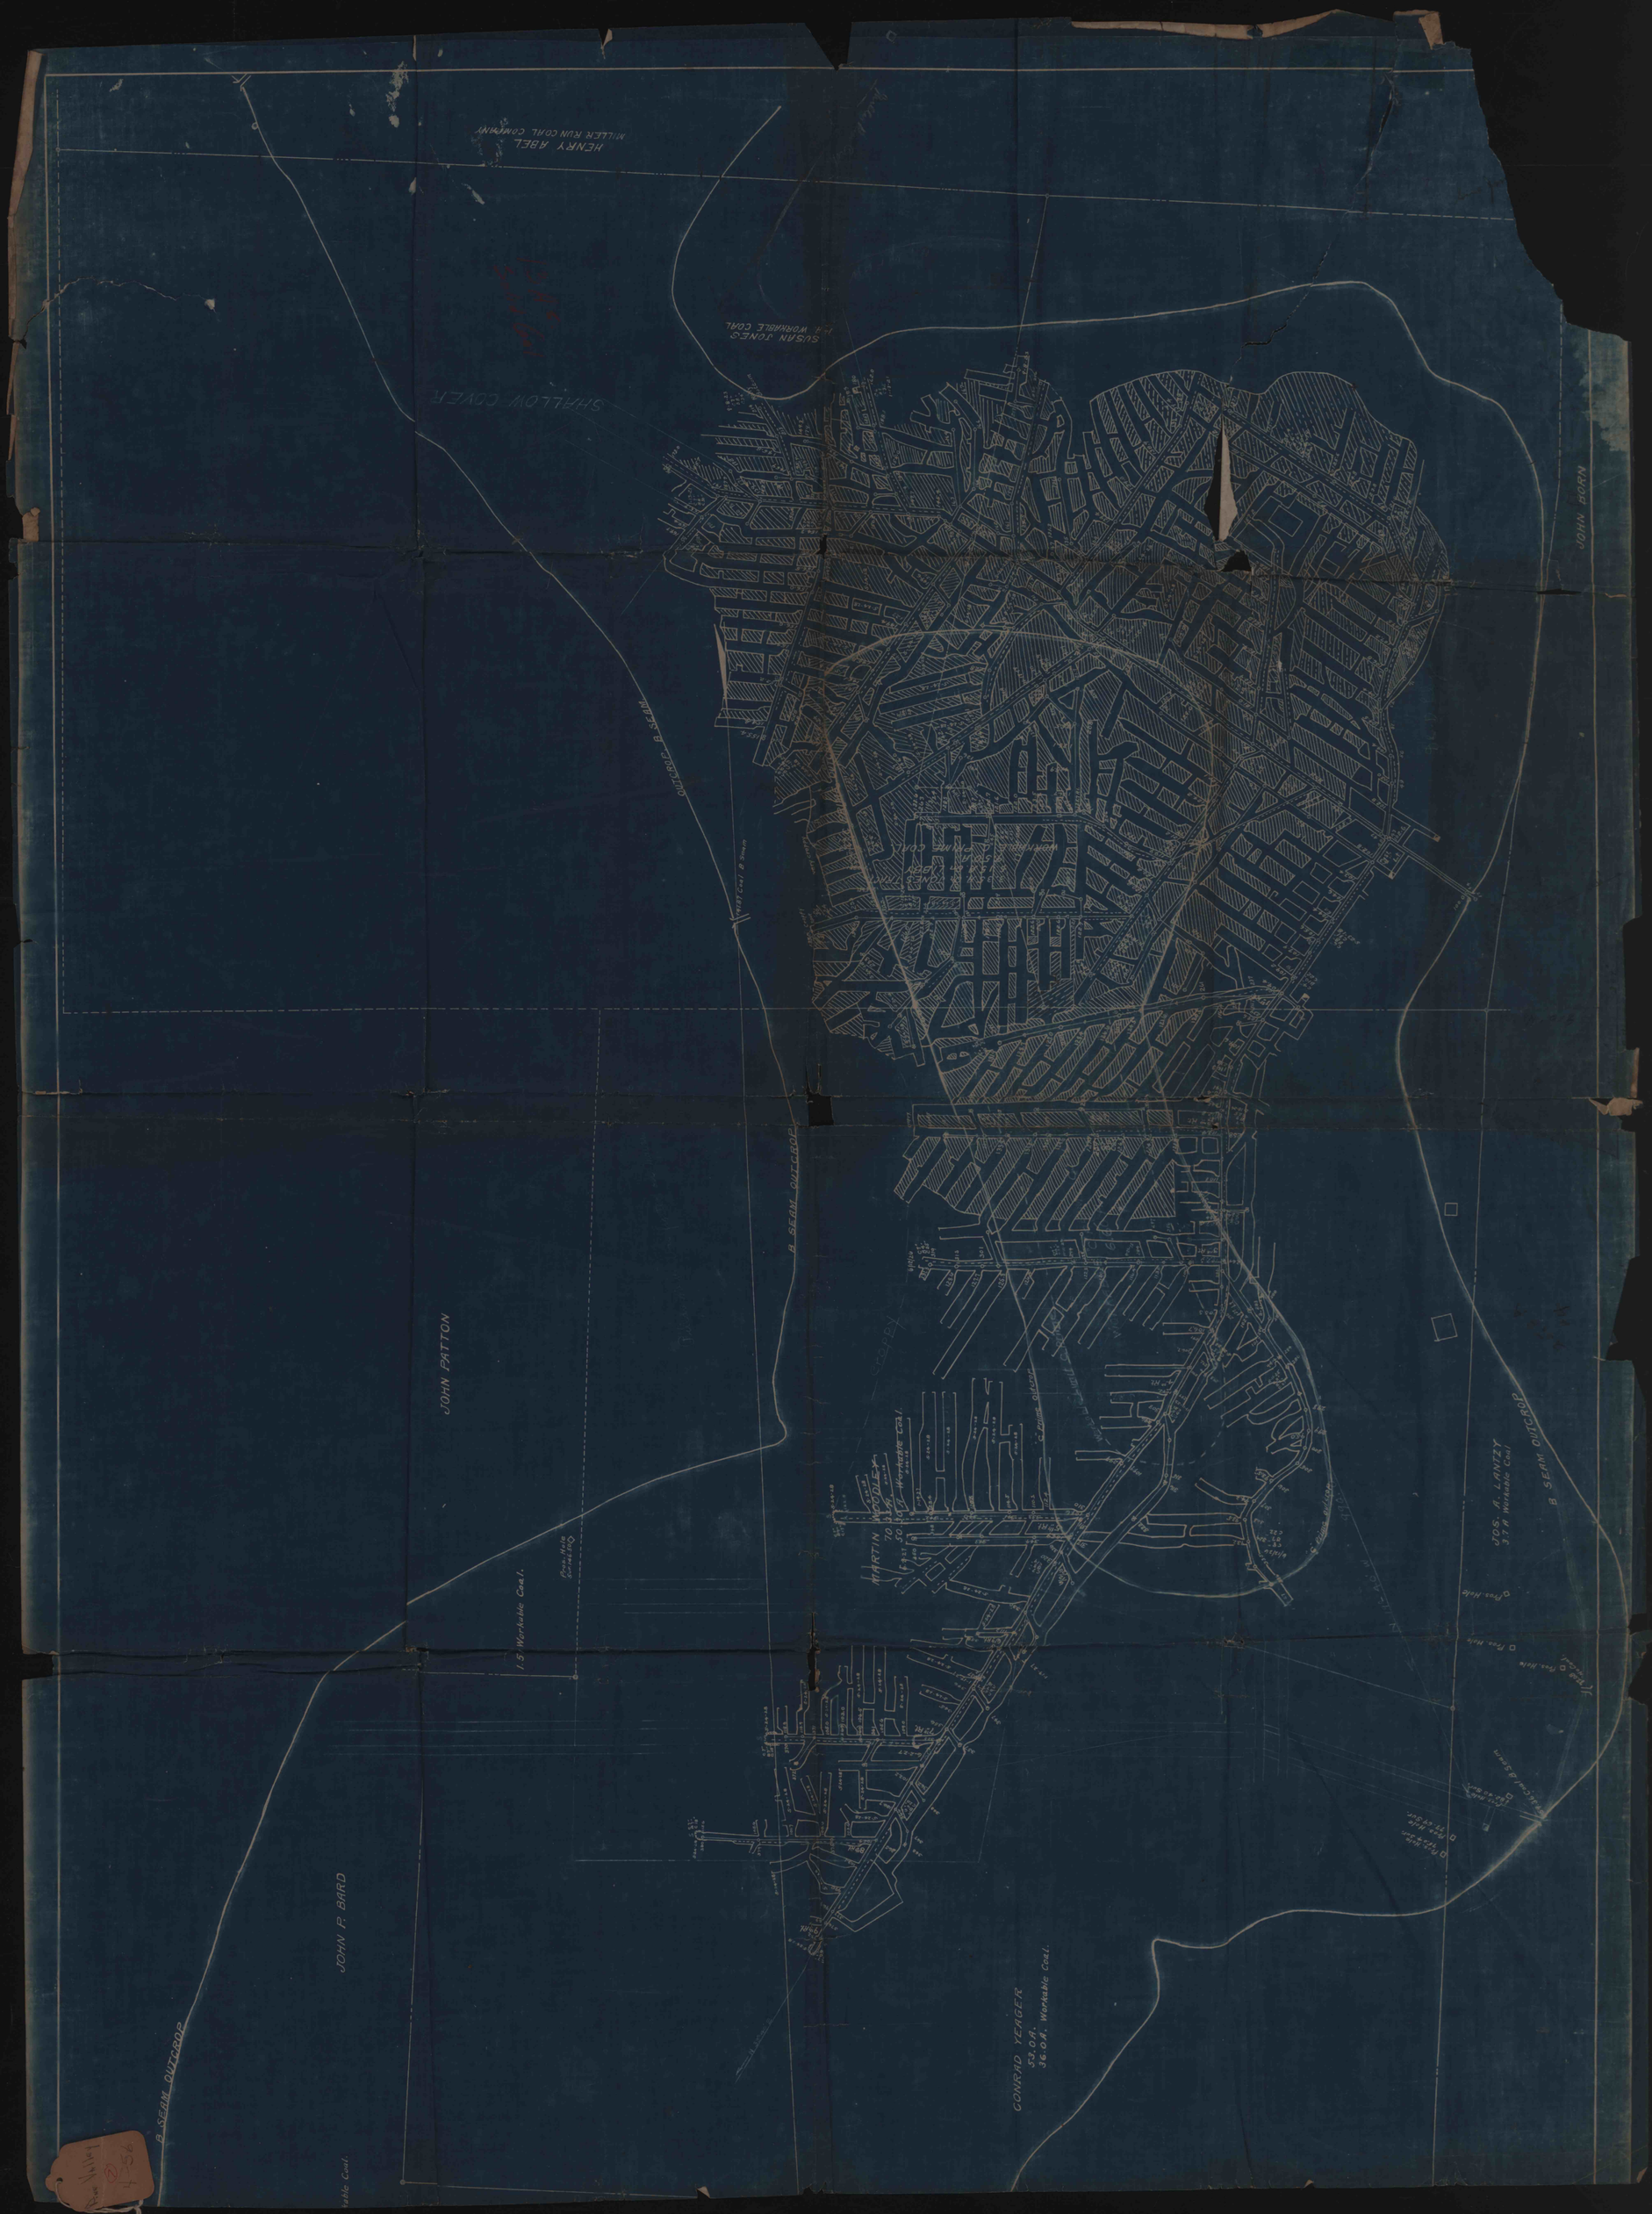
HENRY ABEL
MILLER RUN COAL COMPANY
SUSAN JONES
1.4 WORKABLE COAL
SHALLOW COVER
JOHN BOHN
OUTCROP A SEAM
JOHN PATTON
1.5 Workable Coal.
B SEAM OUTCROP
MARTIN WOODLE
70.0 A.
30.0 A. Workable Coal.
JOS. A. LANTZY
37.0 A. Workable Coal
B SEAM OUTCROP
JOHN P. BARD
B SEAM OUTCROP
CONRAD YERGER
53.0 A.
36.0 A. Workable Coal.