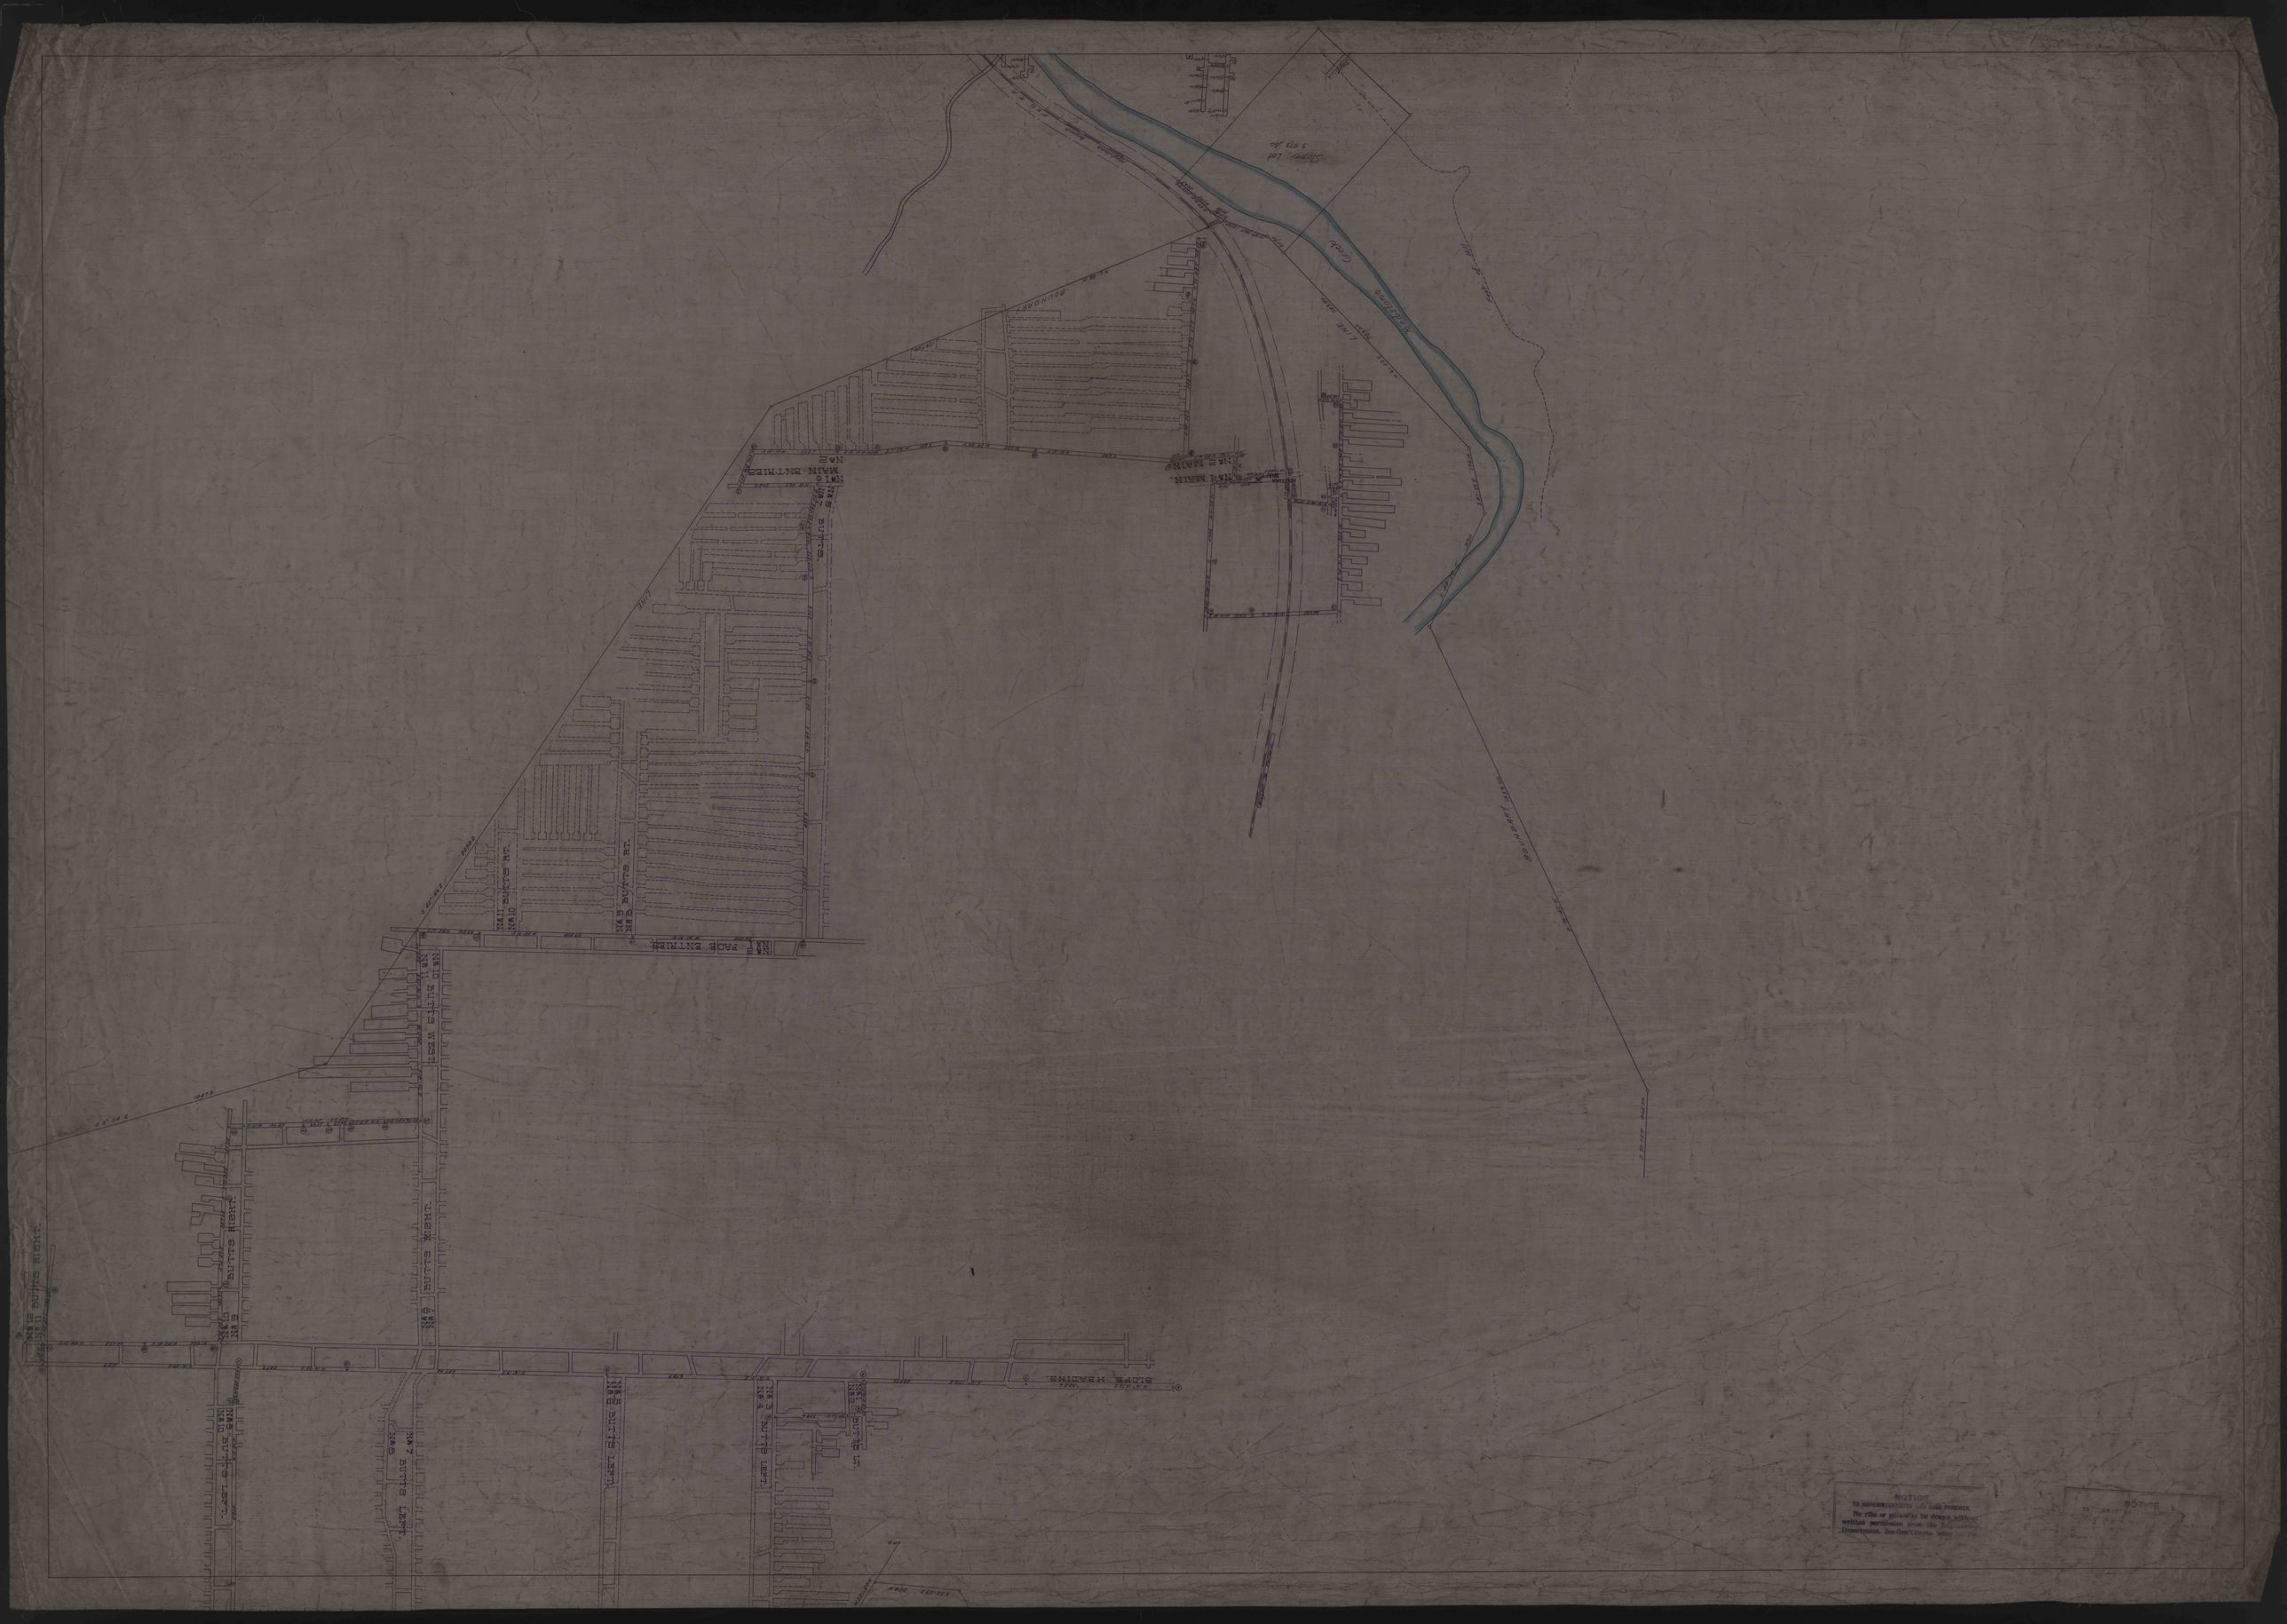
NO 1 BUTTE WEST
NO 1 MAIN ENTRIES
NO 2 MAIN ENTRIES
NO 1 MAIN
SLOPE HEADING
