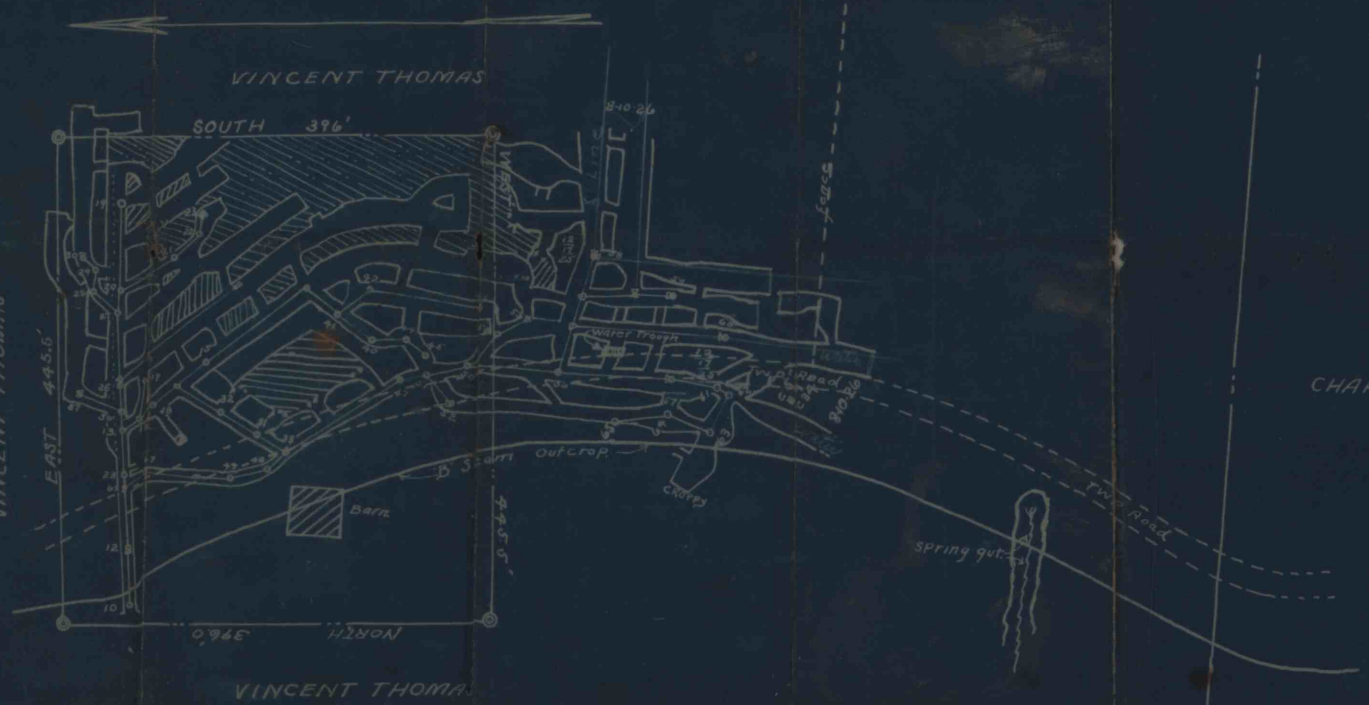

ALBAN DILLON MINE
IN
ELDER TOWNSHIP
JULY 1922 1" = 100'
"B" SEAM COAL
T.J. Pfeister Engr.

Miller Coal Co. Map
9