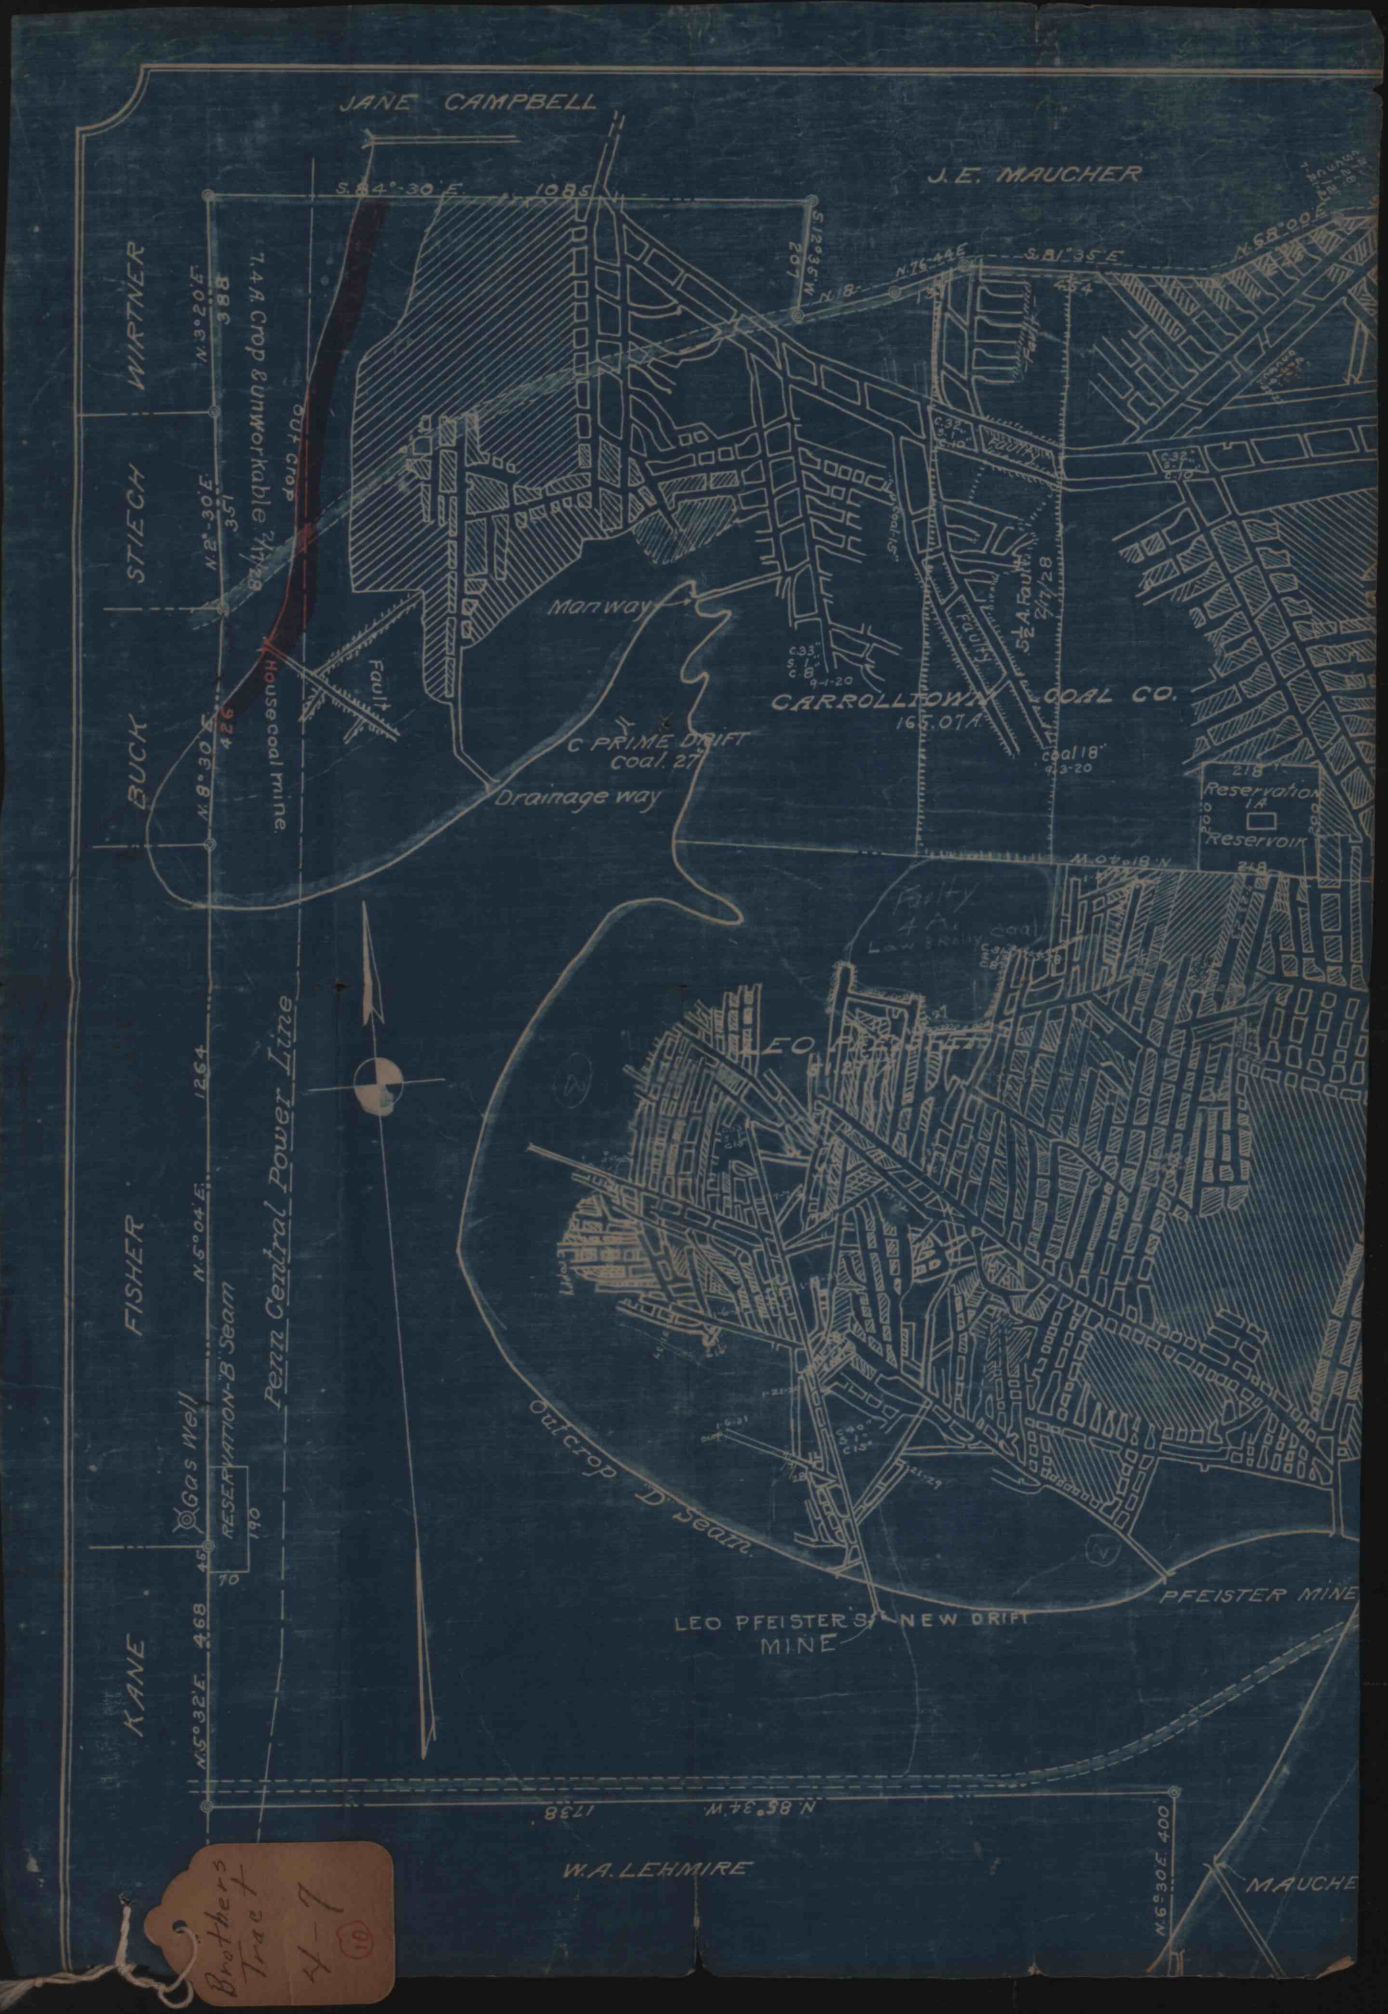

Brothers Tract 4-7