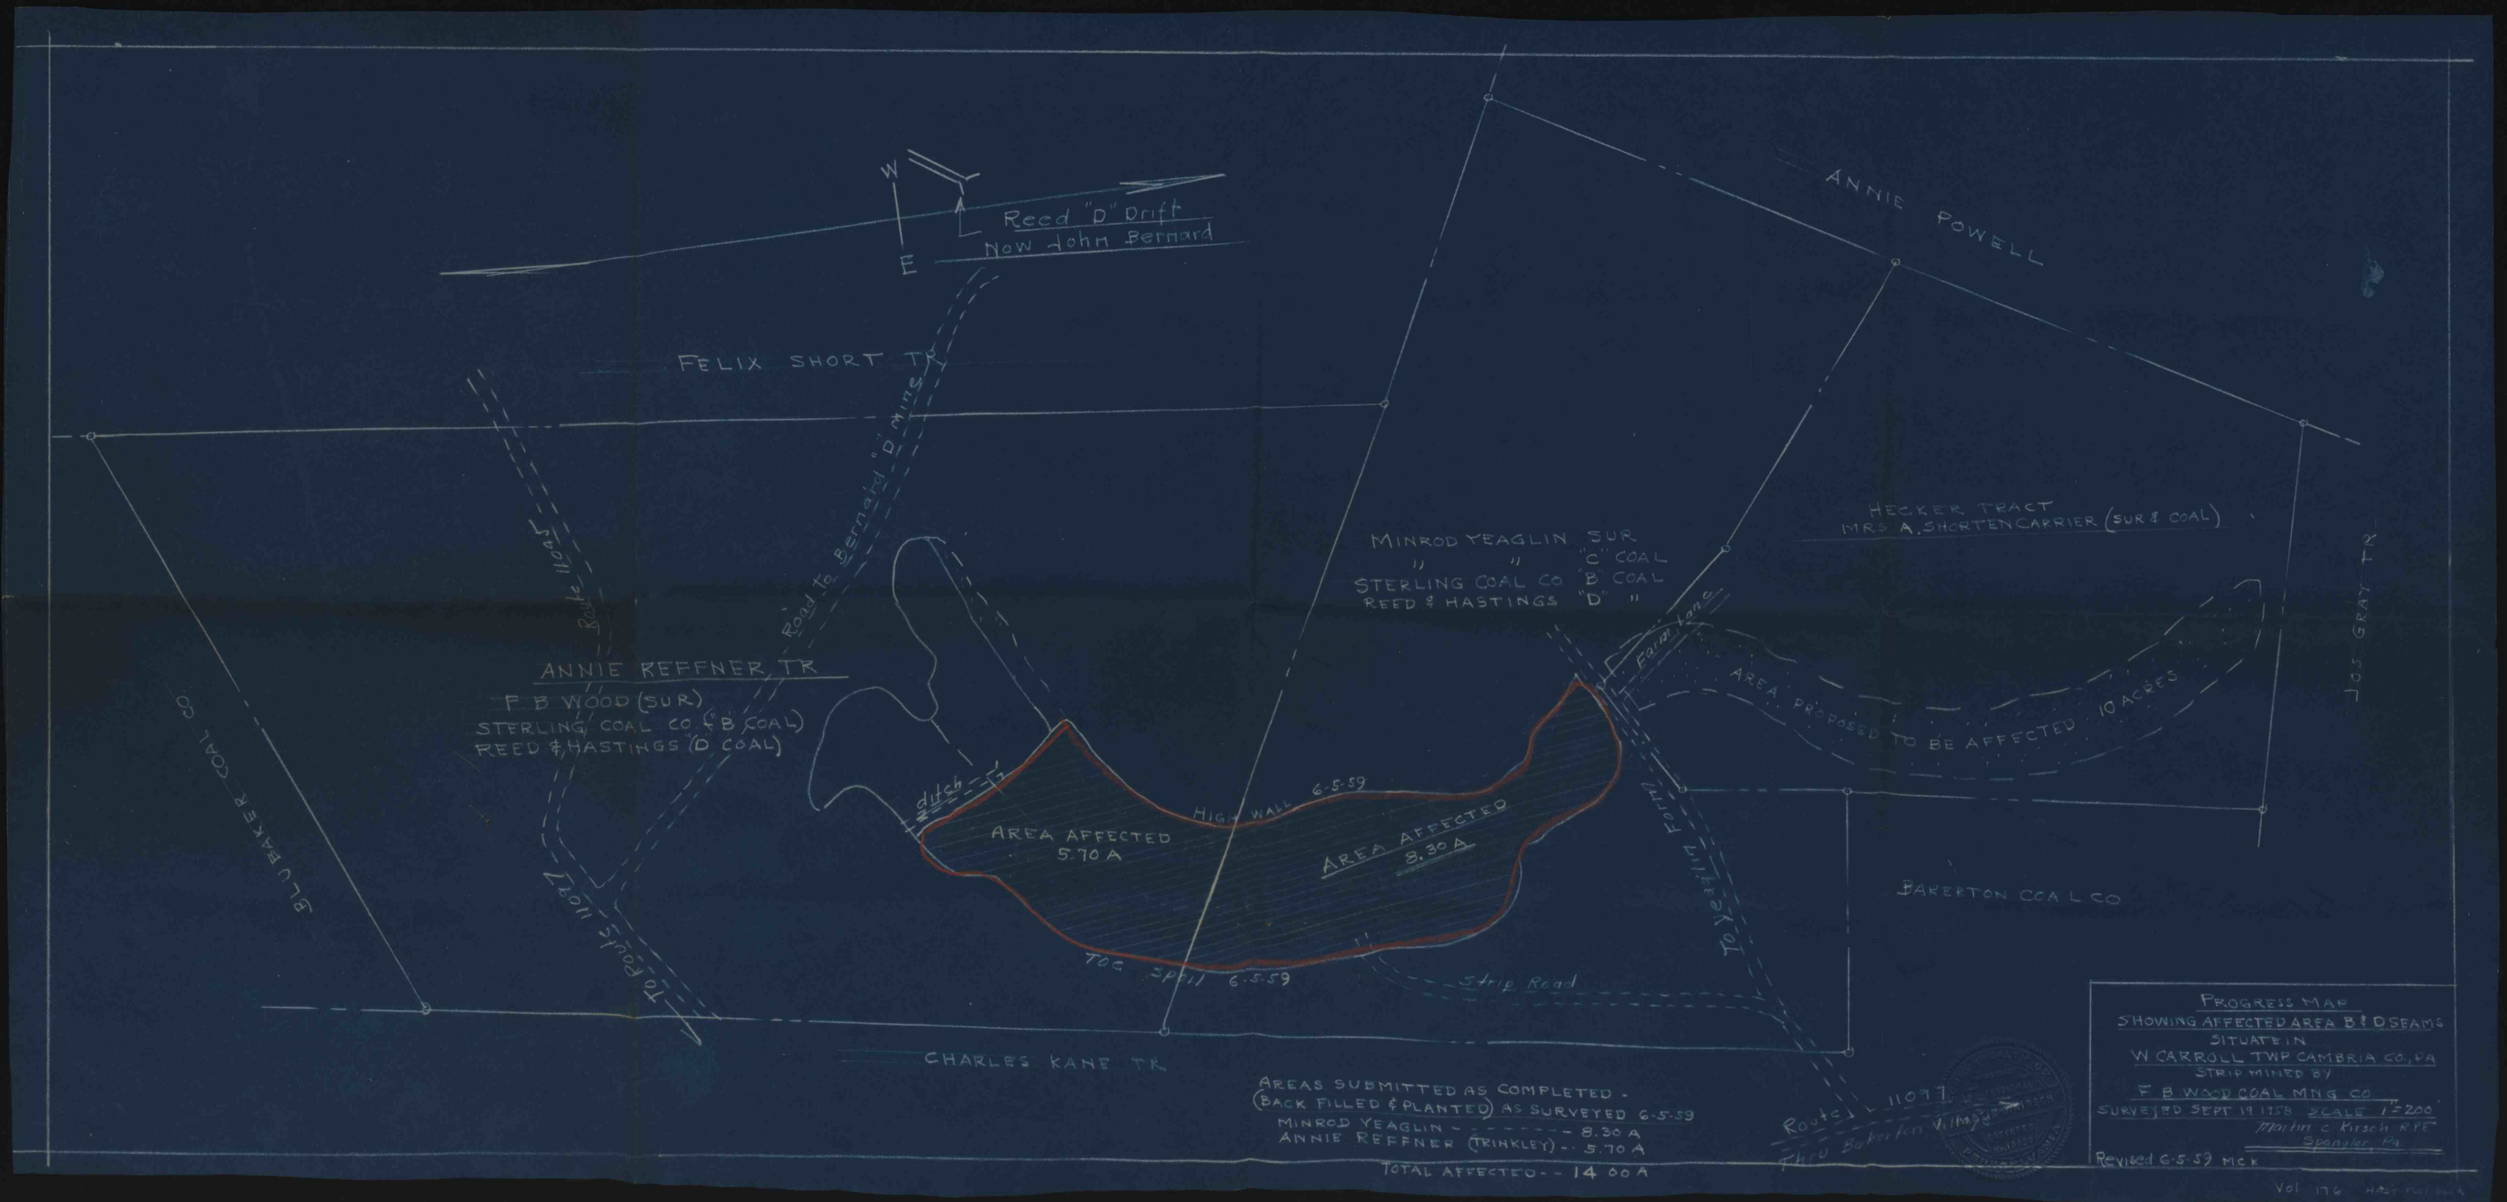
W
E
Reed "D" Drift
Now John Bernard
ANNIE POWELL
FELIX SHORT TR
Road to Bernard "D" mine
Road
To Pole Hill
ANNIE REFFNER TR
F B WOOD (SUR)
STERLING COAL CO ("B" COAL)
REED & HASTINGS "D" COAL)
BLUEAKER COAL CO
MINROD YEAGLIN SUR
" " "C" COAL
STERLING COAL CO "B" COAL
REED & HASTINGS "D" "
HECKER TRACT
MRS A. SHORTENCARRIER (SUR & COAL)
TO GRAT TR
Farm lane
AREA PROPOSED TO BE AFFECTED 10 ACRES
ditch
HIGH WALL 6-5-59
AREA AFFECTED
5.70 A
AREA AFFECTED
8.30 A
TOE SPOIL 6-5-59
Strip Road
Farm Lane
To Bilbeck
JAKERTON COAL CO
CHARLES KANE TR
Route 1 - 11097
Thru Bakerton Village
AREAS SUBMITTED AS COMPLETED -
(BACK FILLED & PLANTED) AS SURVEYED 6-5-59
MINROD YEAGLIN - - - - - - - - 8.30 A
ANNIE REFFNER (TRINKLEY) - - 5.70 A
TOTAL AFFECTED - - 14.00 A
PROGRESS MAP
SHOWING AFFECTED AREA B & D SEAMS
SITUATE IN
W CARROLL TWP CAMBRIA CO, PA
STRIP MINED BY
F B WOOD COAL MNG CO
SURVEYED SEPT 19 1958 SCALE 1" = 200'
Martin C Kirsch RPE
Spangler, Pa
Revised 6-5-59 MCK
Vol 176