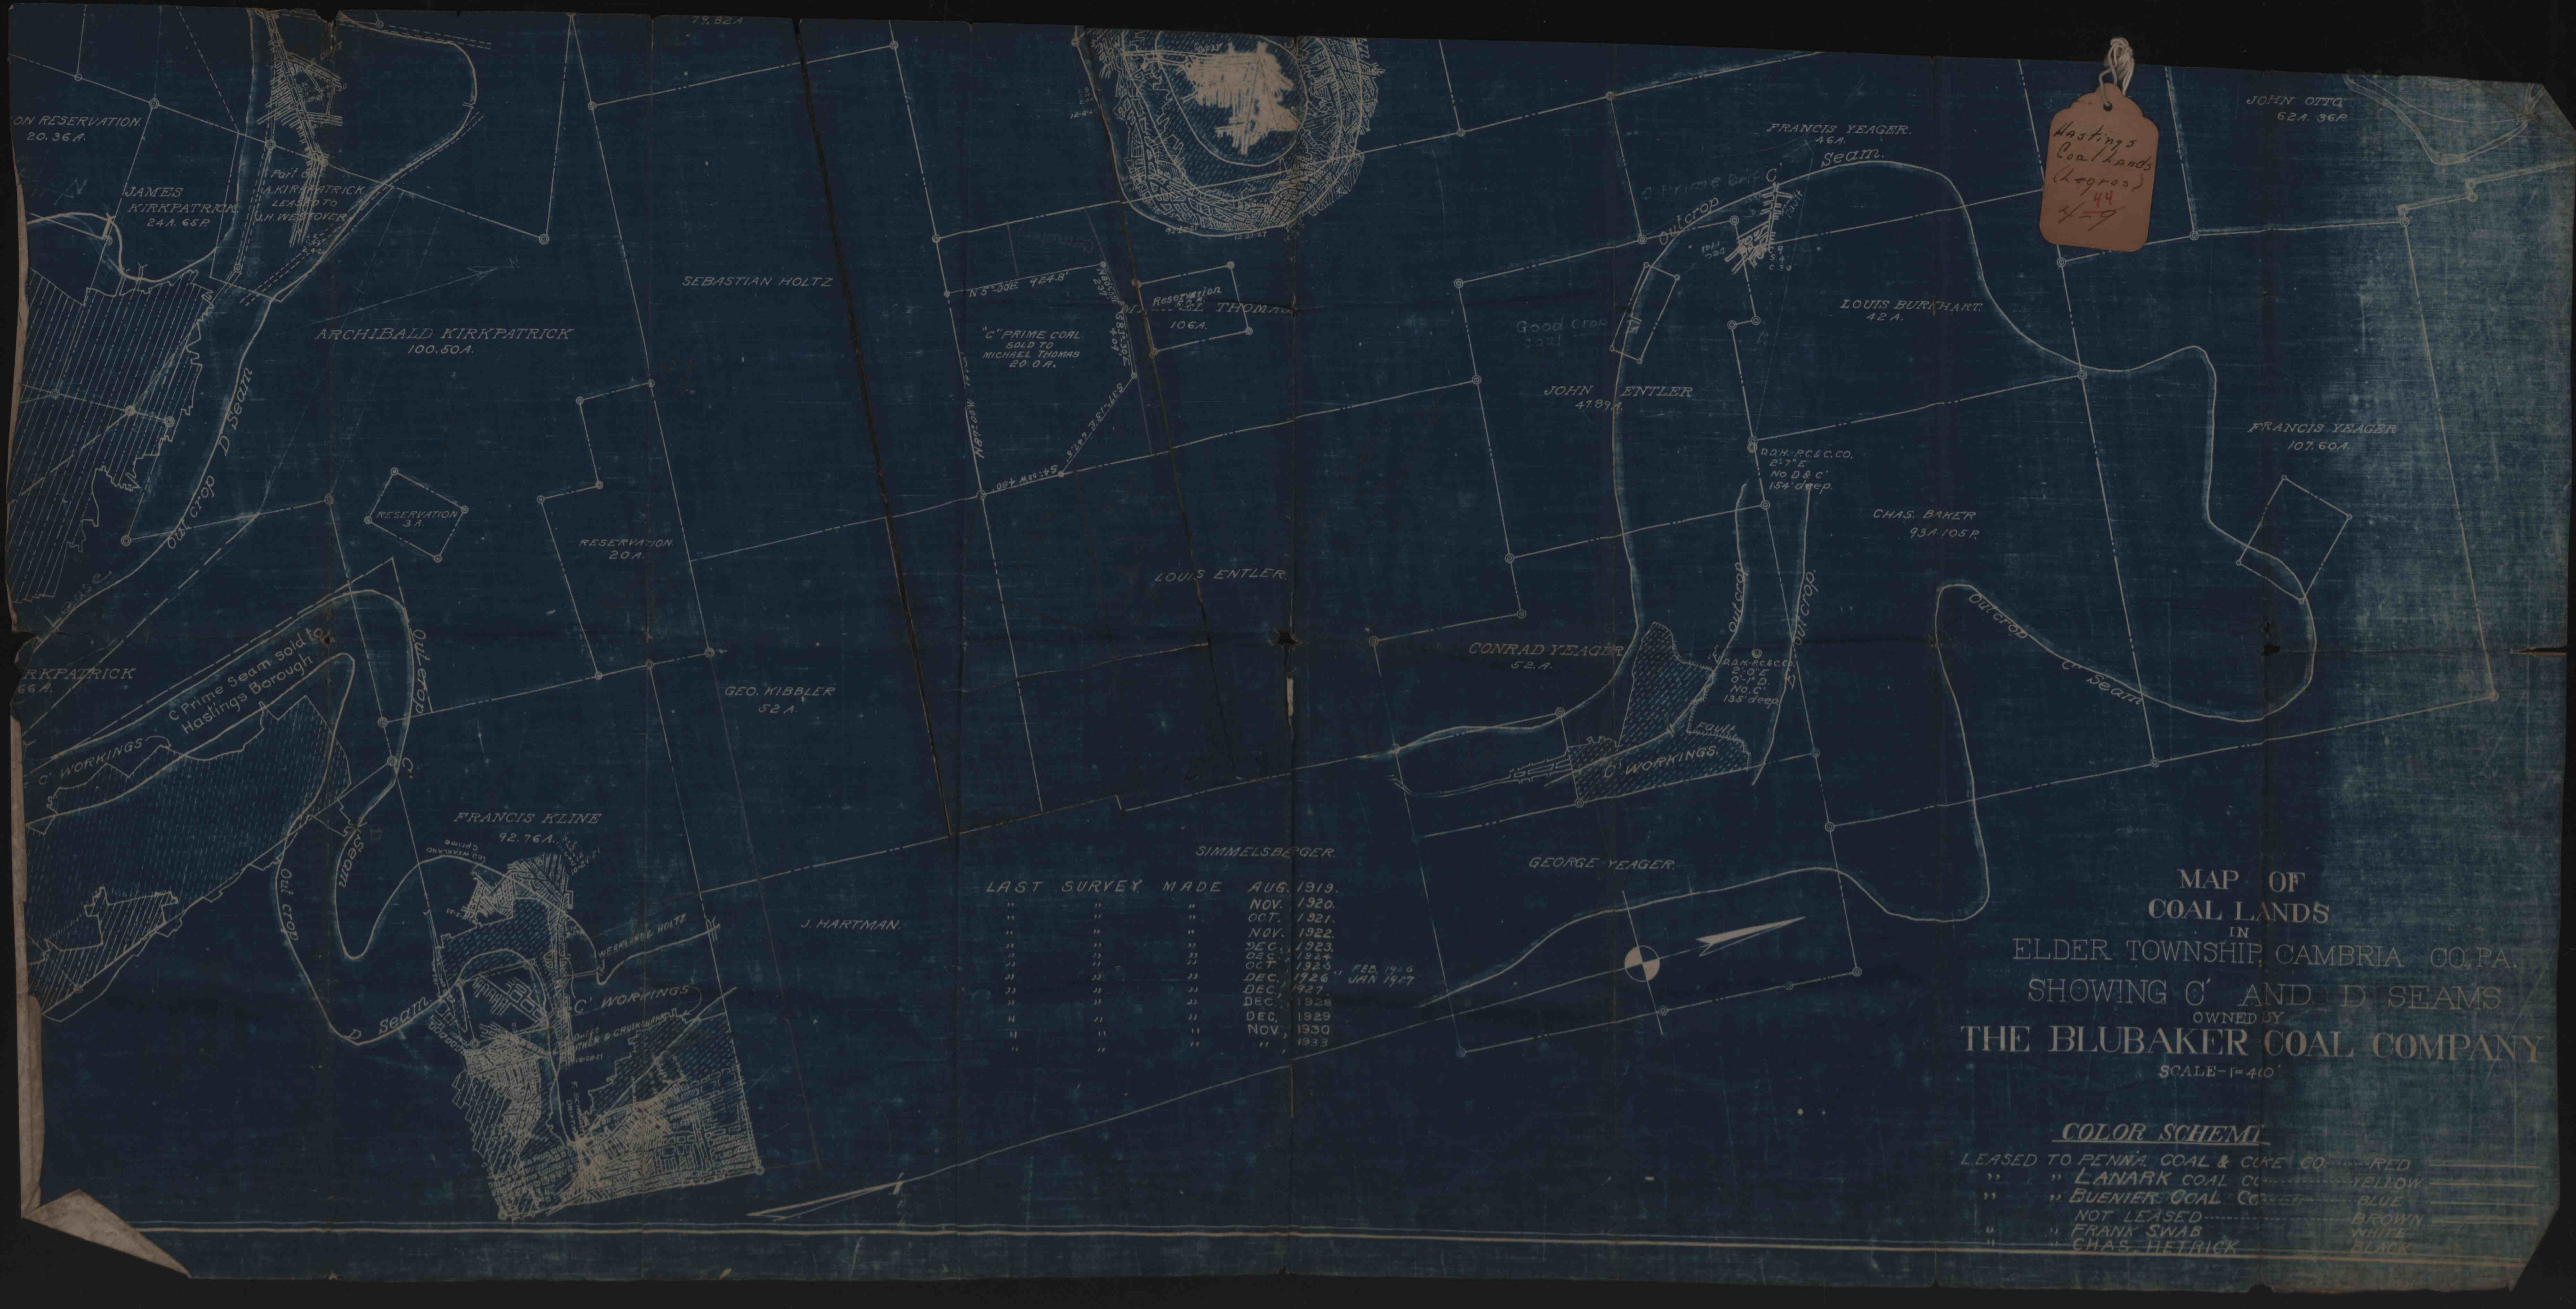

Hastings
Coal Lands
(Legros)
44
4-9

LAST SURVEY MADE AUG. 1919.
" " " NOV. 1920.
" " " OCT. 1921.
" " " NOV. 1922.
" " " DEC. 1923.
" " " DEC. 1924
" " " OCT. 1925, FEB. 1926
" " " DEC. 1926, JAN 1927
" " " DEC. 1927.
" " " DEC. 1928
" " " DEC. 1929
" " " NOV. 1930
" " " ", 1933

MAP OF
COAL LANDS
IN
ELDER TOWNSHIP, CAMBRIA CO., PA.
SHOWING C' AND D SEAMS
OWNED BY
THE BLUBAKER COAL COMPANY
SCALE-1"=400'

COLOR SCHEME

LEASED TO PENNA. COAL & COKE CO. .... RED
" " LANARK COAL CO. .... YELLOW
" " BUENIER COAL CO. .... BLUE
NOT LEASED .... BROWN
" " FRANK SWAB .... WHITE
" " CHAS. HETRICK .... BLACK