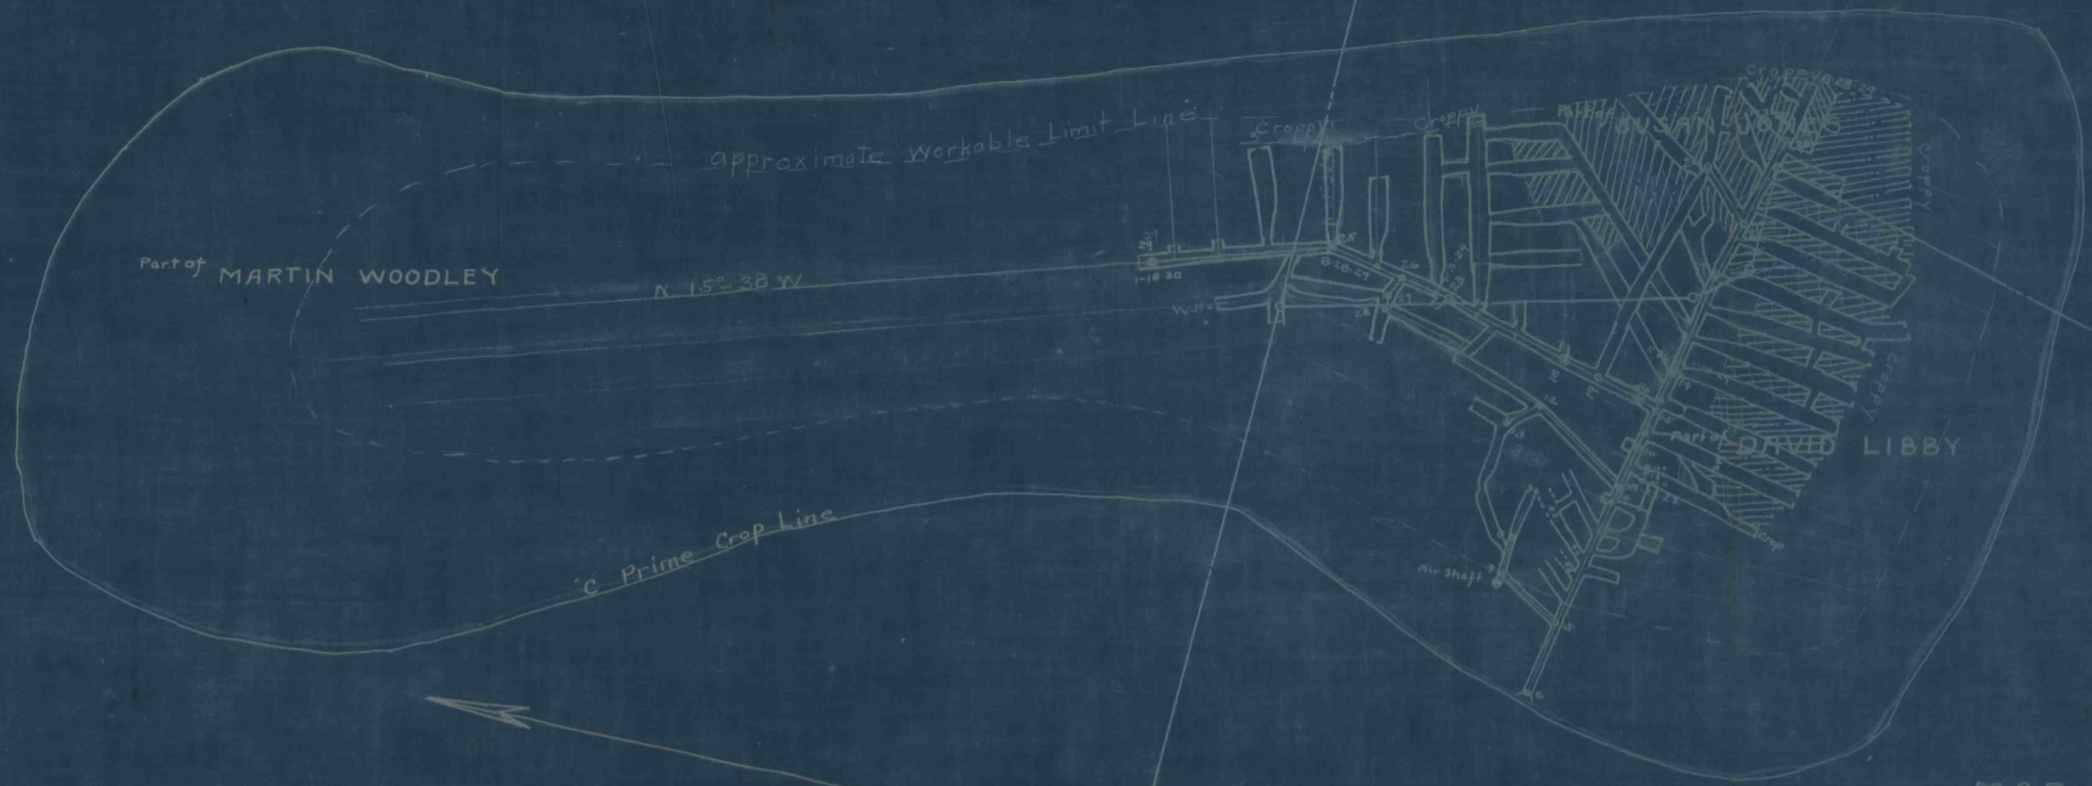
approximate Workable Limit Line
Part of MARTIN WOODLEY
N 15° 38 W
"C" Prime Crop Line
Croppings
Croppings
Croppings